

314.

31.

5 cm

Cross section of Main Hoize from 800 ft. level


New Pinapore Gold Mining Company the Liability

Scale 25 ft. to an inch

Looking East

No 6. Level

800 feet. level

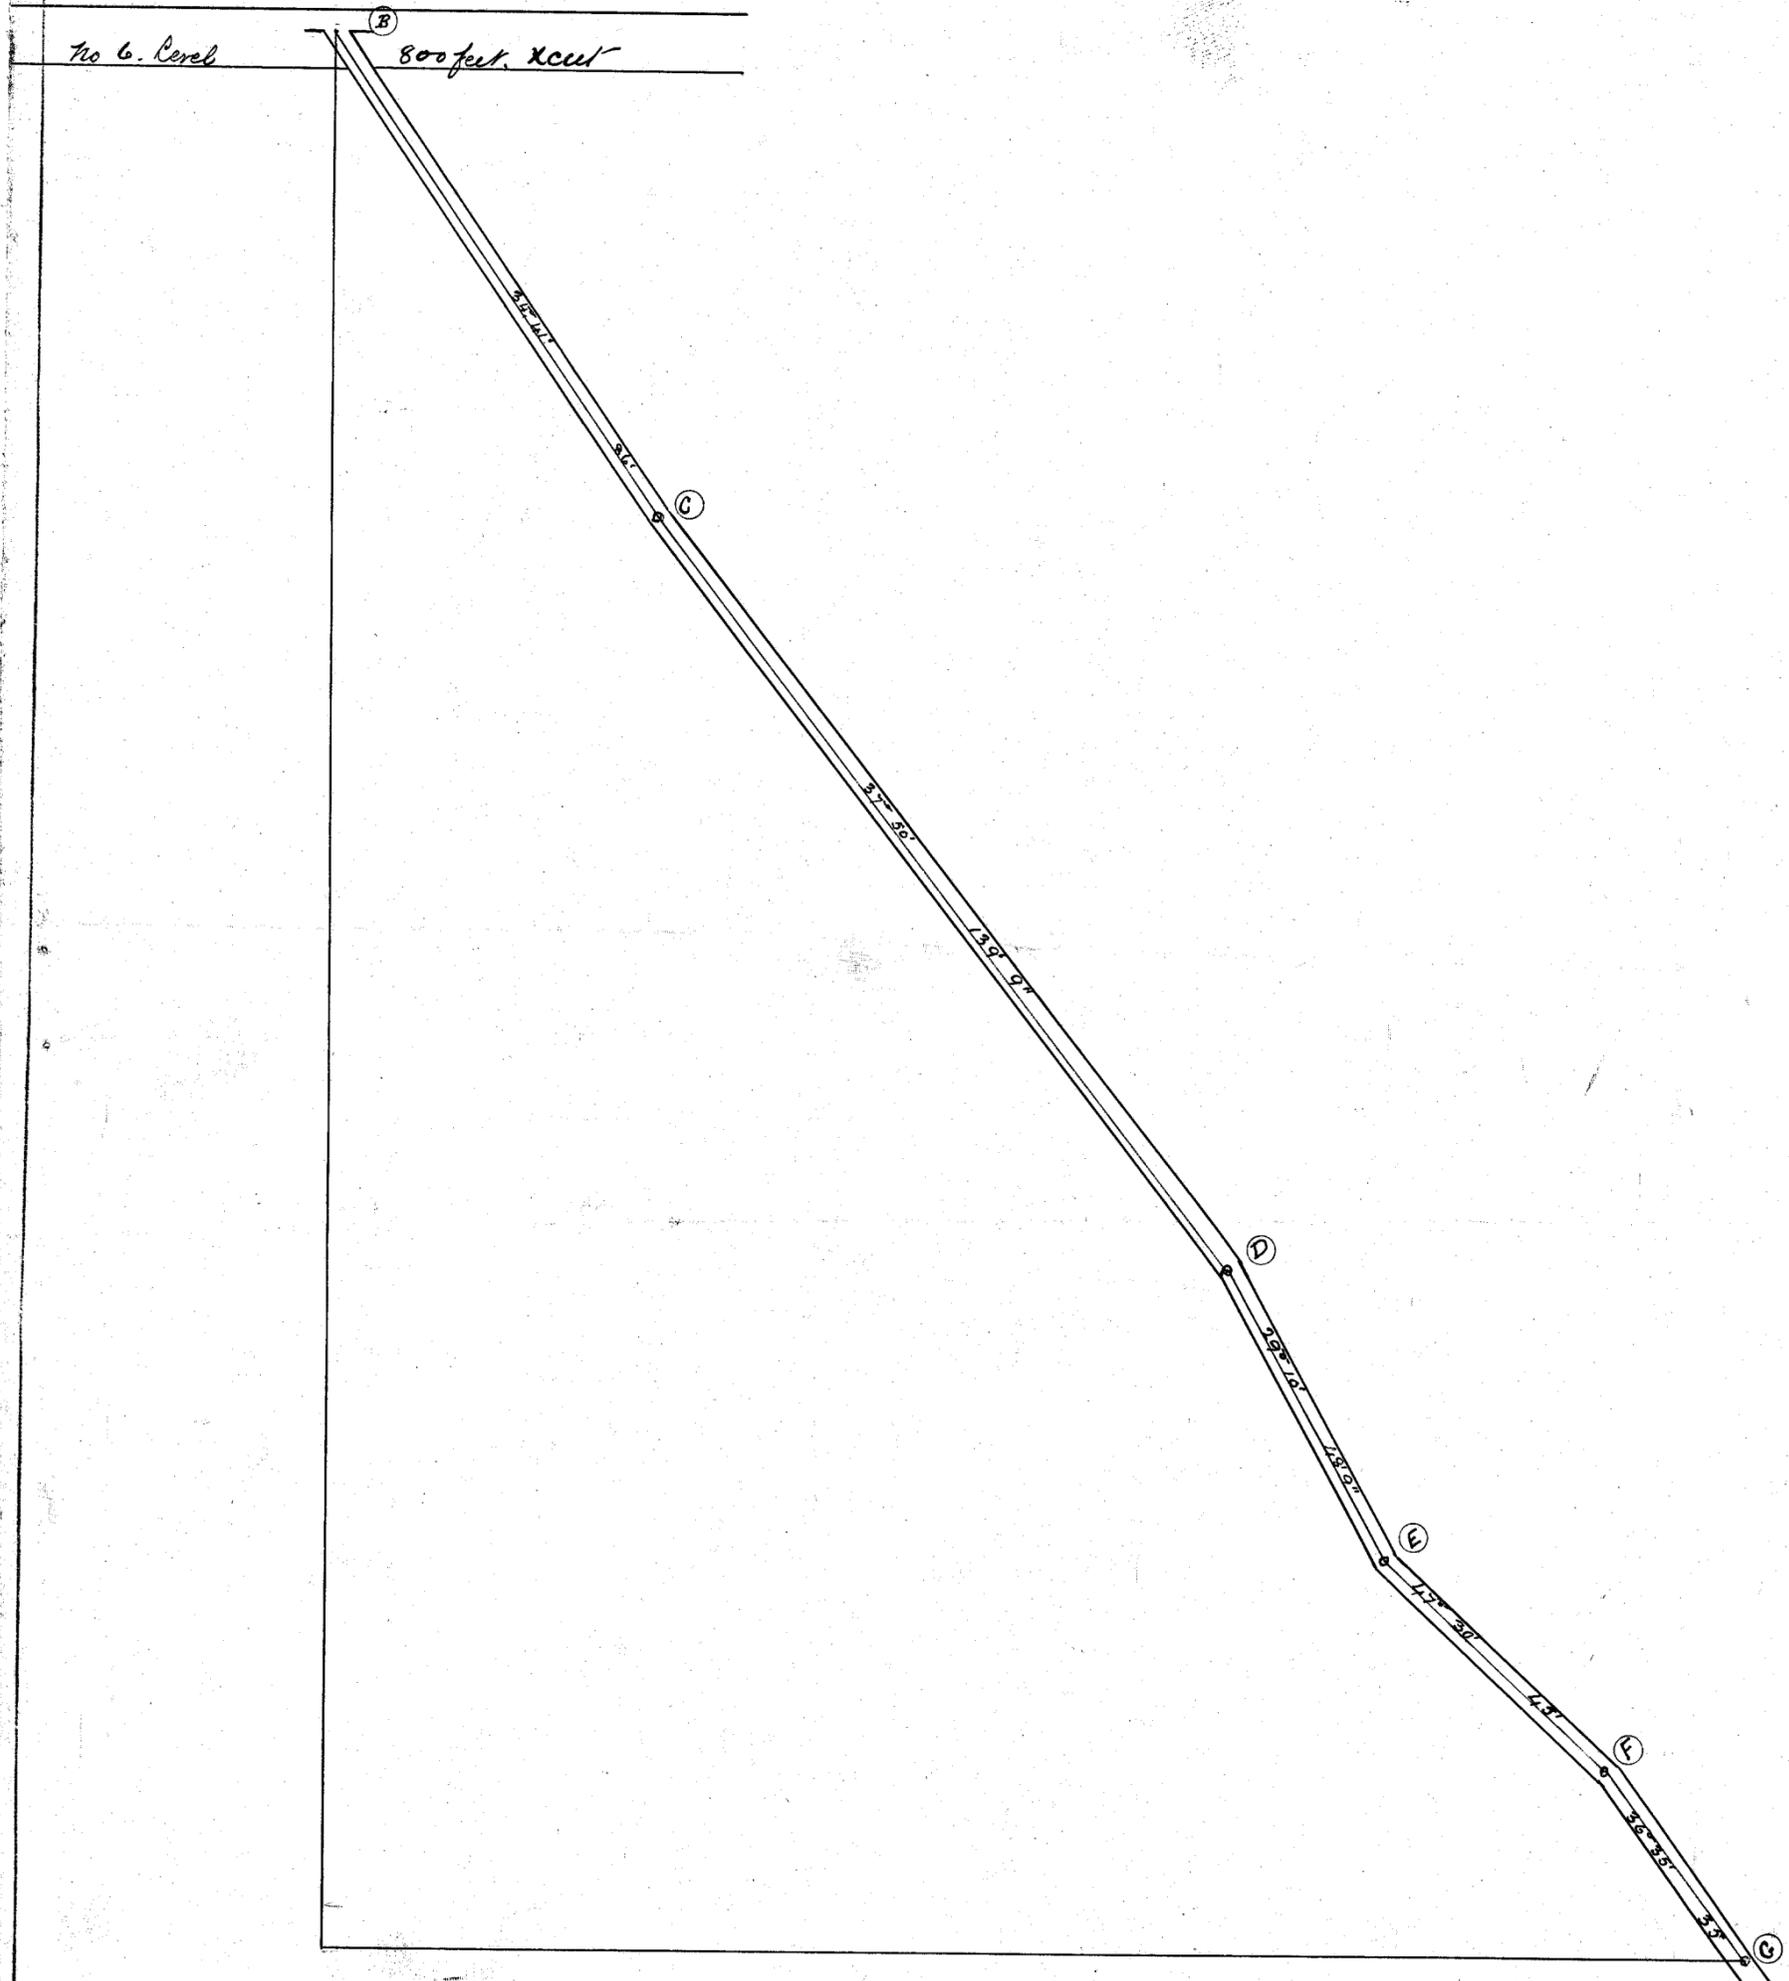

275  
792

Instrument used Transit theodolite

J. J. Smith

Gen. Mine Manager

24/1/98

58