


85

5 cm

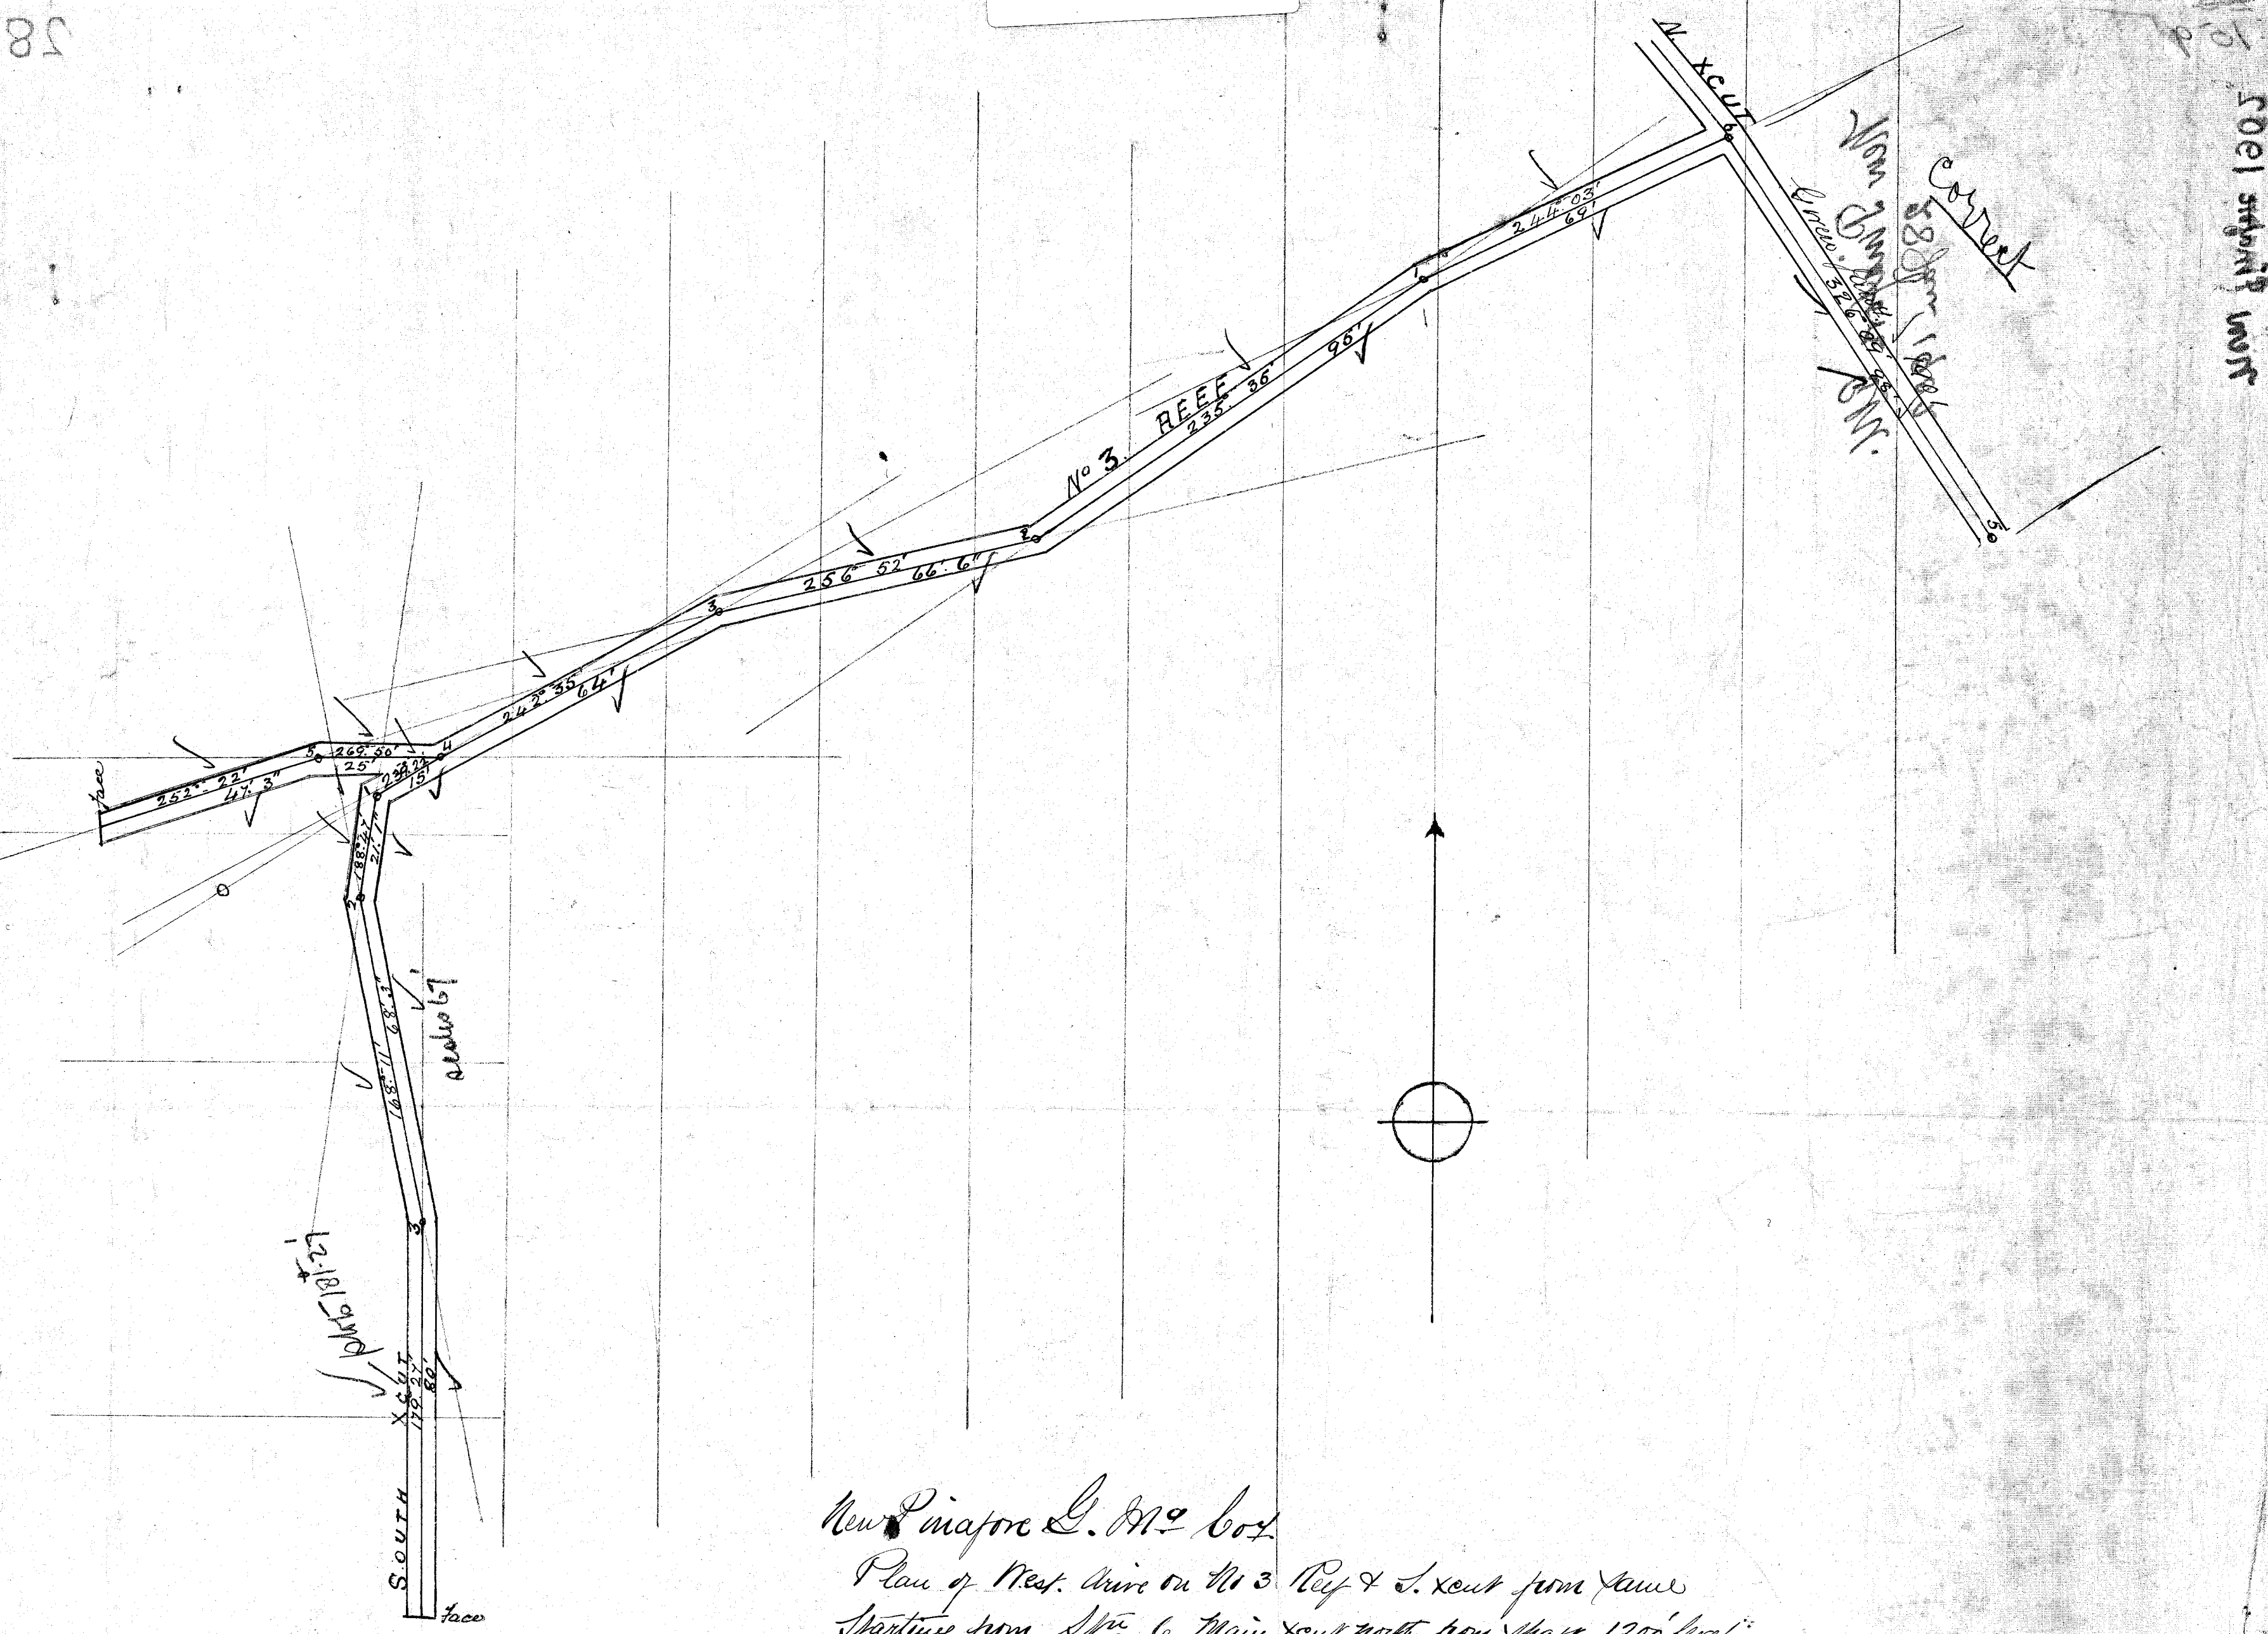

New Pinapore G. M. Co.

Plan of West. Mine on No 3 Reef & S. Shaft from same
Starting from Shaft 6 Main Shaft north from Shaft 1200' level
Scale 25 feet to one inch

Instrument used. Transit theodolite

J. J. Smith
Gen. Mine Manager
24 Jan. 1902



58

58