


58.

5 cm

New Pinafore C.M.

Longitudinal Section

58

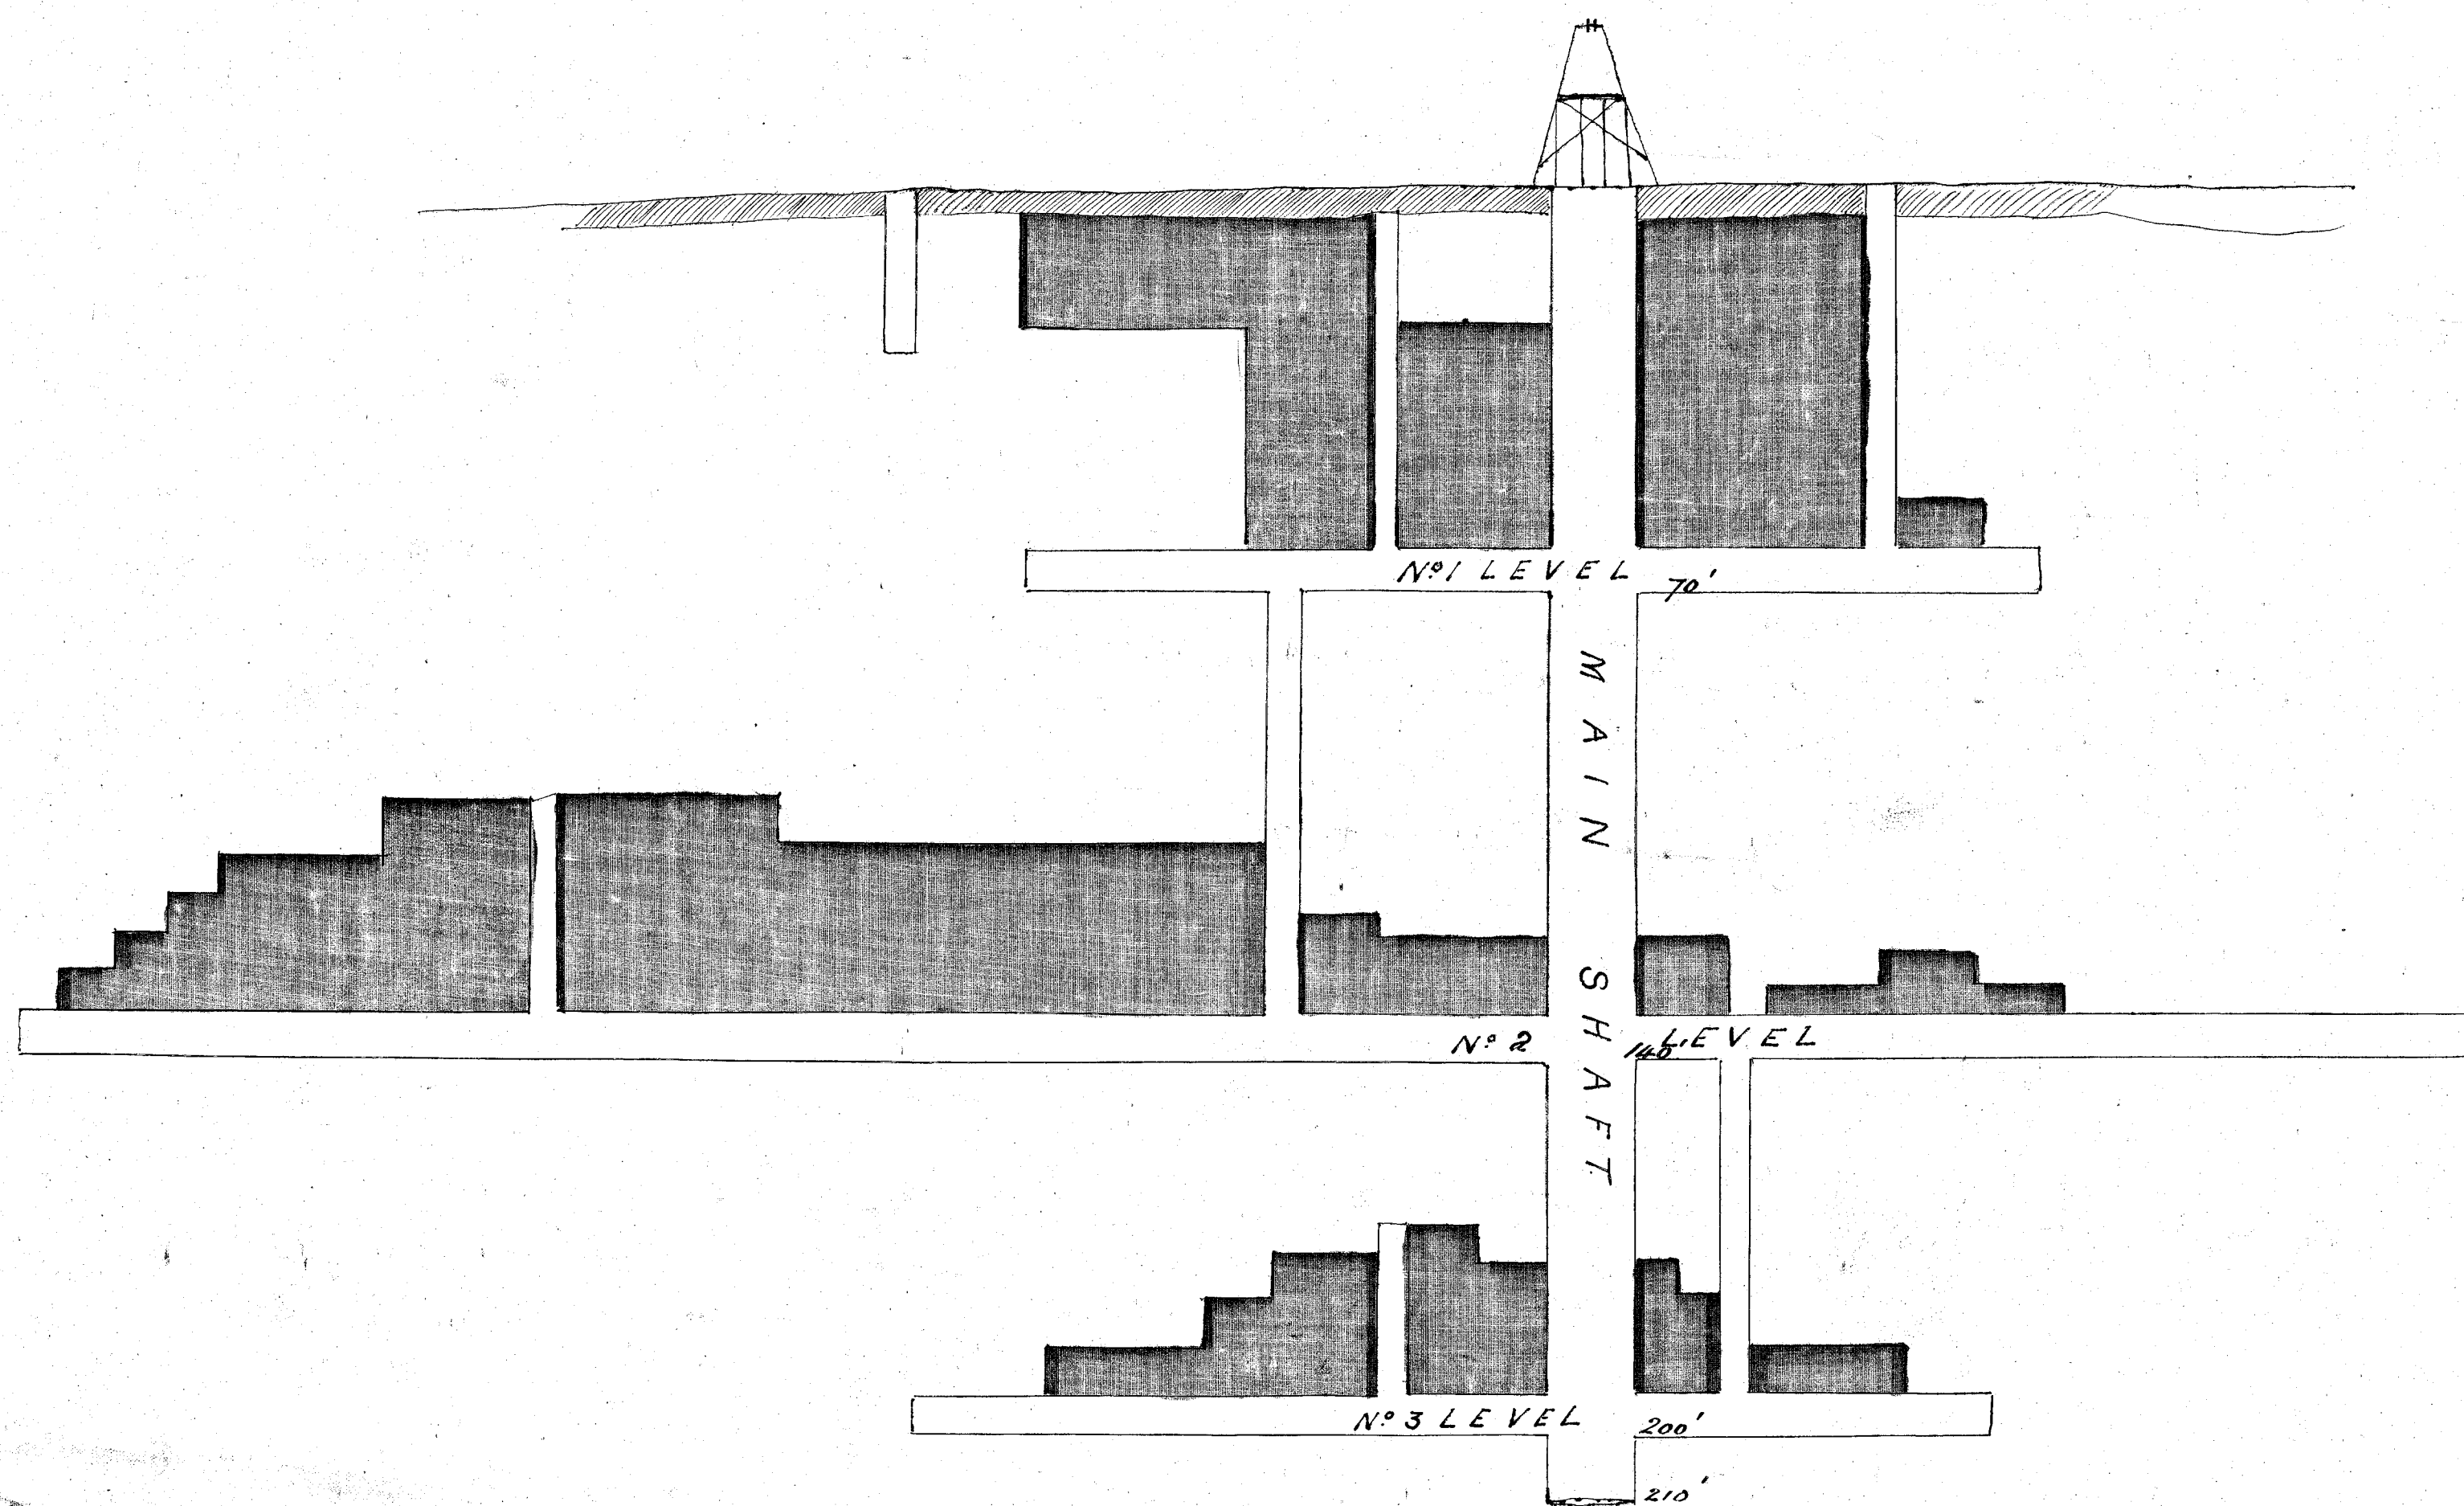

9th July 1895
LONDON

Certified correct copy of plan in
Manager's office to end of year 1891
C. Bingley W. A. Chown
Auth. Surveyor
13/1/92

real copy of plan 1891