


retraced
1881 not

5 cm

West Volunteer P.A.
Plan of workings from Jan. 1st to Dec. 31st 1896
The bearing lines of 1896 workings are bounded on both sides
Scale - one inch = 25 feet
J.M. Potter, Mine Manager

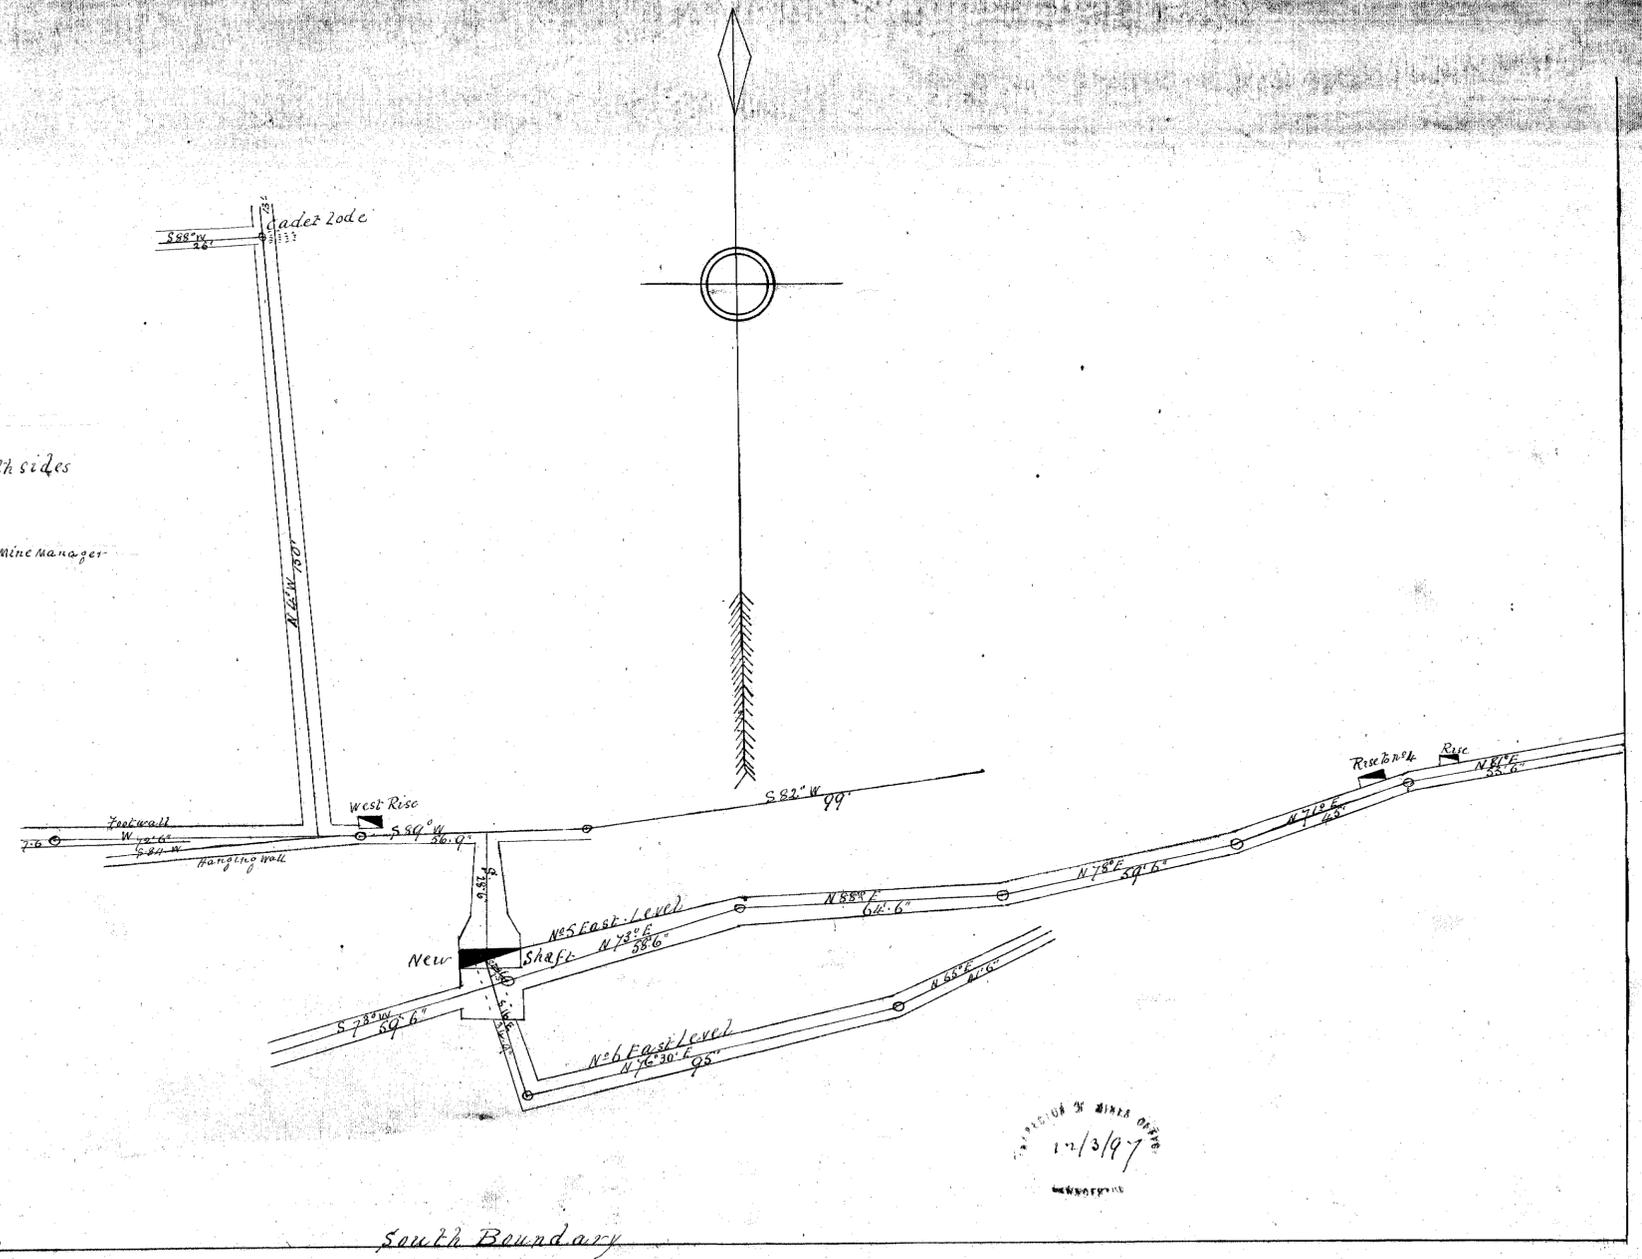

315
02

45