


EAST PINAFORE G M C^o N L

4 7 11
3 2 11




Ground Plan

Scale 25 feet to an inch

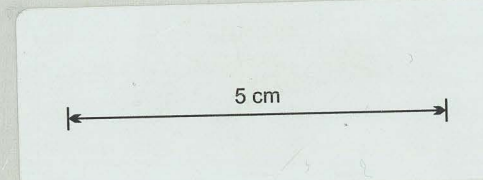

Longitudinal Section

Cross Section

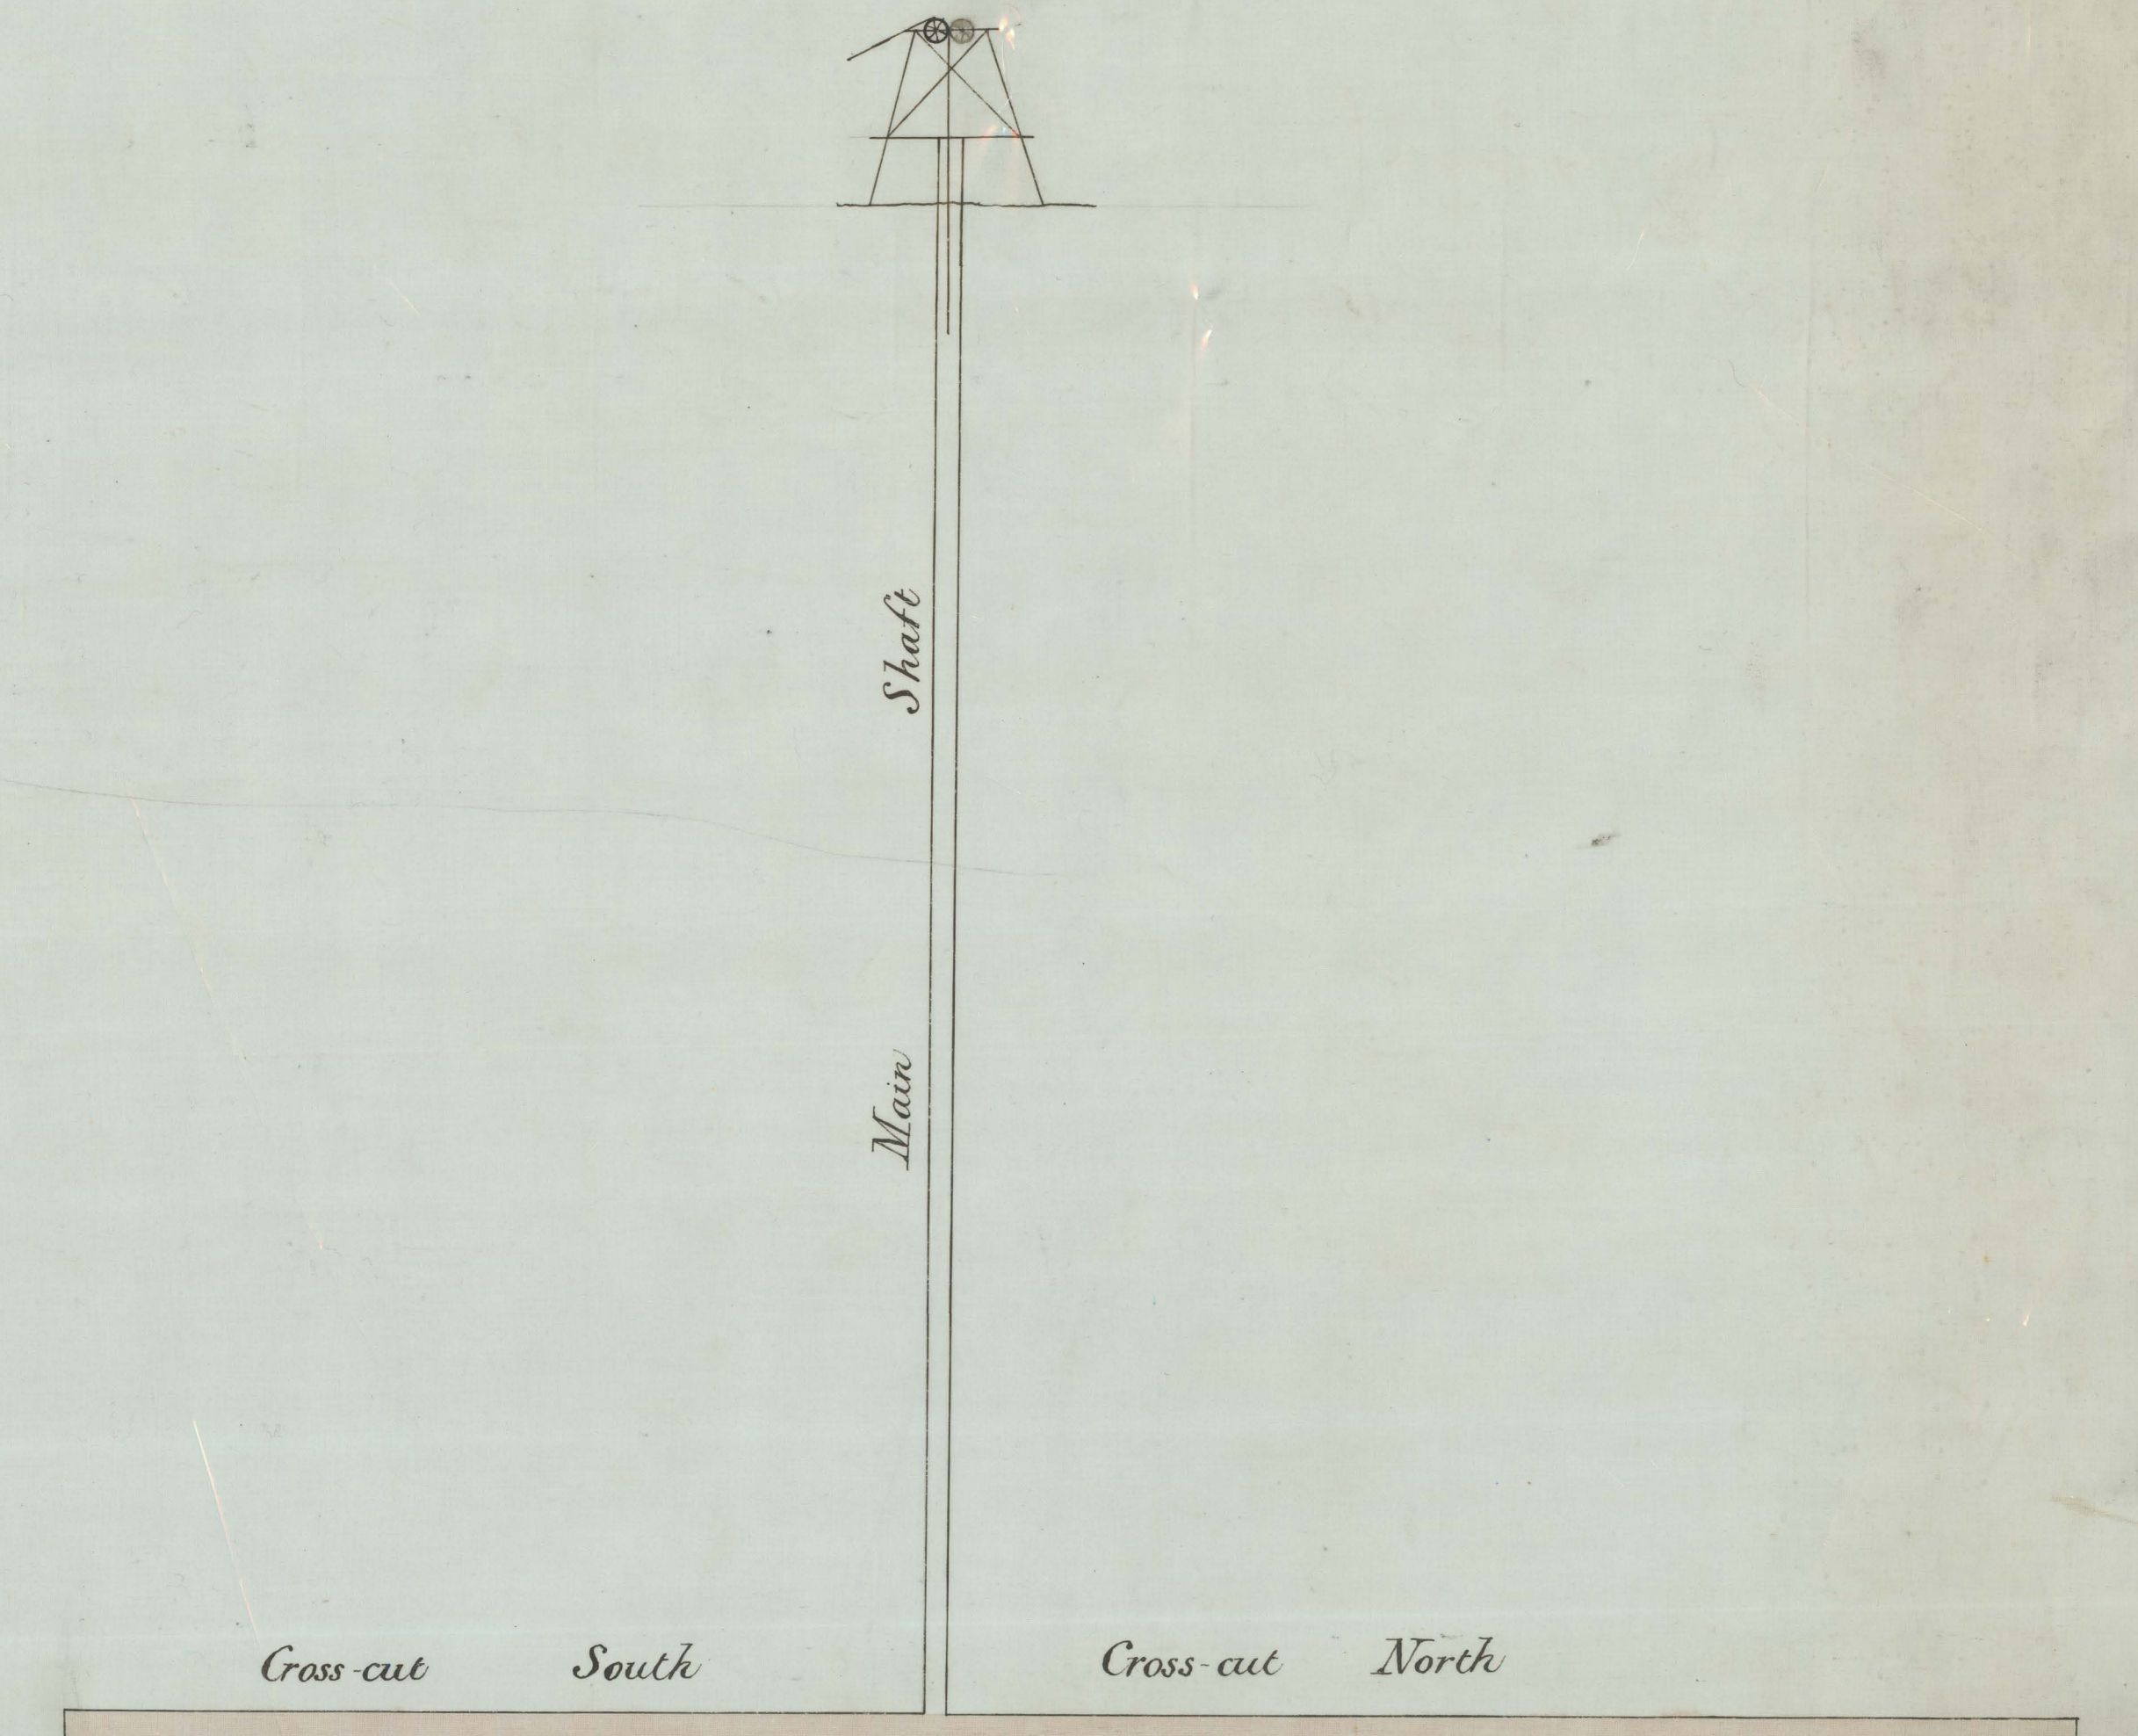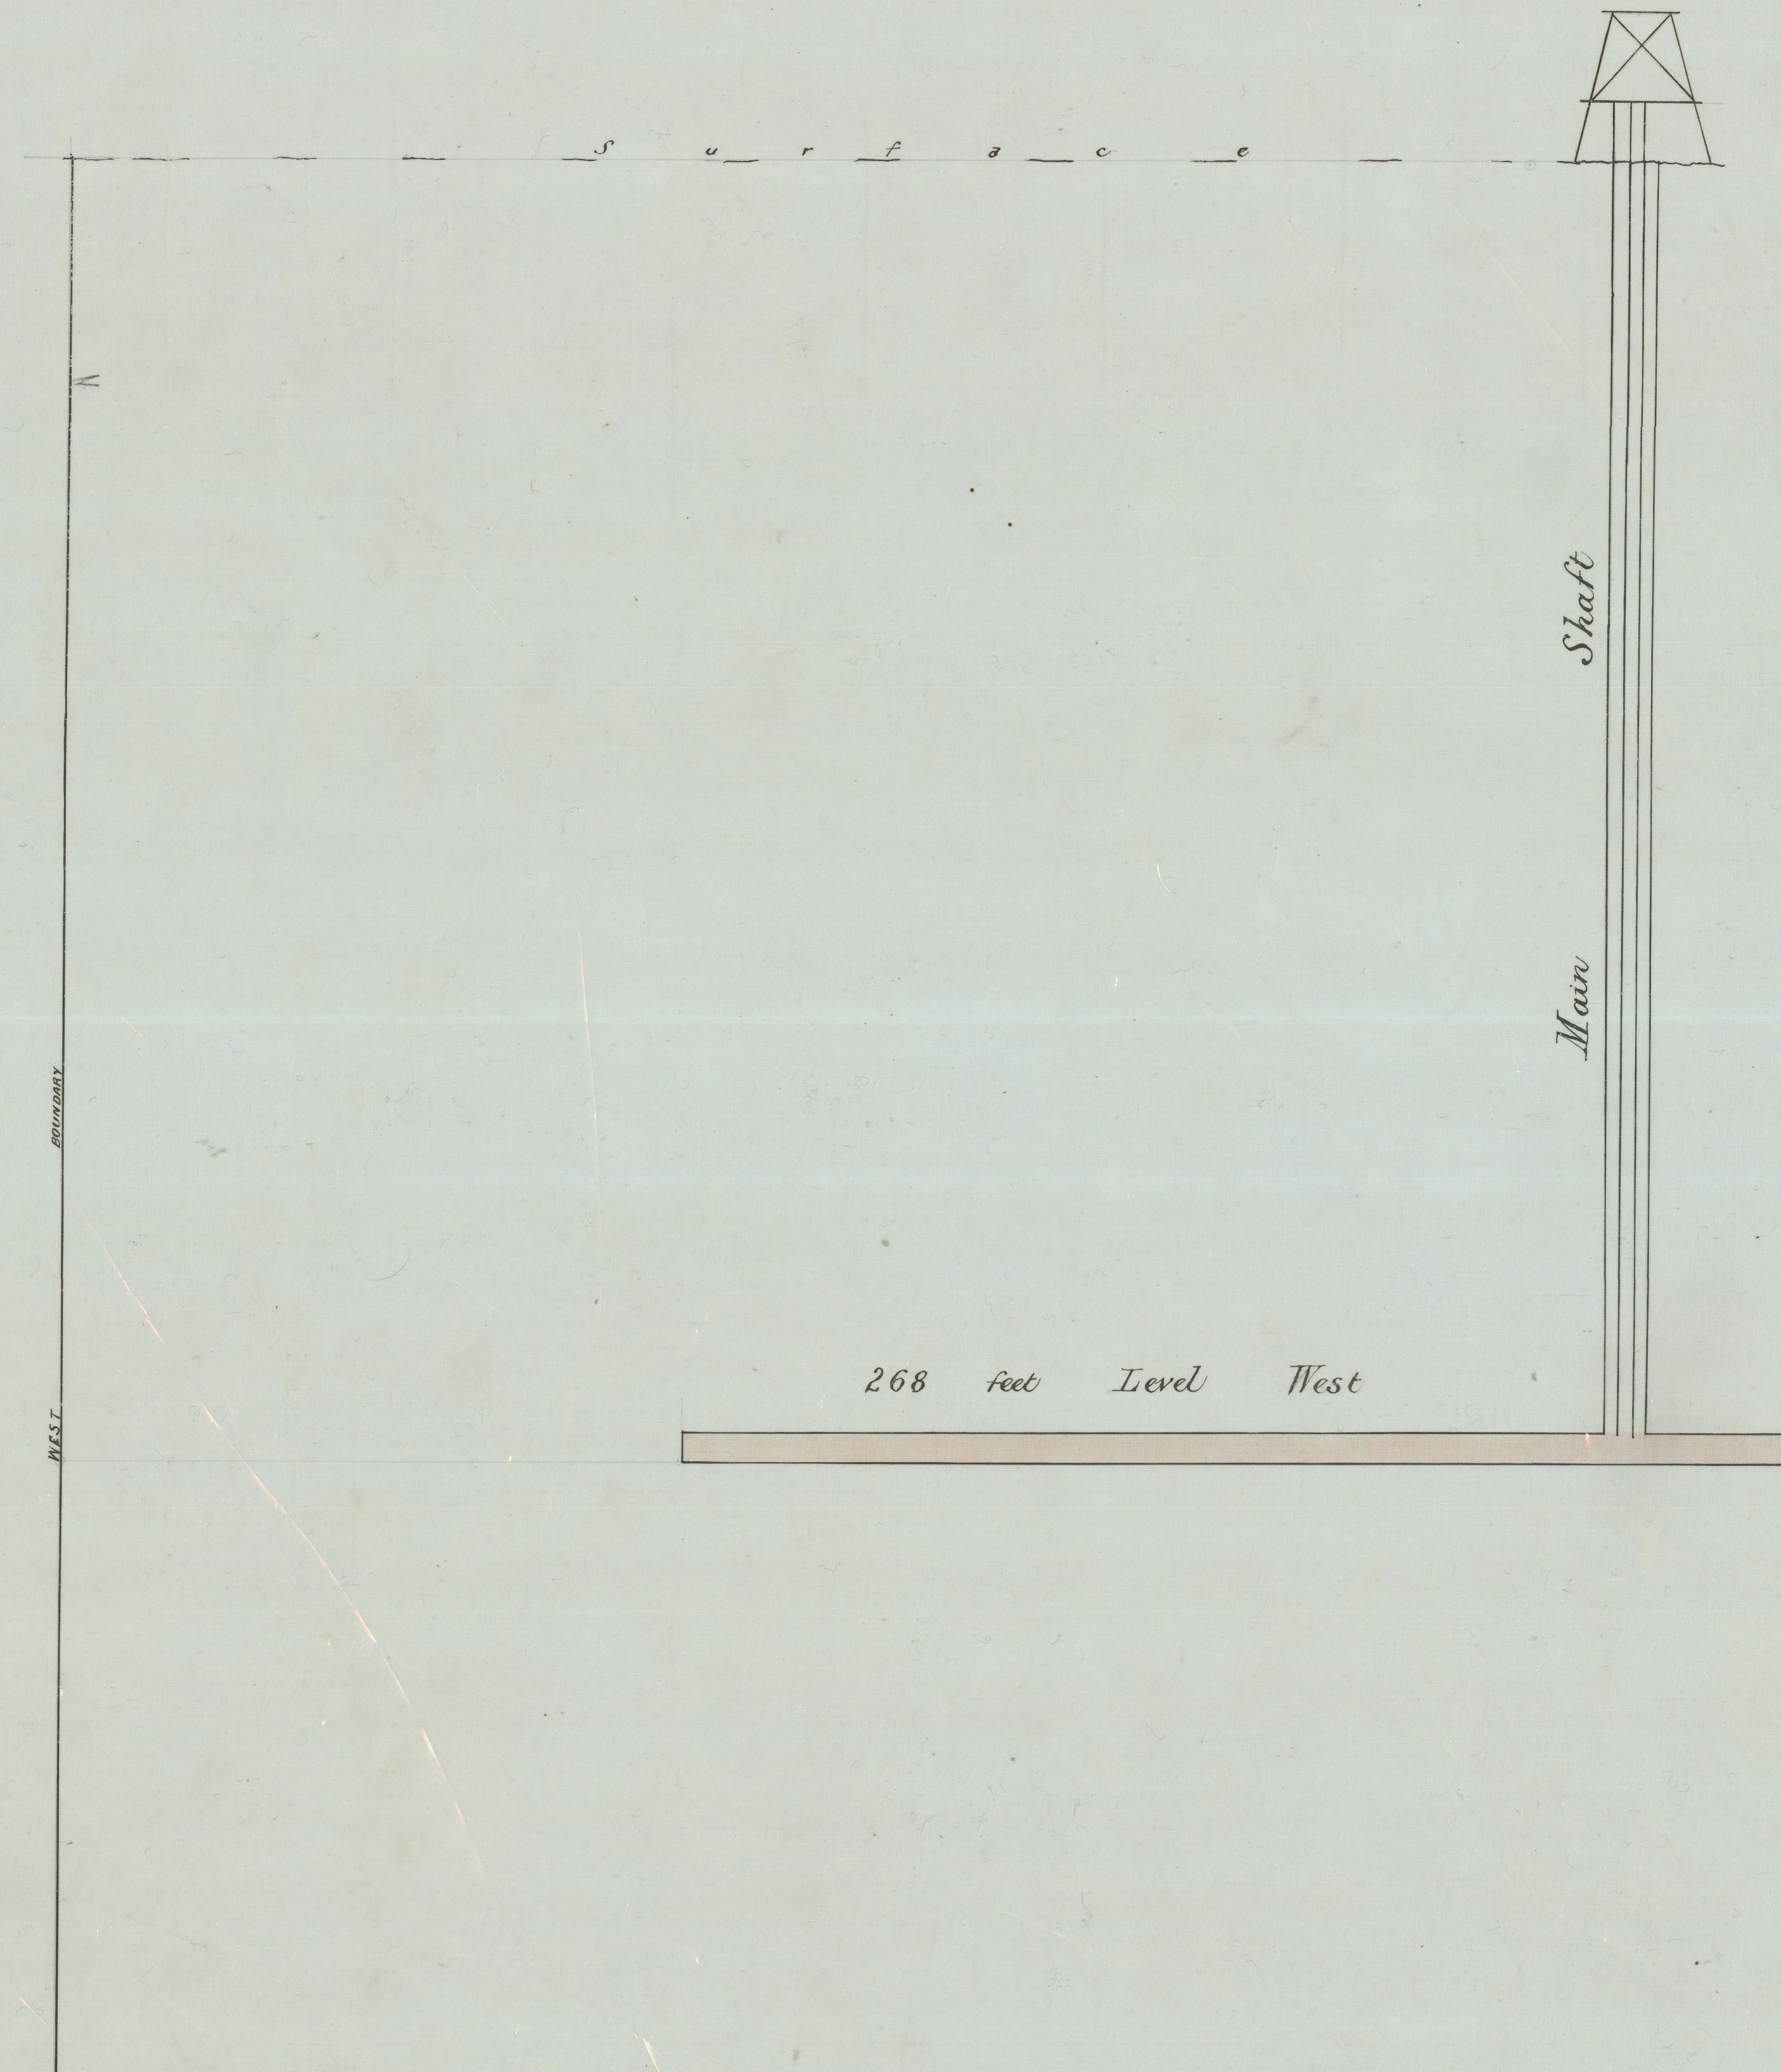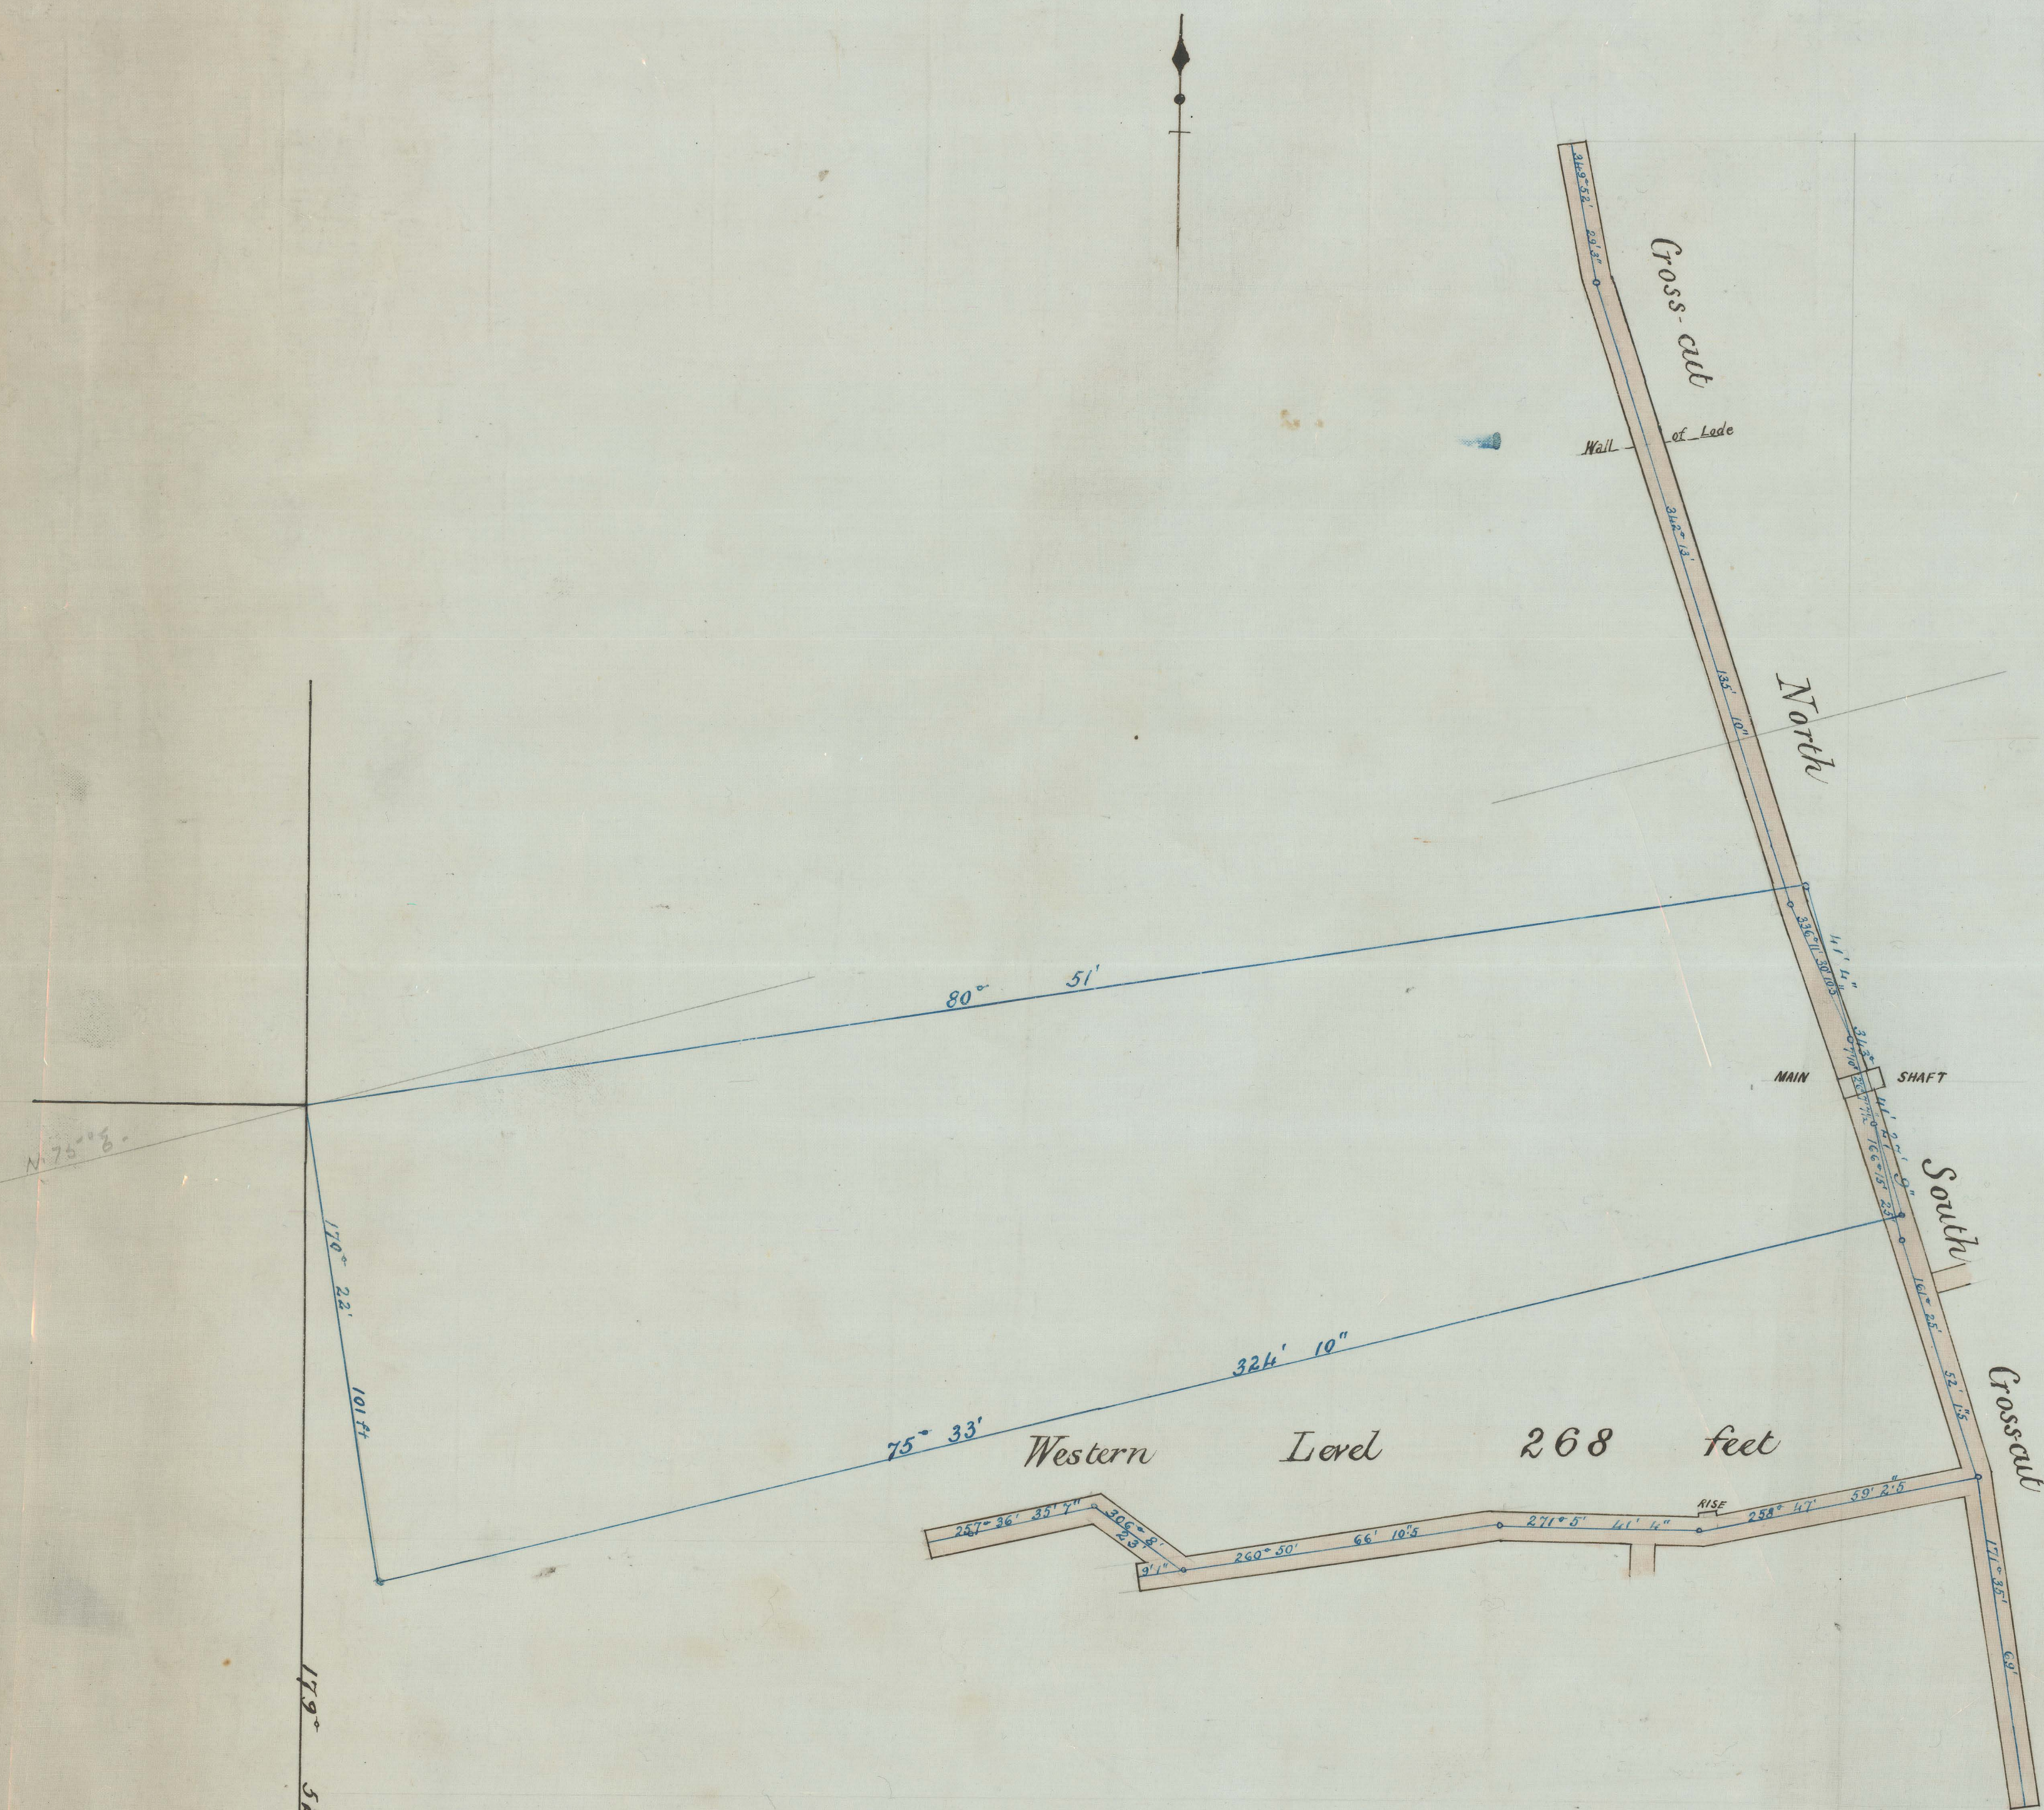

Correct copy of Plan of Underground workings
to 30th March 1895

H. J. Miles
Authorised Surveyor
2/11/95