

4
2008/10/17

37
04

64


East Pinafore G. M Co NO LIA

Lefroy

Scale 25 feet to an inch



WEST BOUNDARY

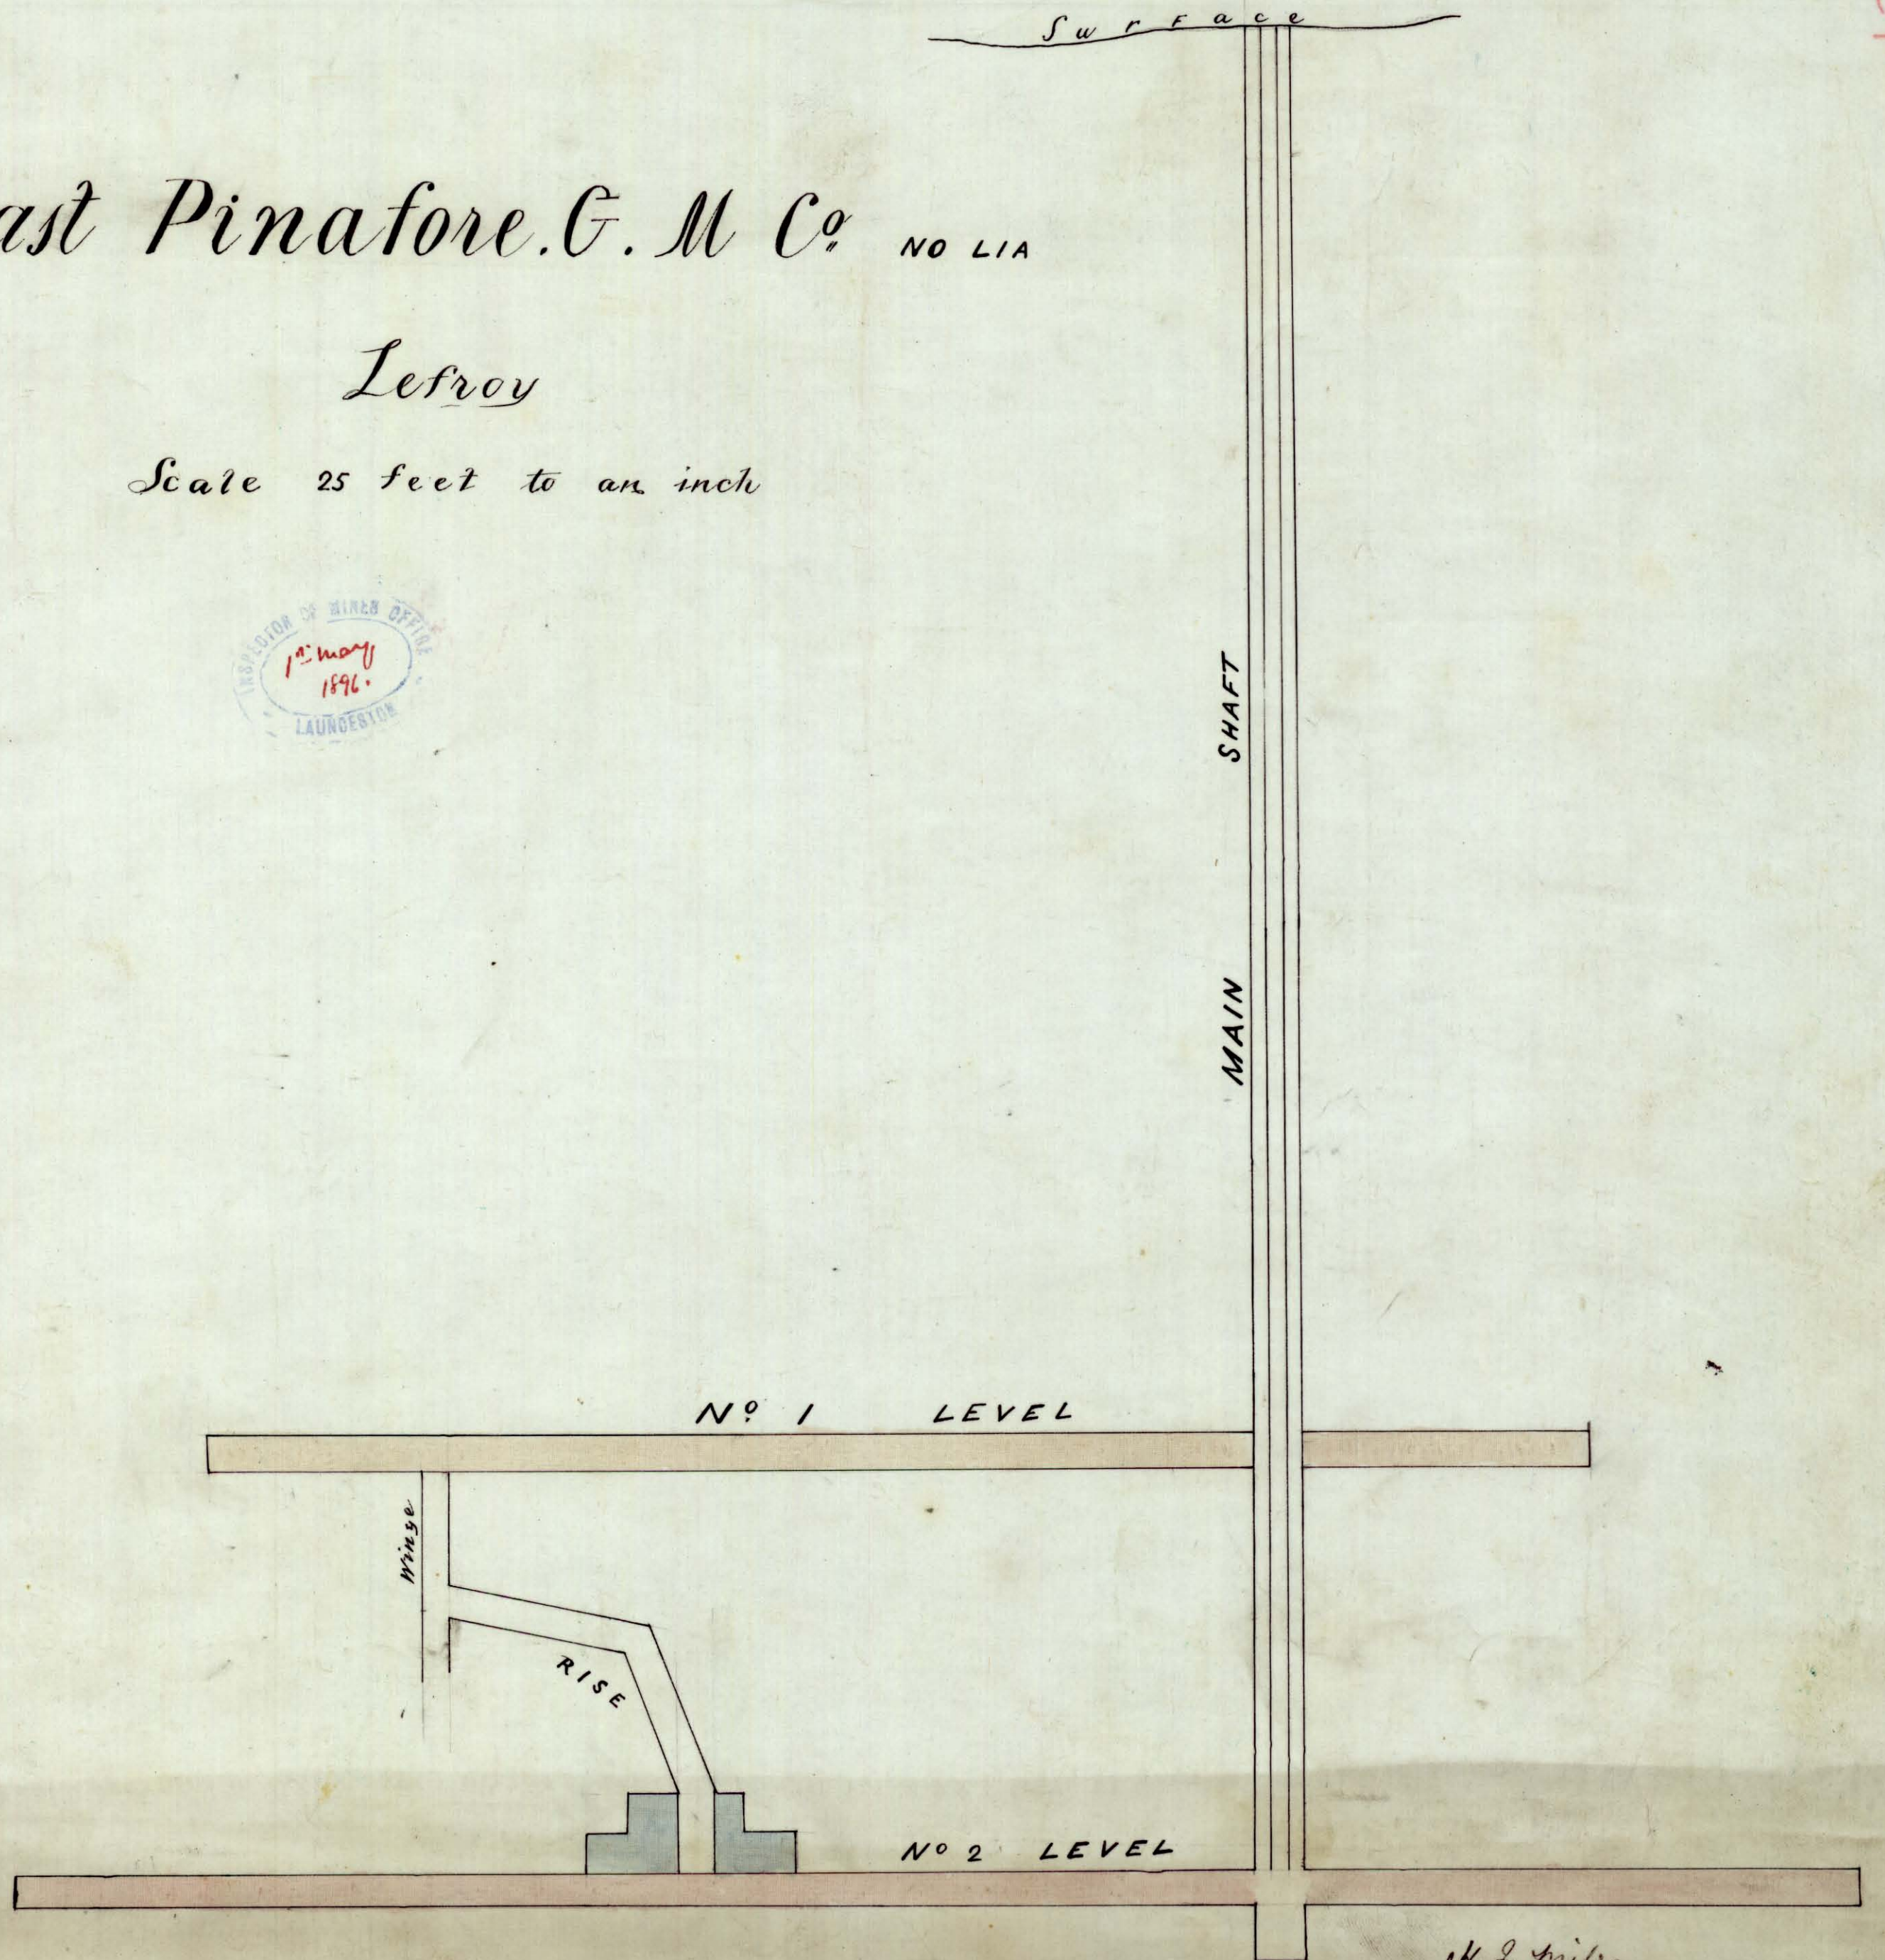

W. J. Miles
Authorized Surveyor
Lefroy
Jan'y 1896

64