


# WEST VOLUNTEER GOLD MINE PLAN OF DRIVES

Scale - 25 ft to an inch -

Note. Meas<sup>ts</sup> in links  
4" Y Theodolite used

To 3<sup>rd</sup> Jan 1895

*G. S. Edzie*  
23/1/95

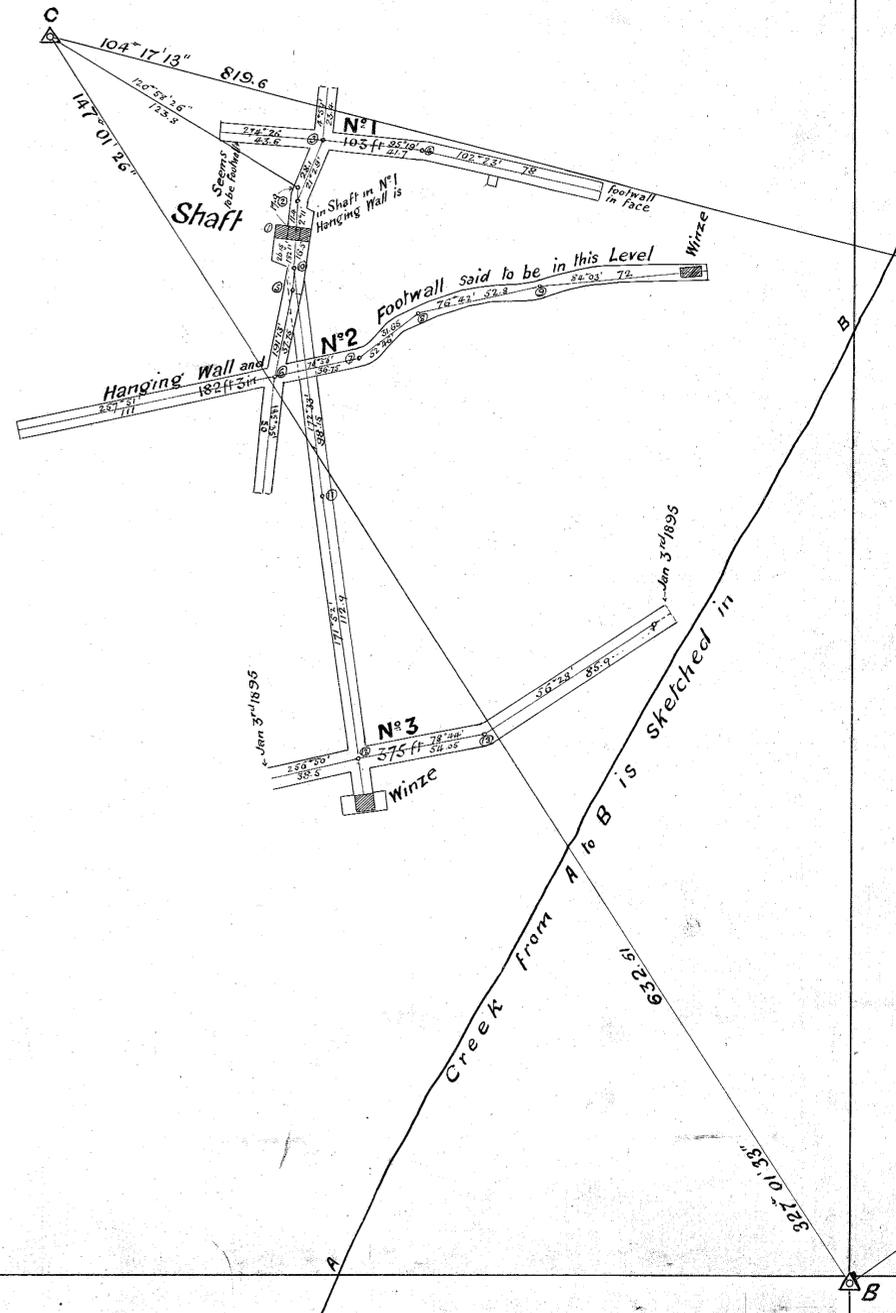

Jan 1895  
Edzie