


RECEIVED BY MINES
25 March
1896
LAUNCESTON

WEST VOLUNTEER GOLD MINE LONGITUDINAL SECTION


Scale - 25ft to an inch

To 3rd Jan 1896

Geoffrey Eadie
District Surveyor
23/1/96

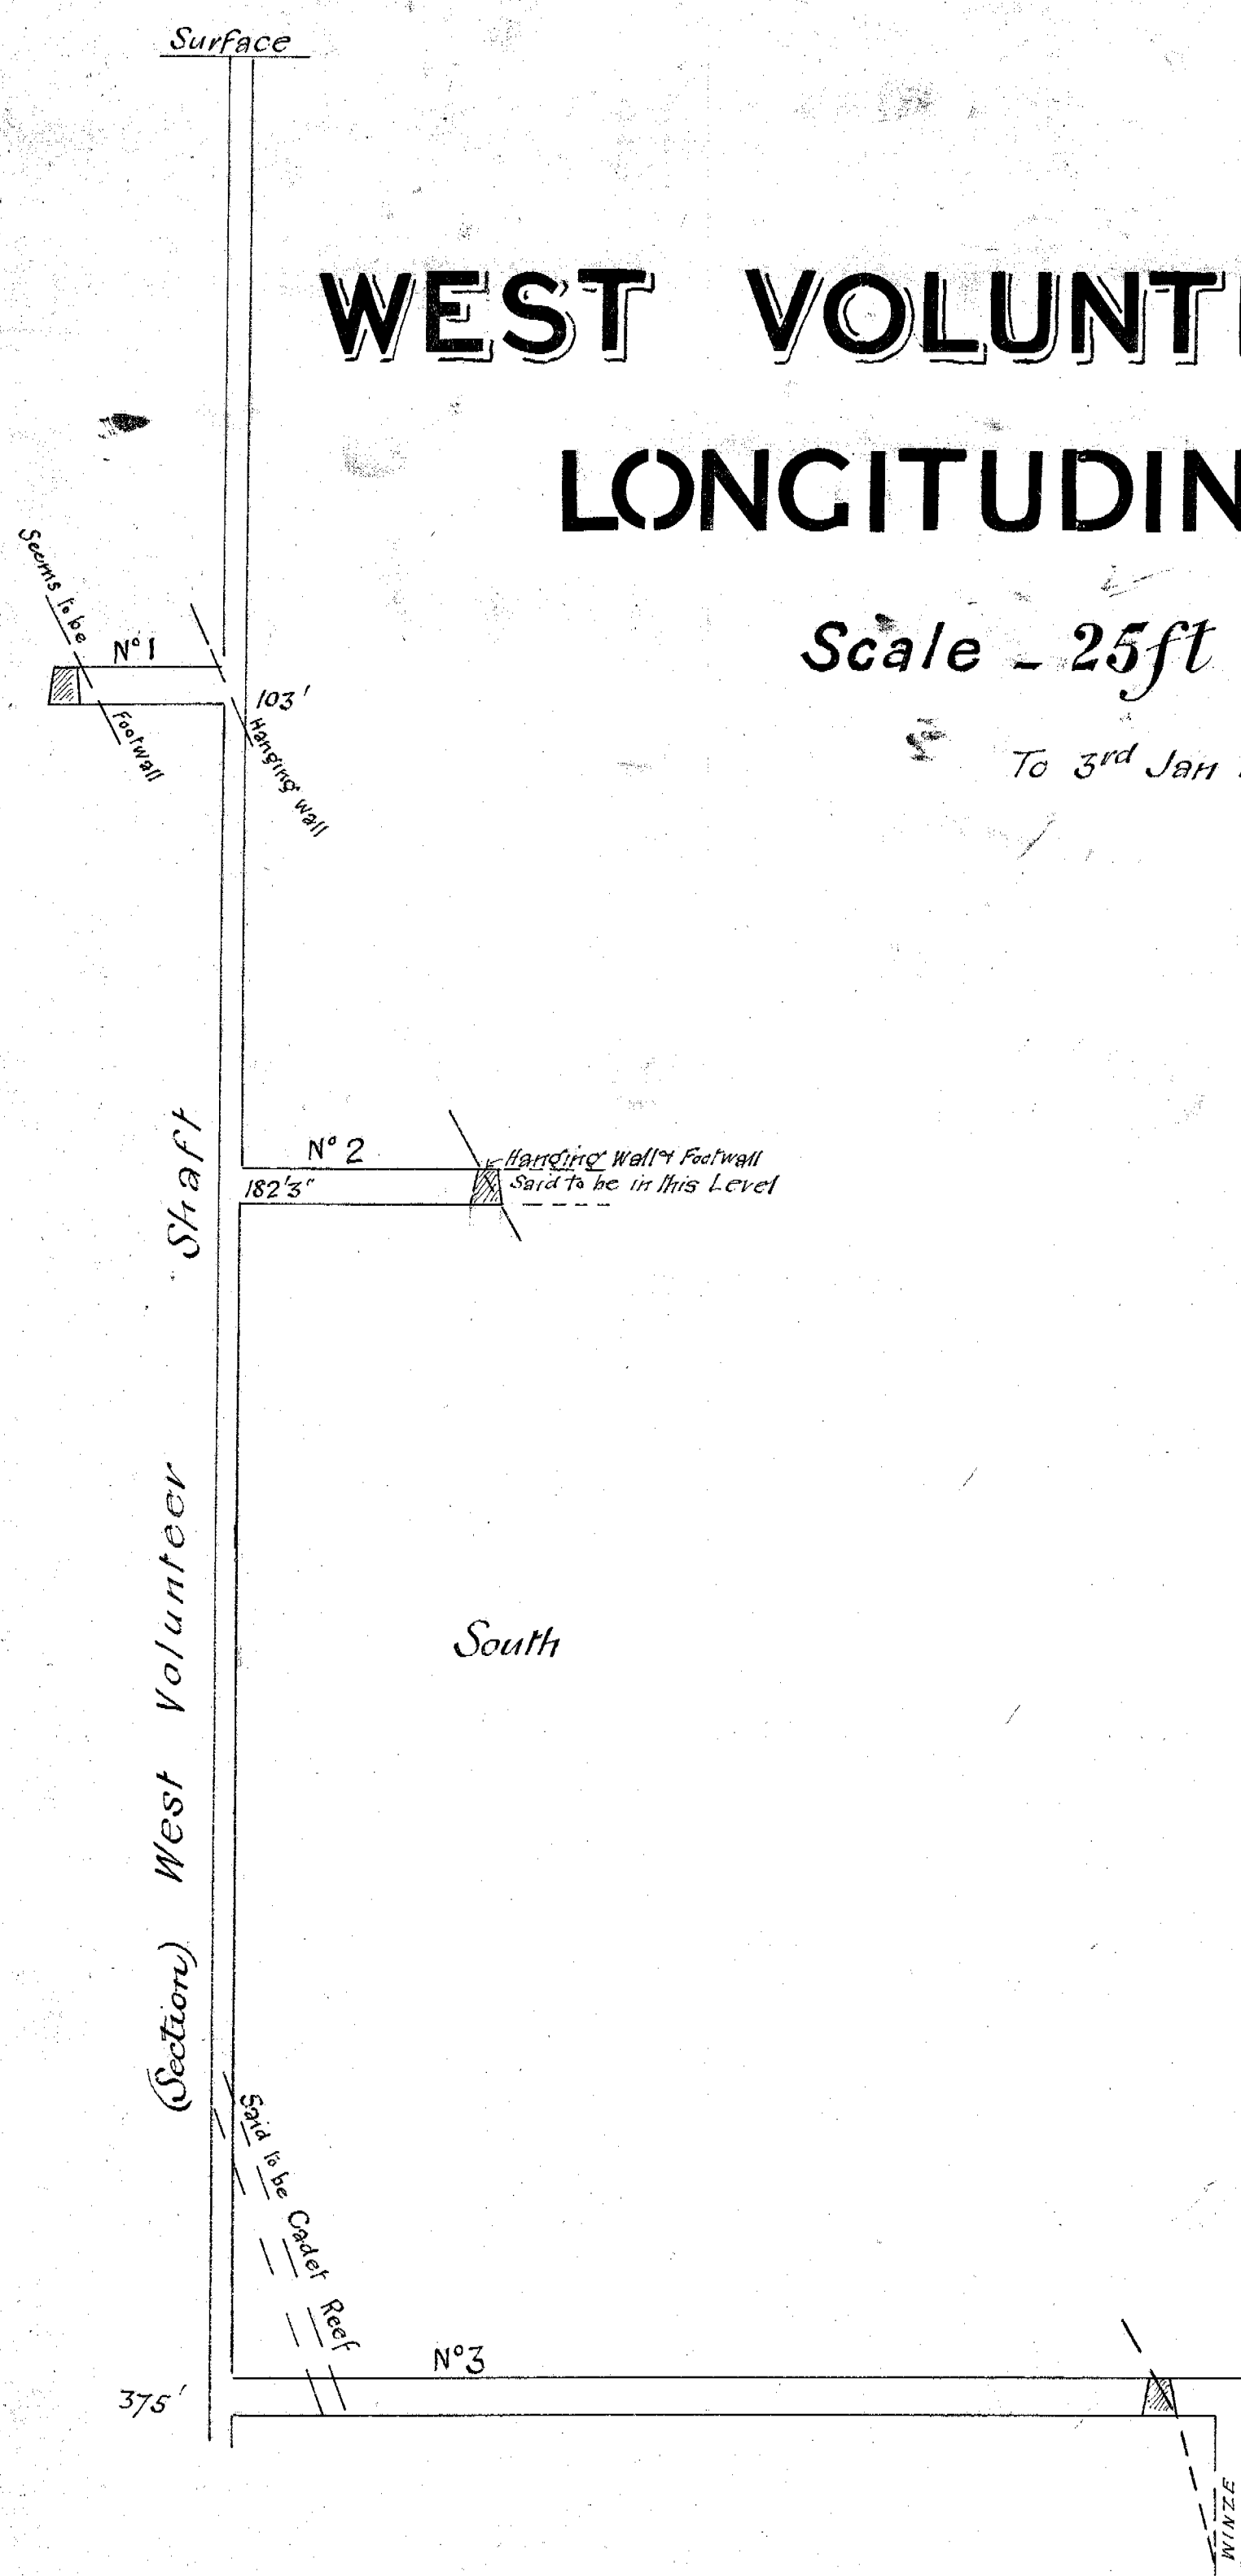

X Section through Shaft

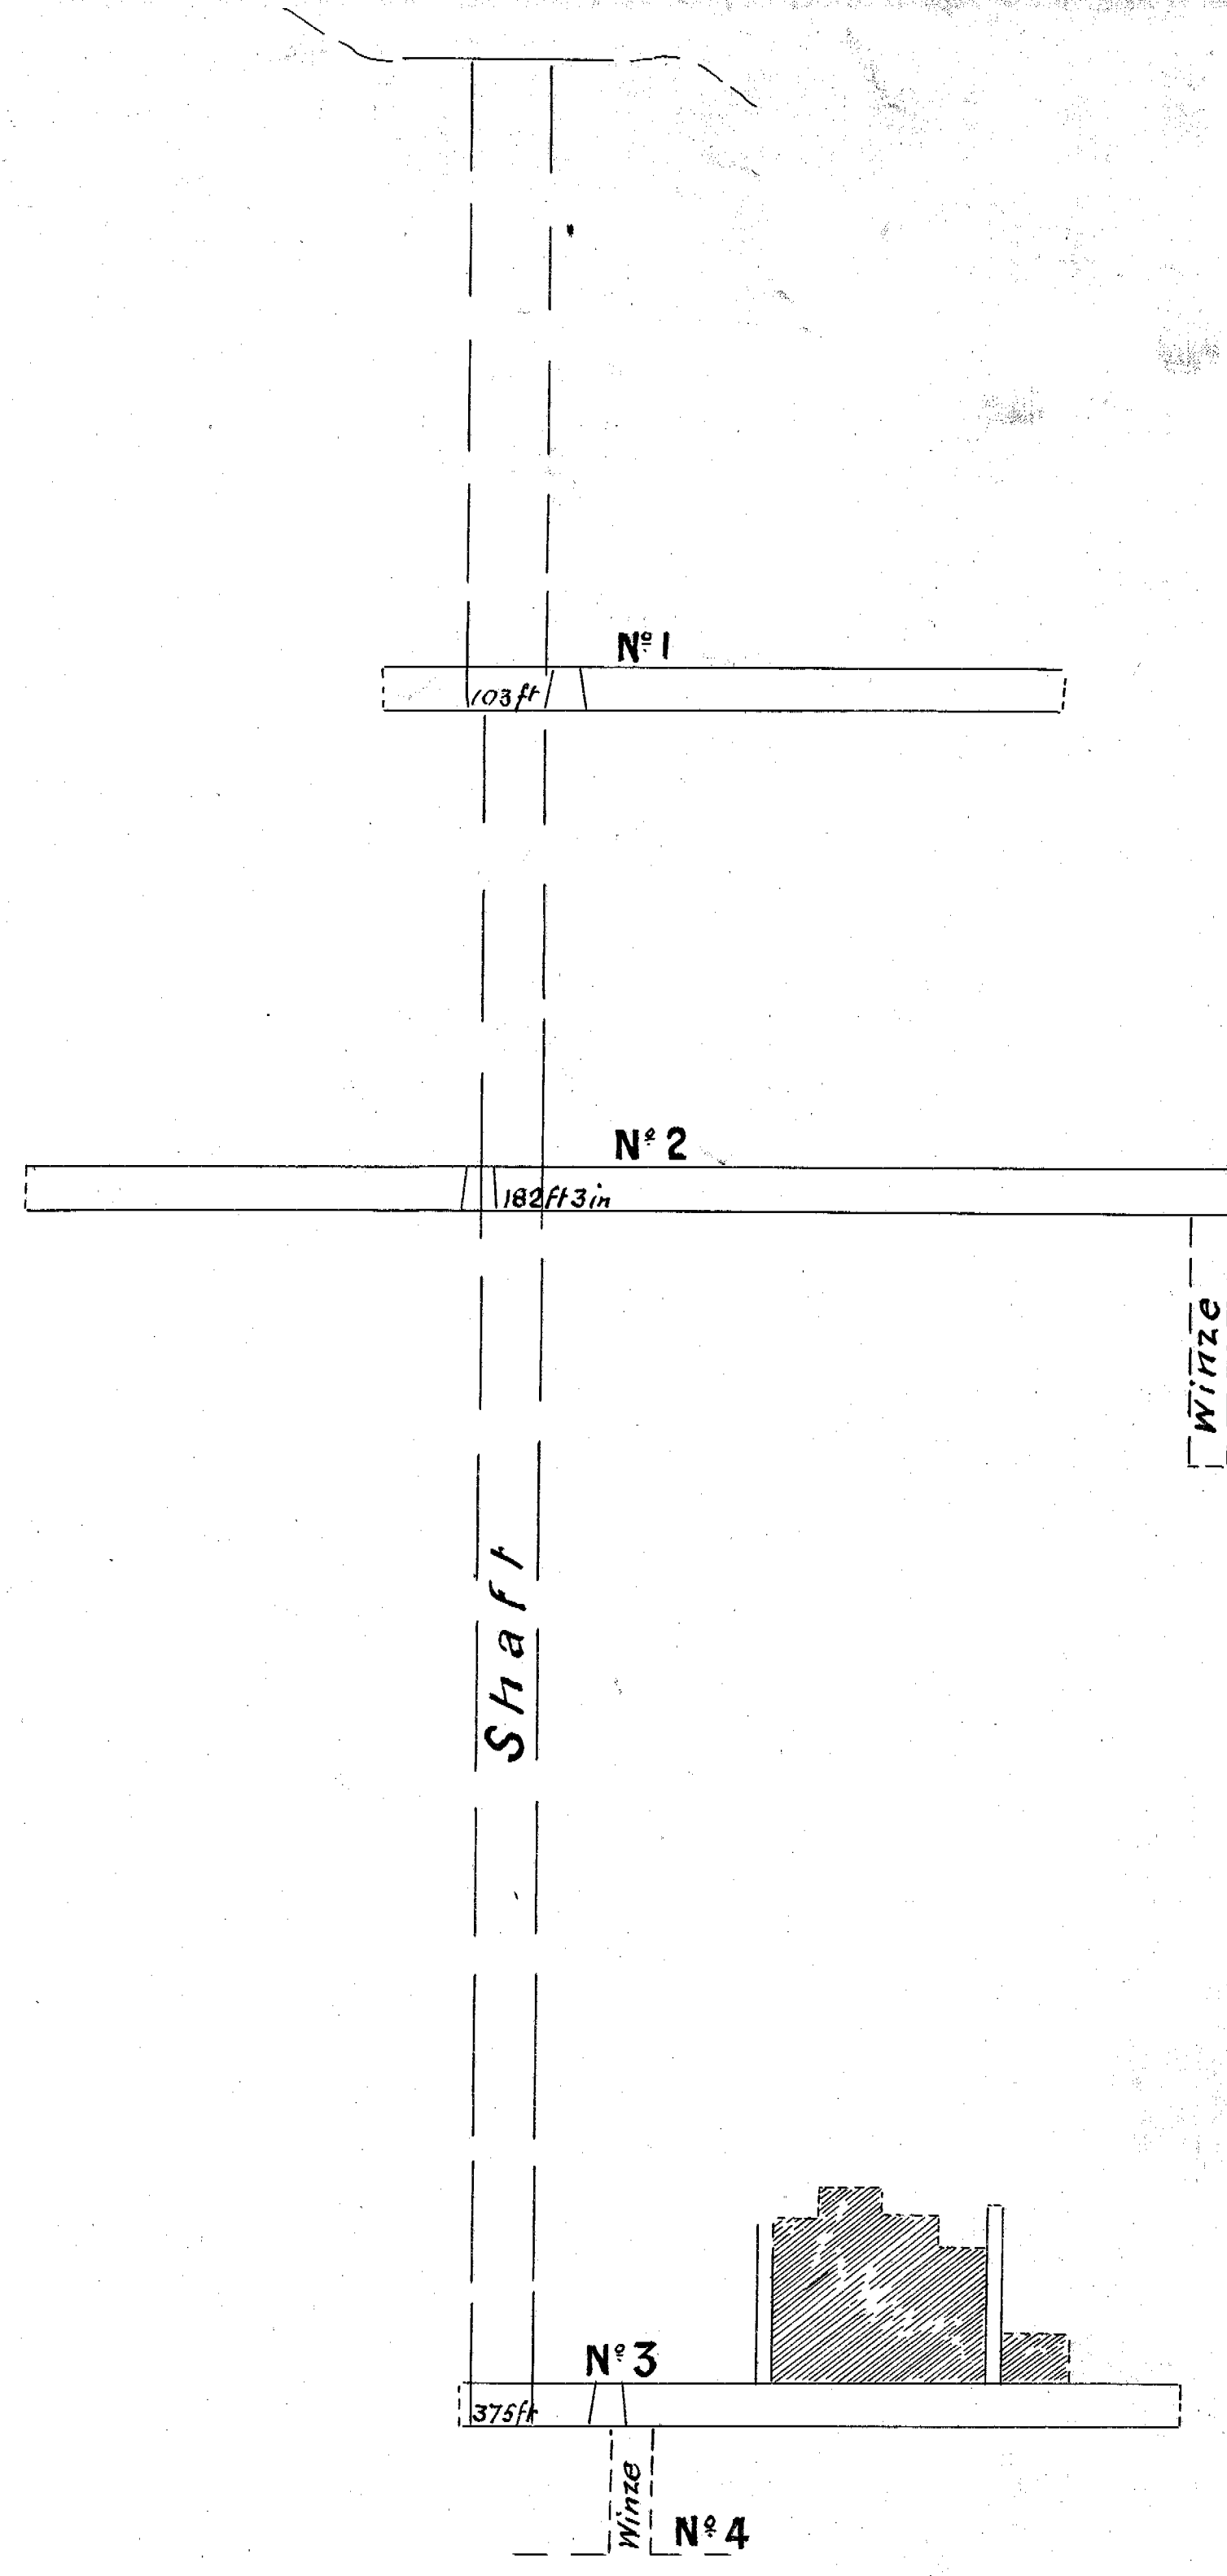

20 Jan 1896