

1896

VOLUNTEER GOLD MINE

LONGITUDINAL SECTION

Scale - 25ft to an inch

To 5th Decr 1896
Compiled to date from Managers Working plan
& from meas^{rs} taken by myself

RECORD OF WORK
24th June
1896
LAURENCE
27th Sept
1896
LAURENCE


Schedler
Schedler
17/1/96
Compiled from these drawings
plan by John P. Scherer
Manager
21st Decr 1896

PROSPECTING SHAFT

OLD SHAFT

SHAFT

MAIN

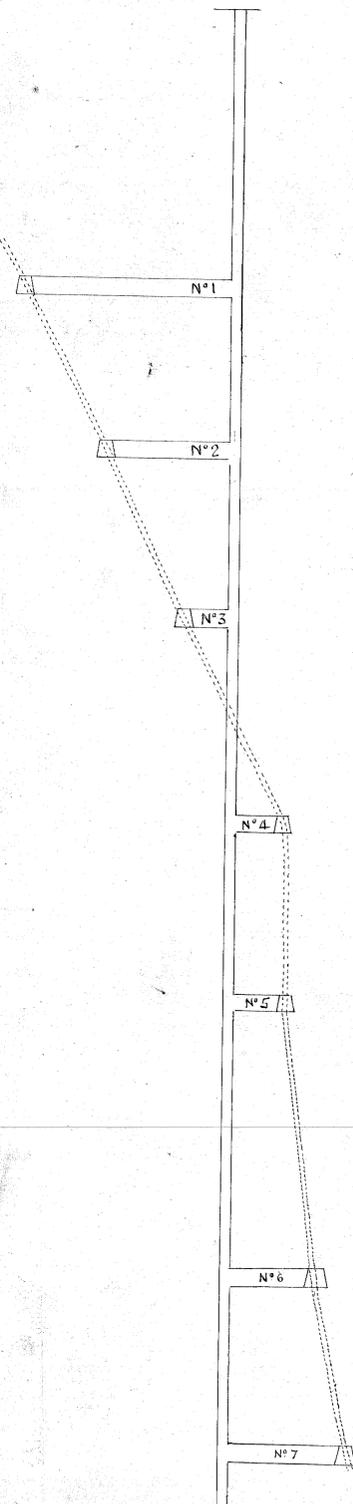

Stambeck workings

105 ft N°1

164 ft 6 in N°2

225 ft N°3

298 ft 9 in N°4

564 ft N°5

1665 ft 9 in N°6

N°7