

VOLUNTEER GOLD MINE


PLAN OF DRIVES

Scale - 25ft to an inch



Checked and
corrected
17/1/95
Compiled from
John Brown
Maurice
21/1/1895

Note - meas^{ts} in links
4" Y Theodolite used

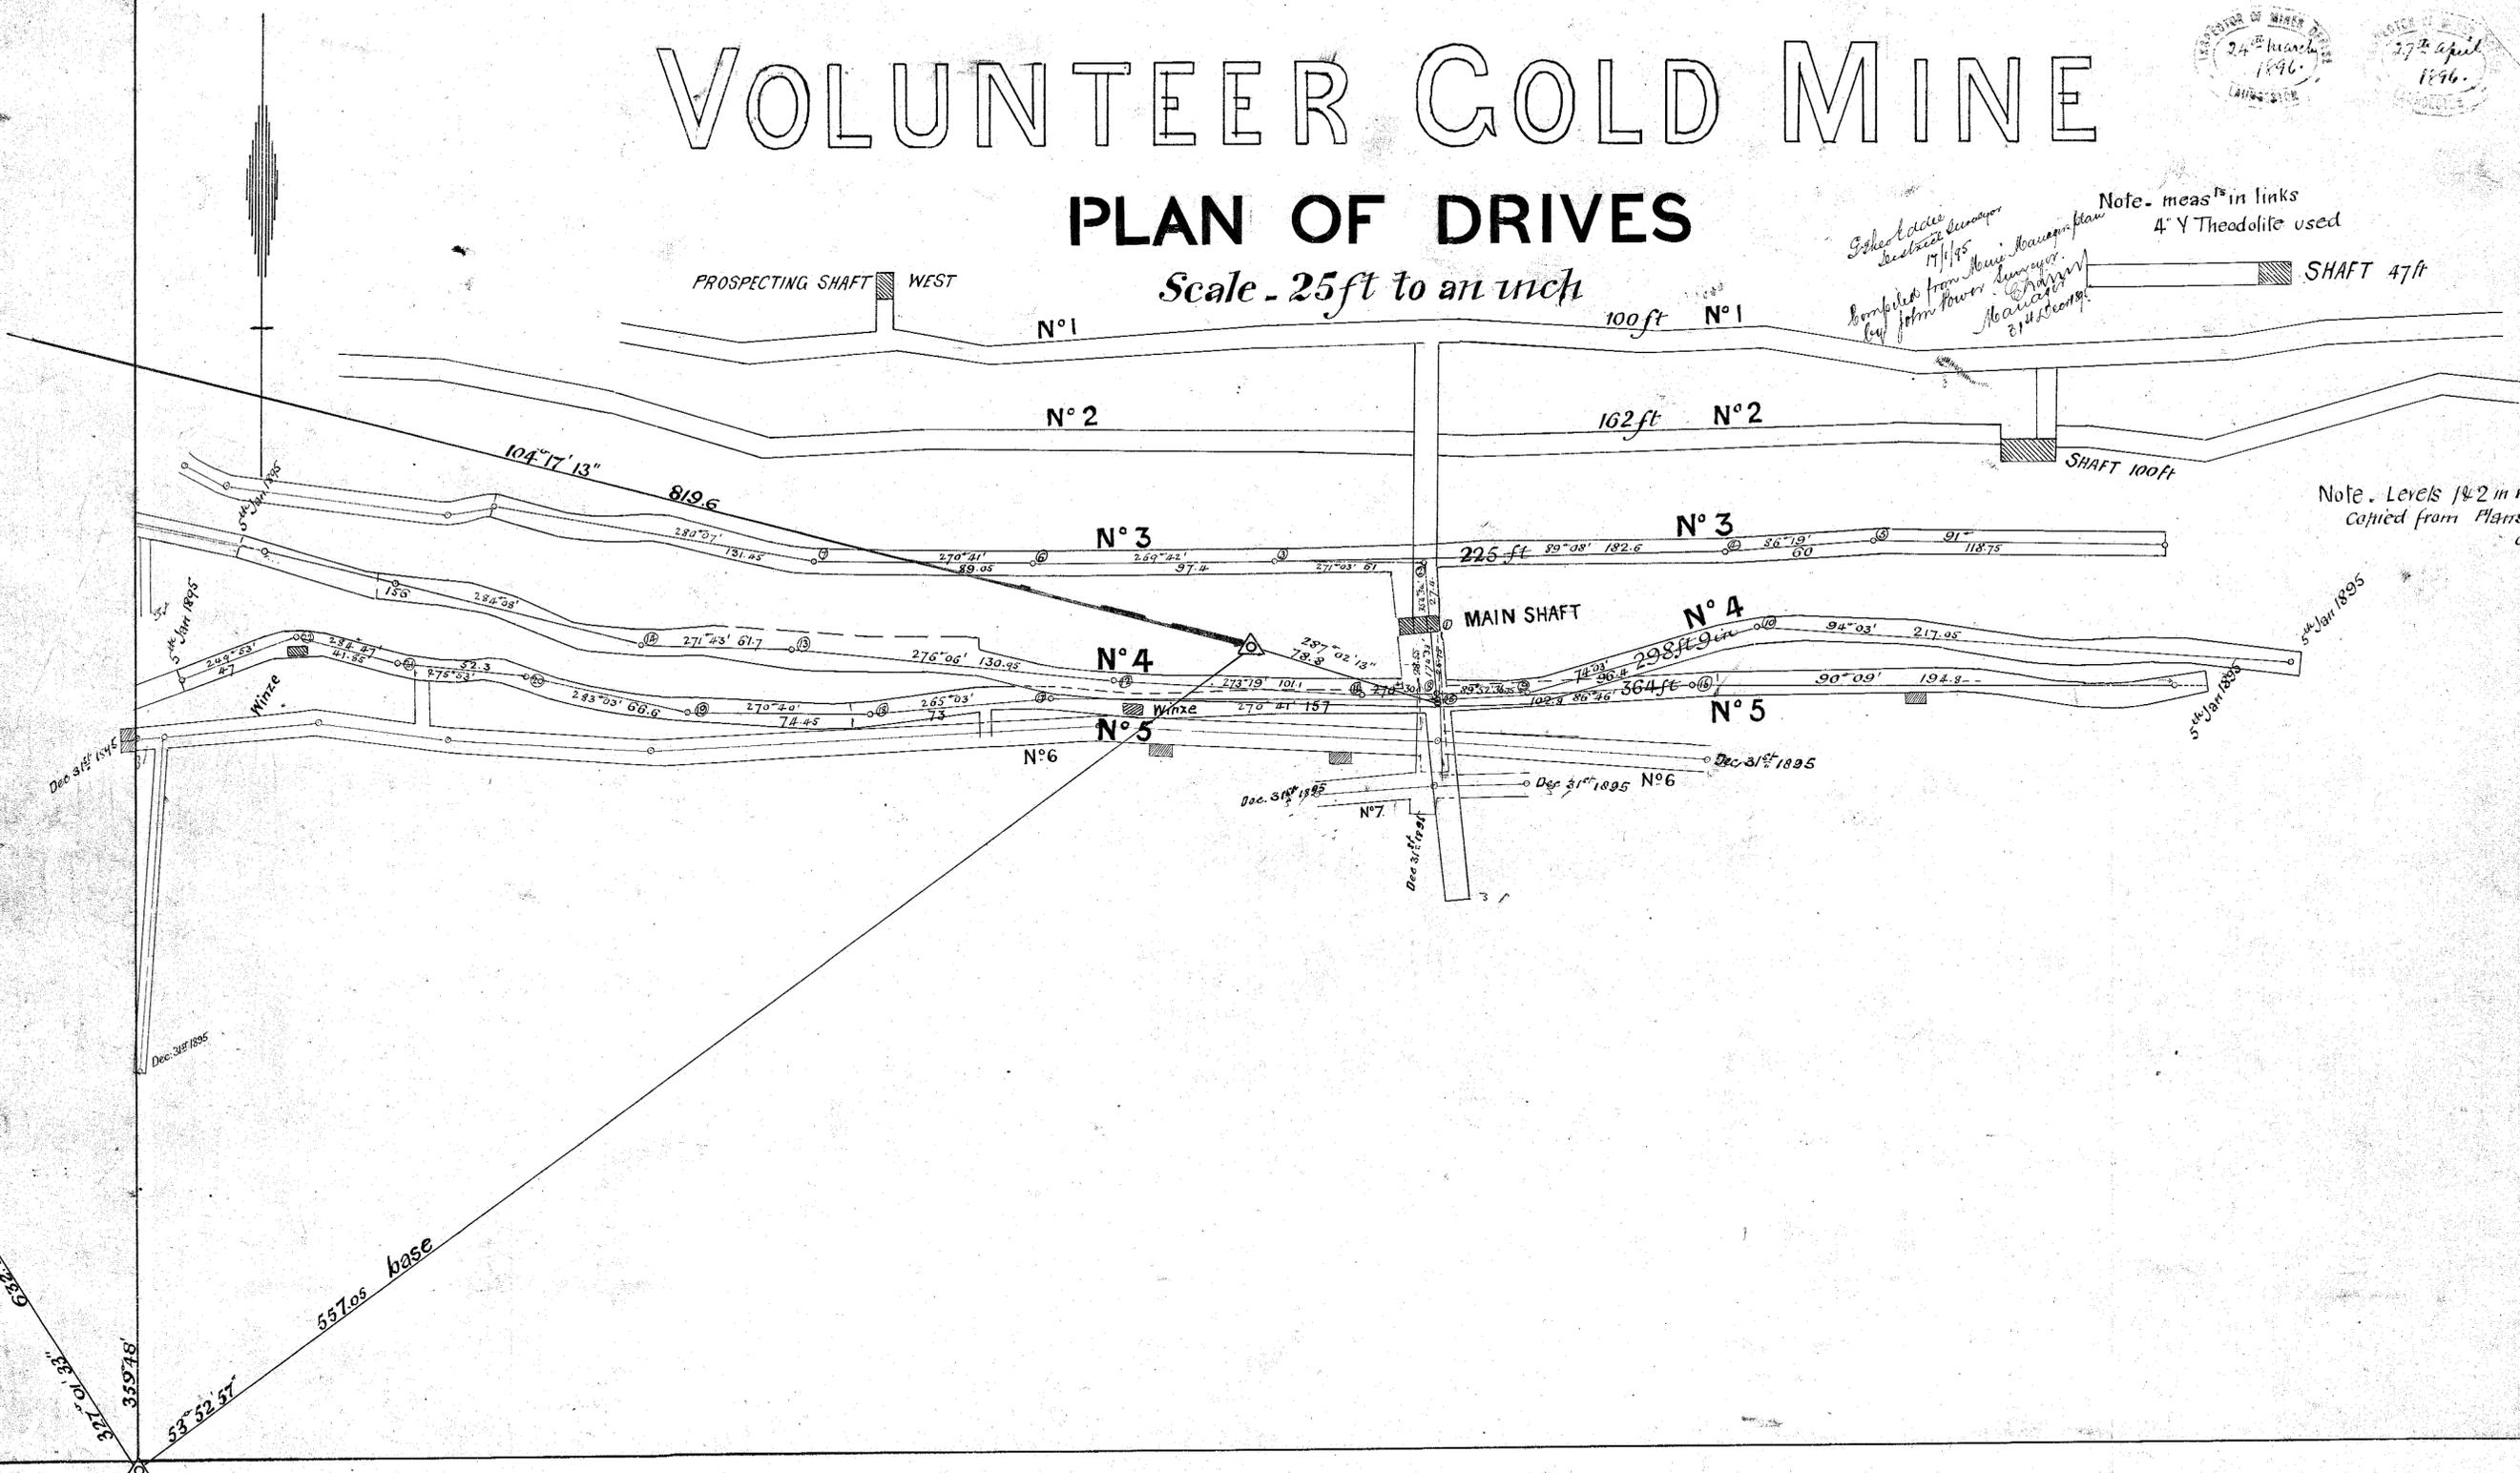

Note. Levels 1 & 2 in red are
copied from Plans of
others

1895 1896

50

50

50

50