


Volunteer Mine Plan

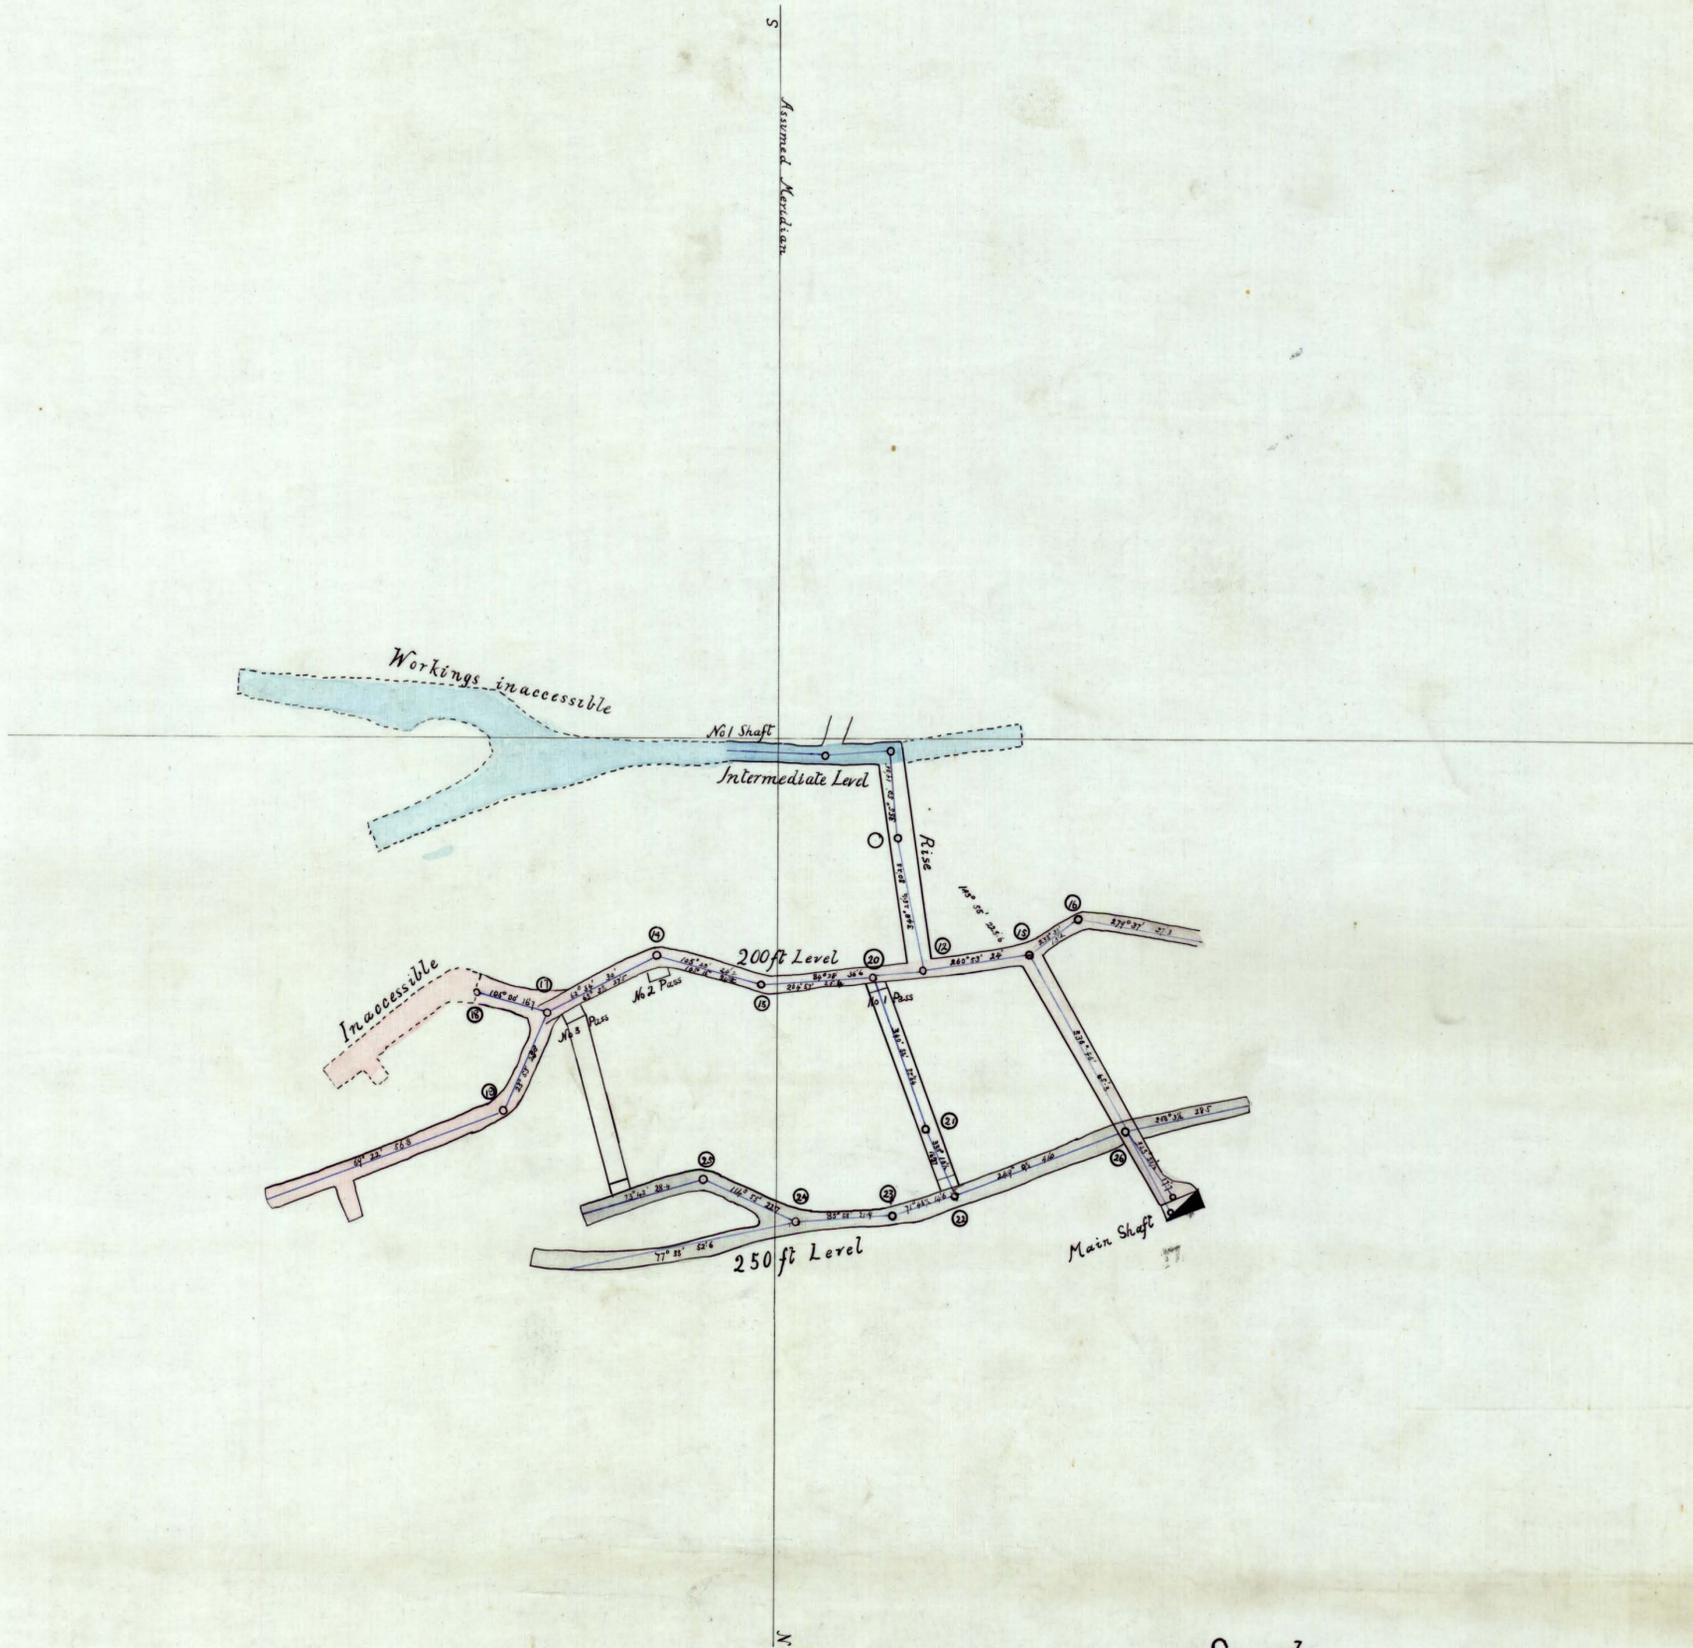

Scale
1 inch = 25 feet

Hartwell Conder
1/14/04
INSPECTOR OF MINES
64/104
HARTWELL CONDER
MINING ENGINEER
L. CAMBRIDGE, F.R.S.M., LONDON