
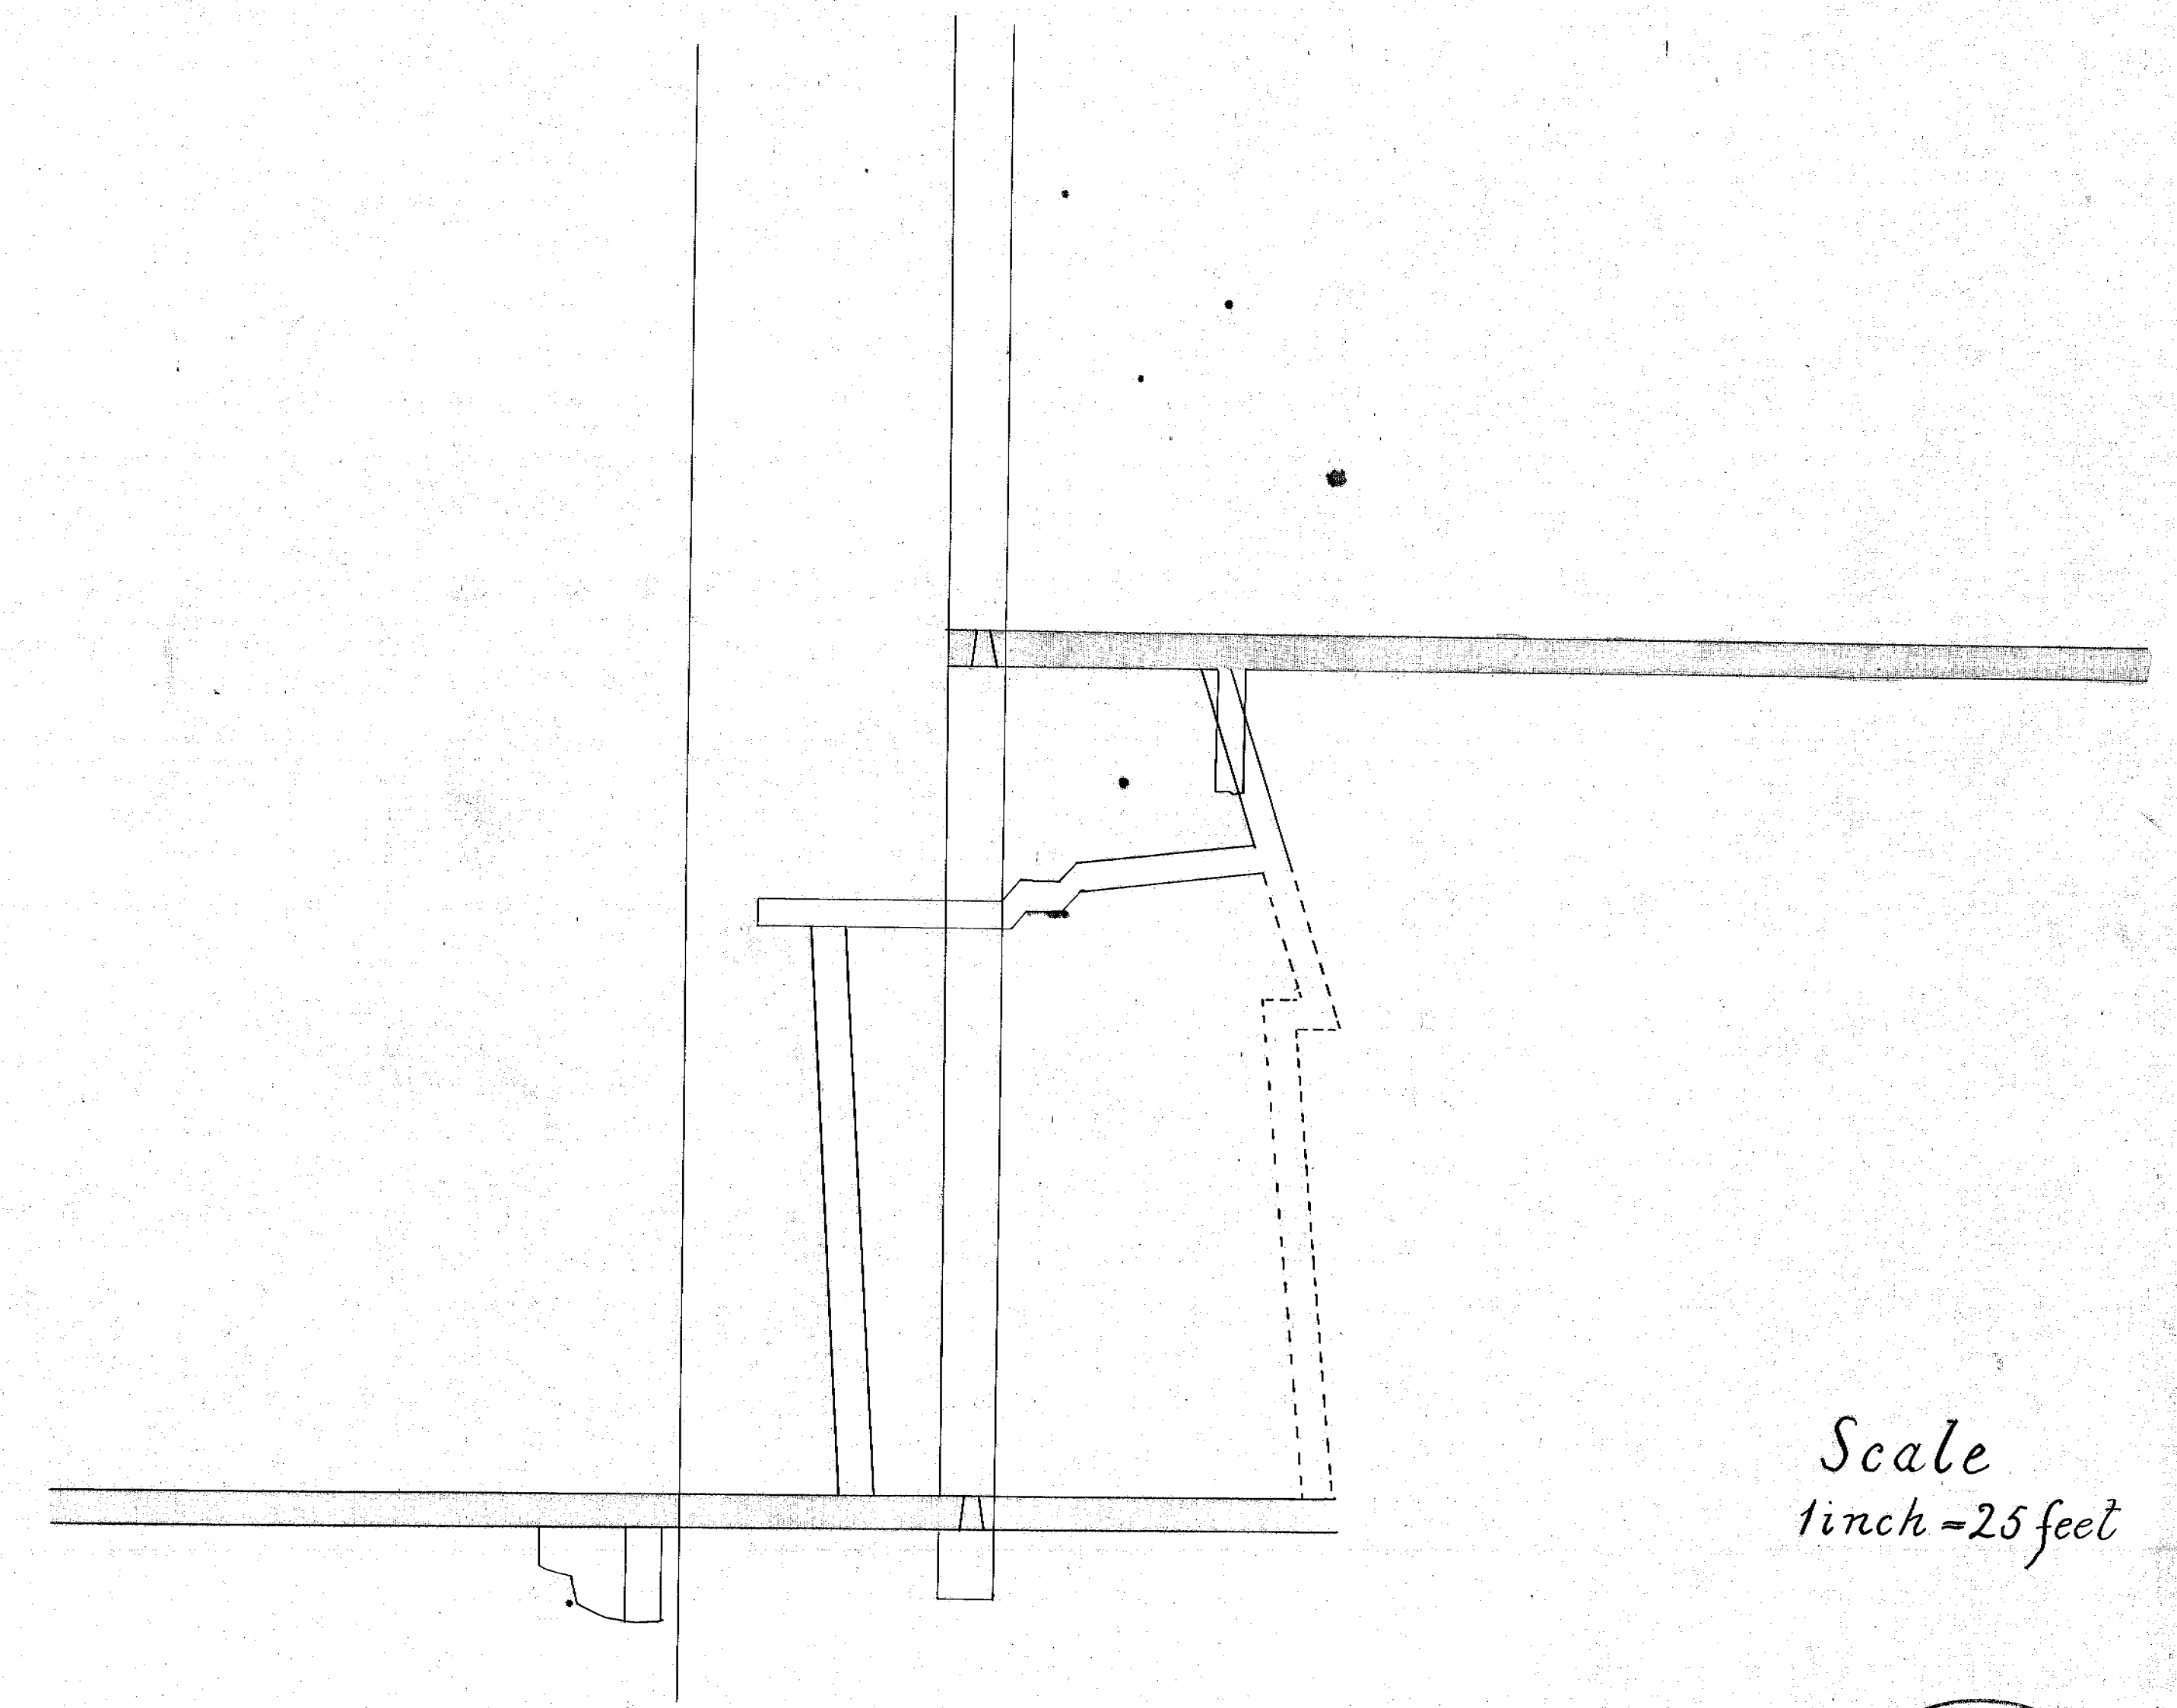


Volunteer Consolidated Mine Sections

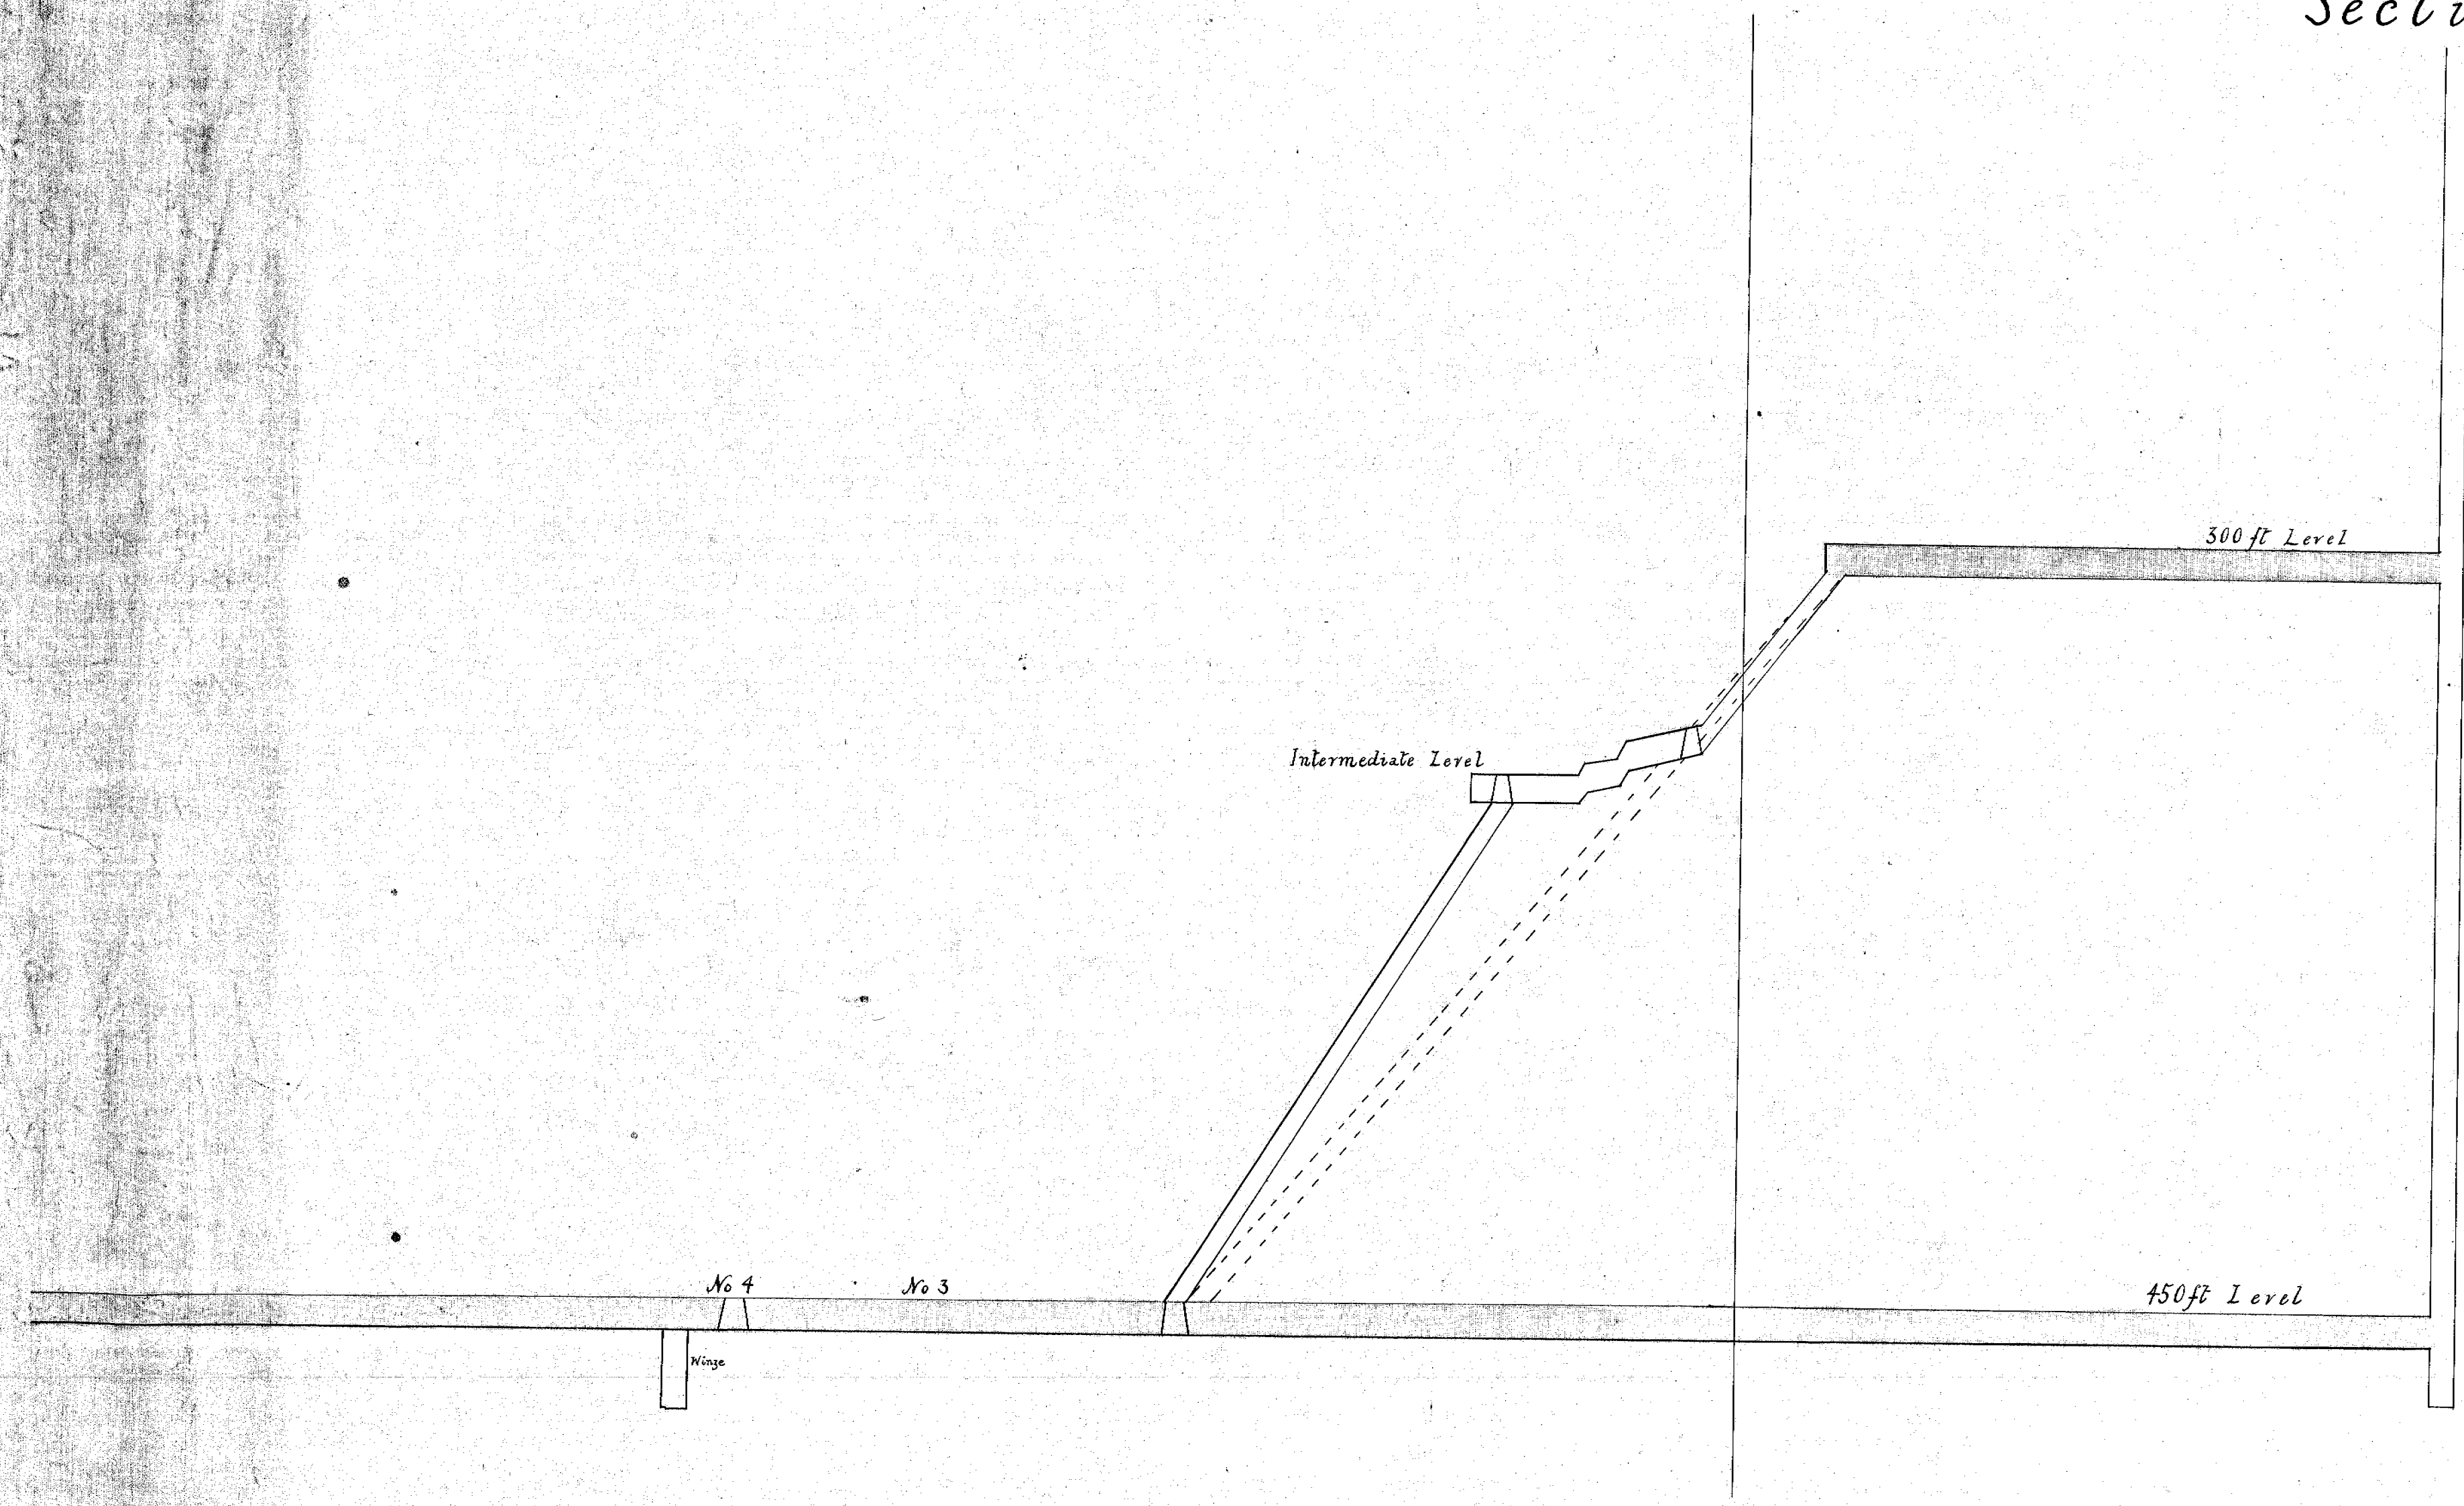

Scale
1 inch = 25 feet

INSPECTOR OF
23rd/04
Hartwell Conder.
10/6/04
HARTWELL CONDER
MINING ENGINEER
M.A. CAMBRIDGE, A.R.S.V., LONDON