


39

07

25

25

W. level. 628 ft.
Center Main Shaft to Center Main Hoize 95.7'

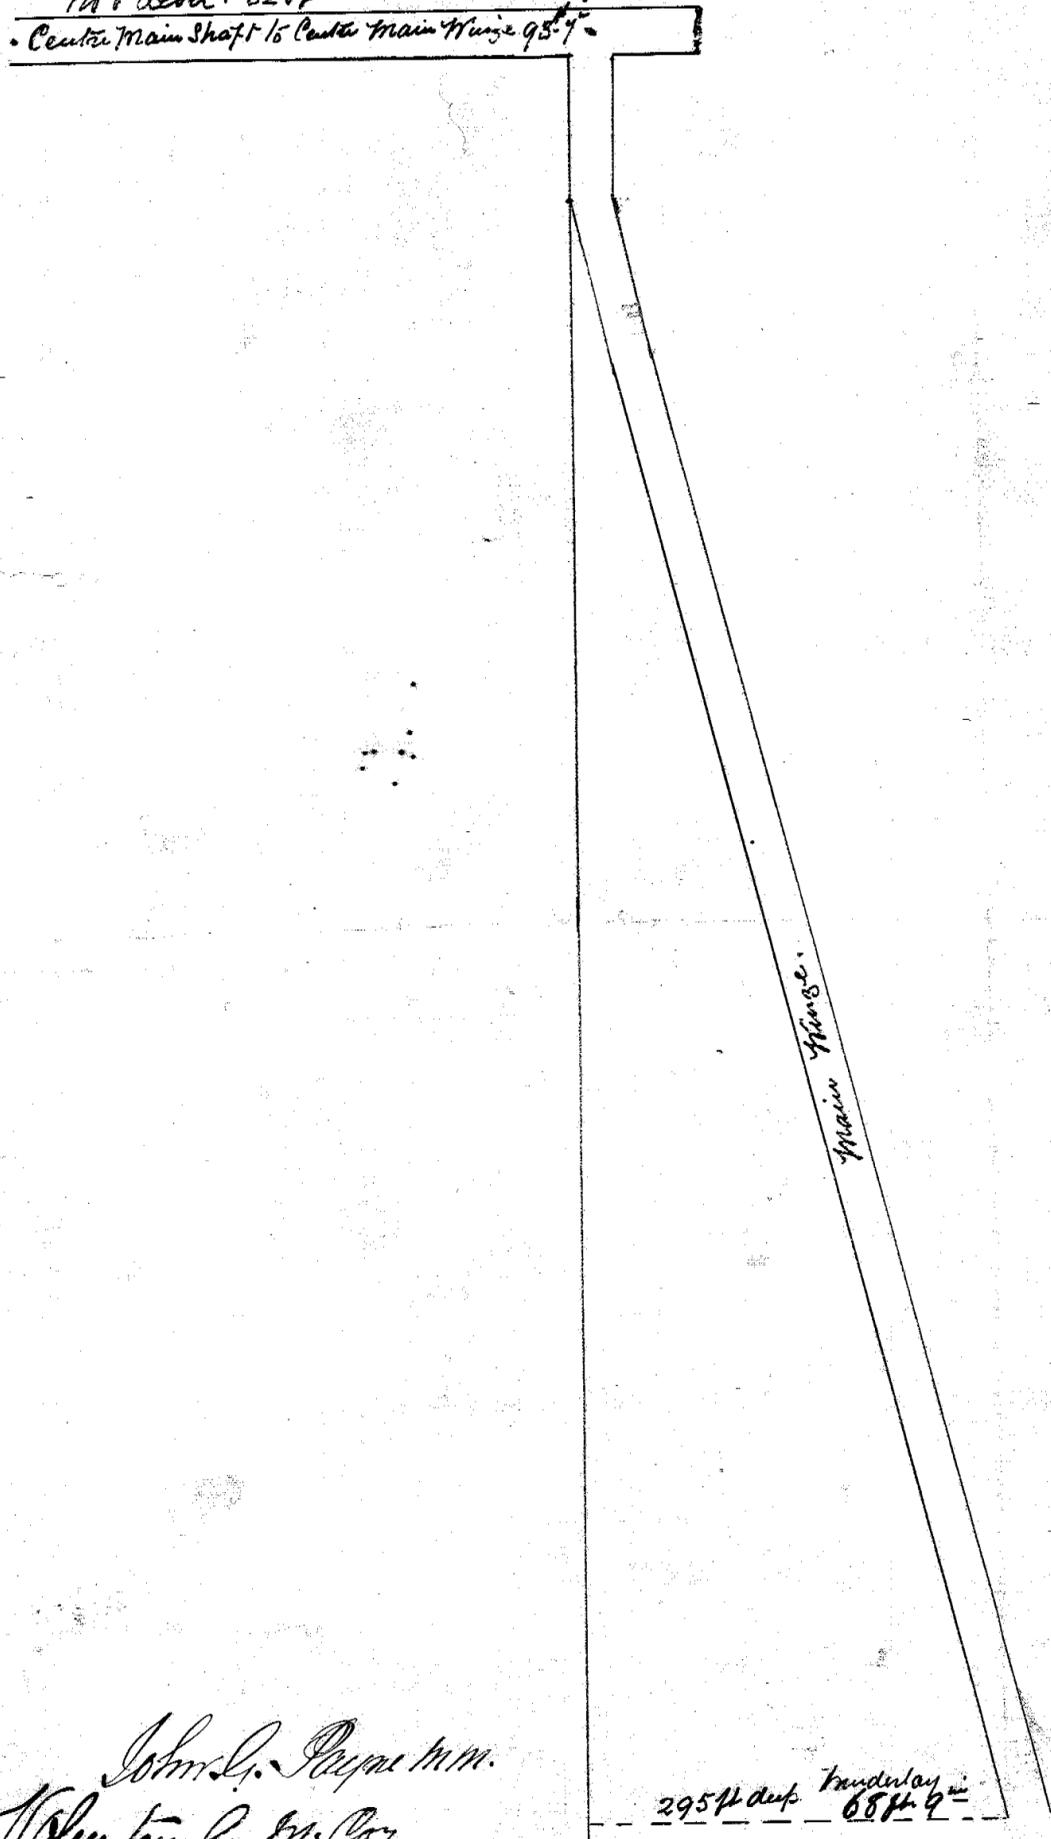

John G. Payne M.M.
Volunteer G. M. Coy.
Dec 31st 1895.

295 ft deep
68 ft 6 in



25

25