


50

50

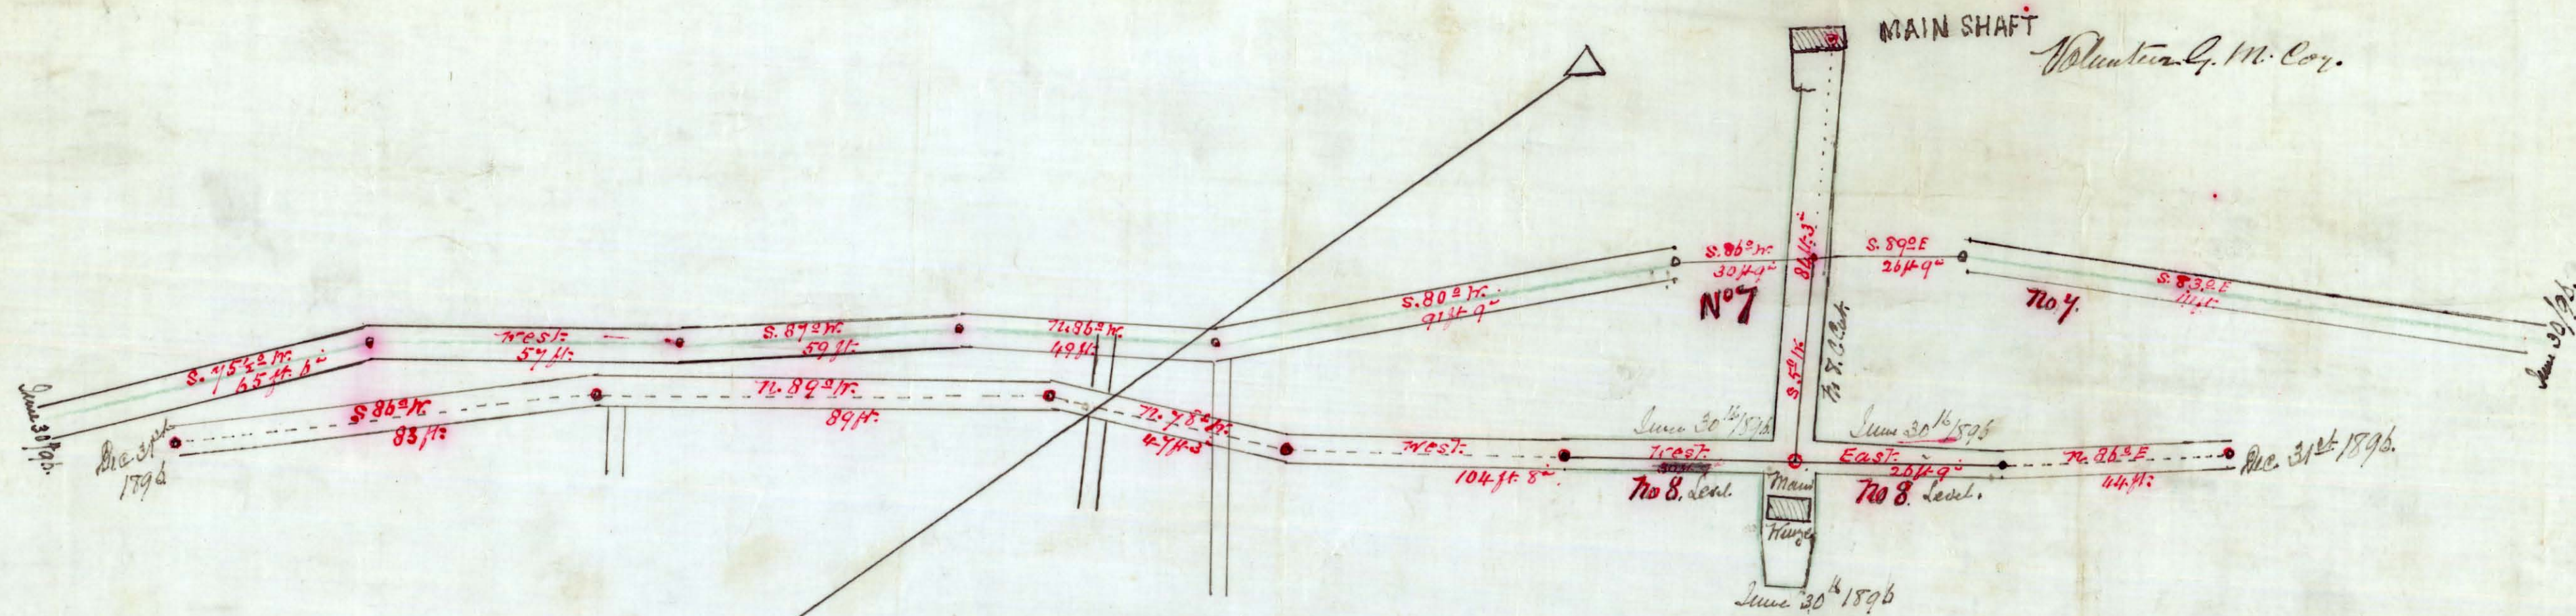

Taken with Circumferentor.
John G. & James M. M.

Main Hoist Level
295 feet. at date
Dec. 31st 1896.

Work done for year
ending Dec. 31st 1896.



50

50

319
08