
 


# VOLUNTEER MINE PLAN

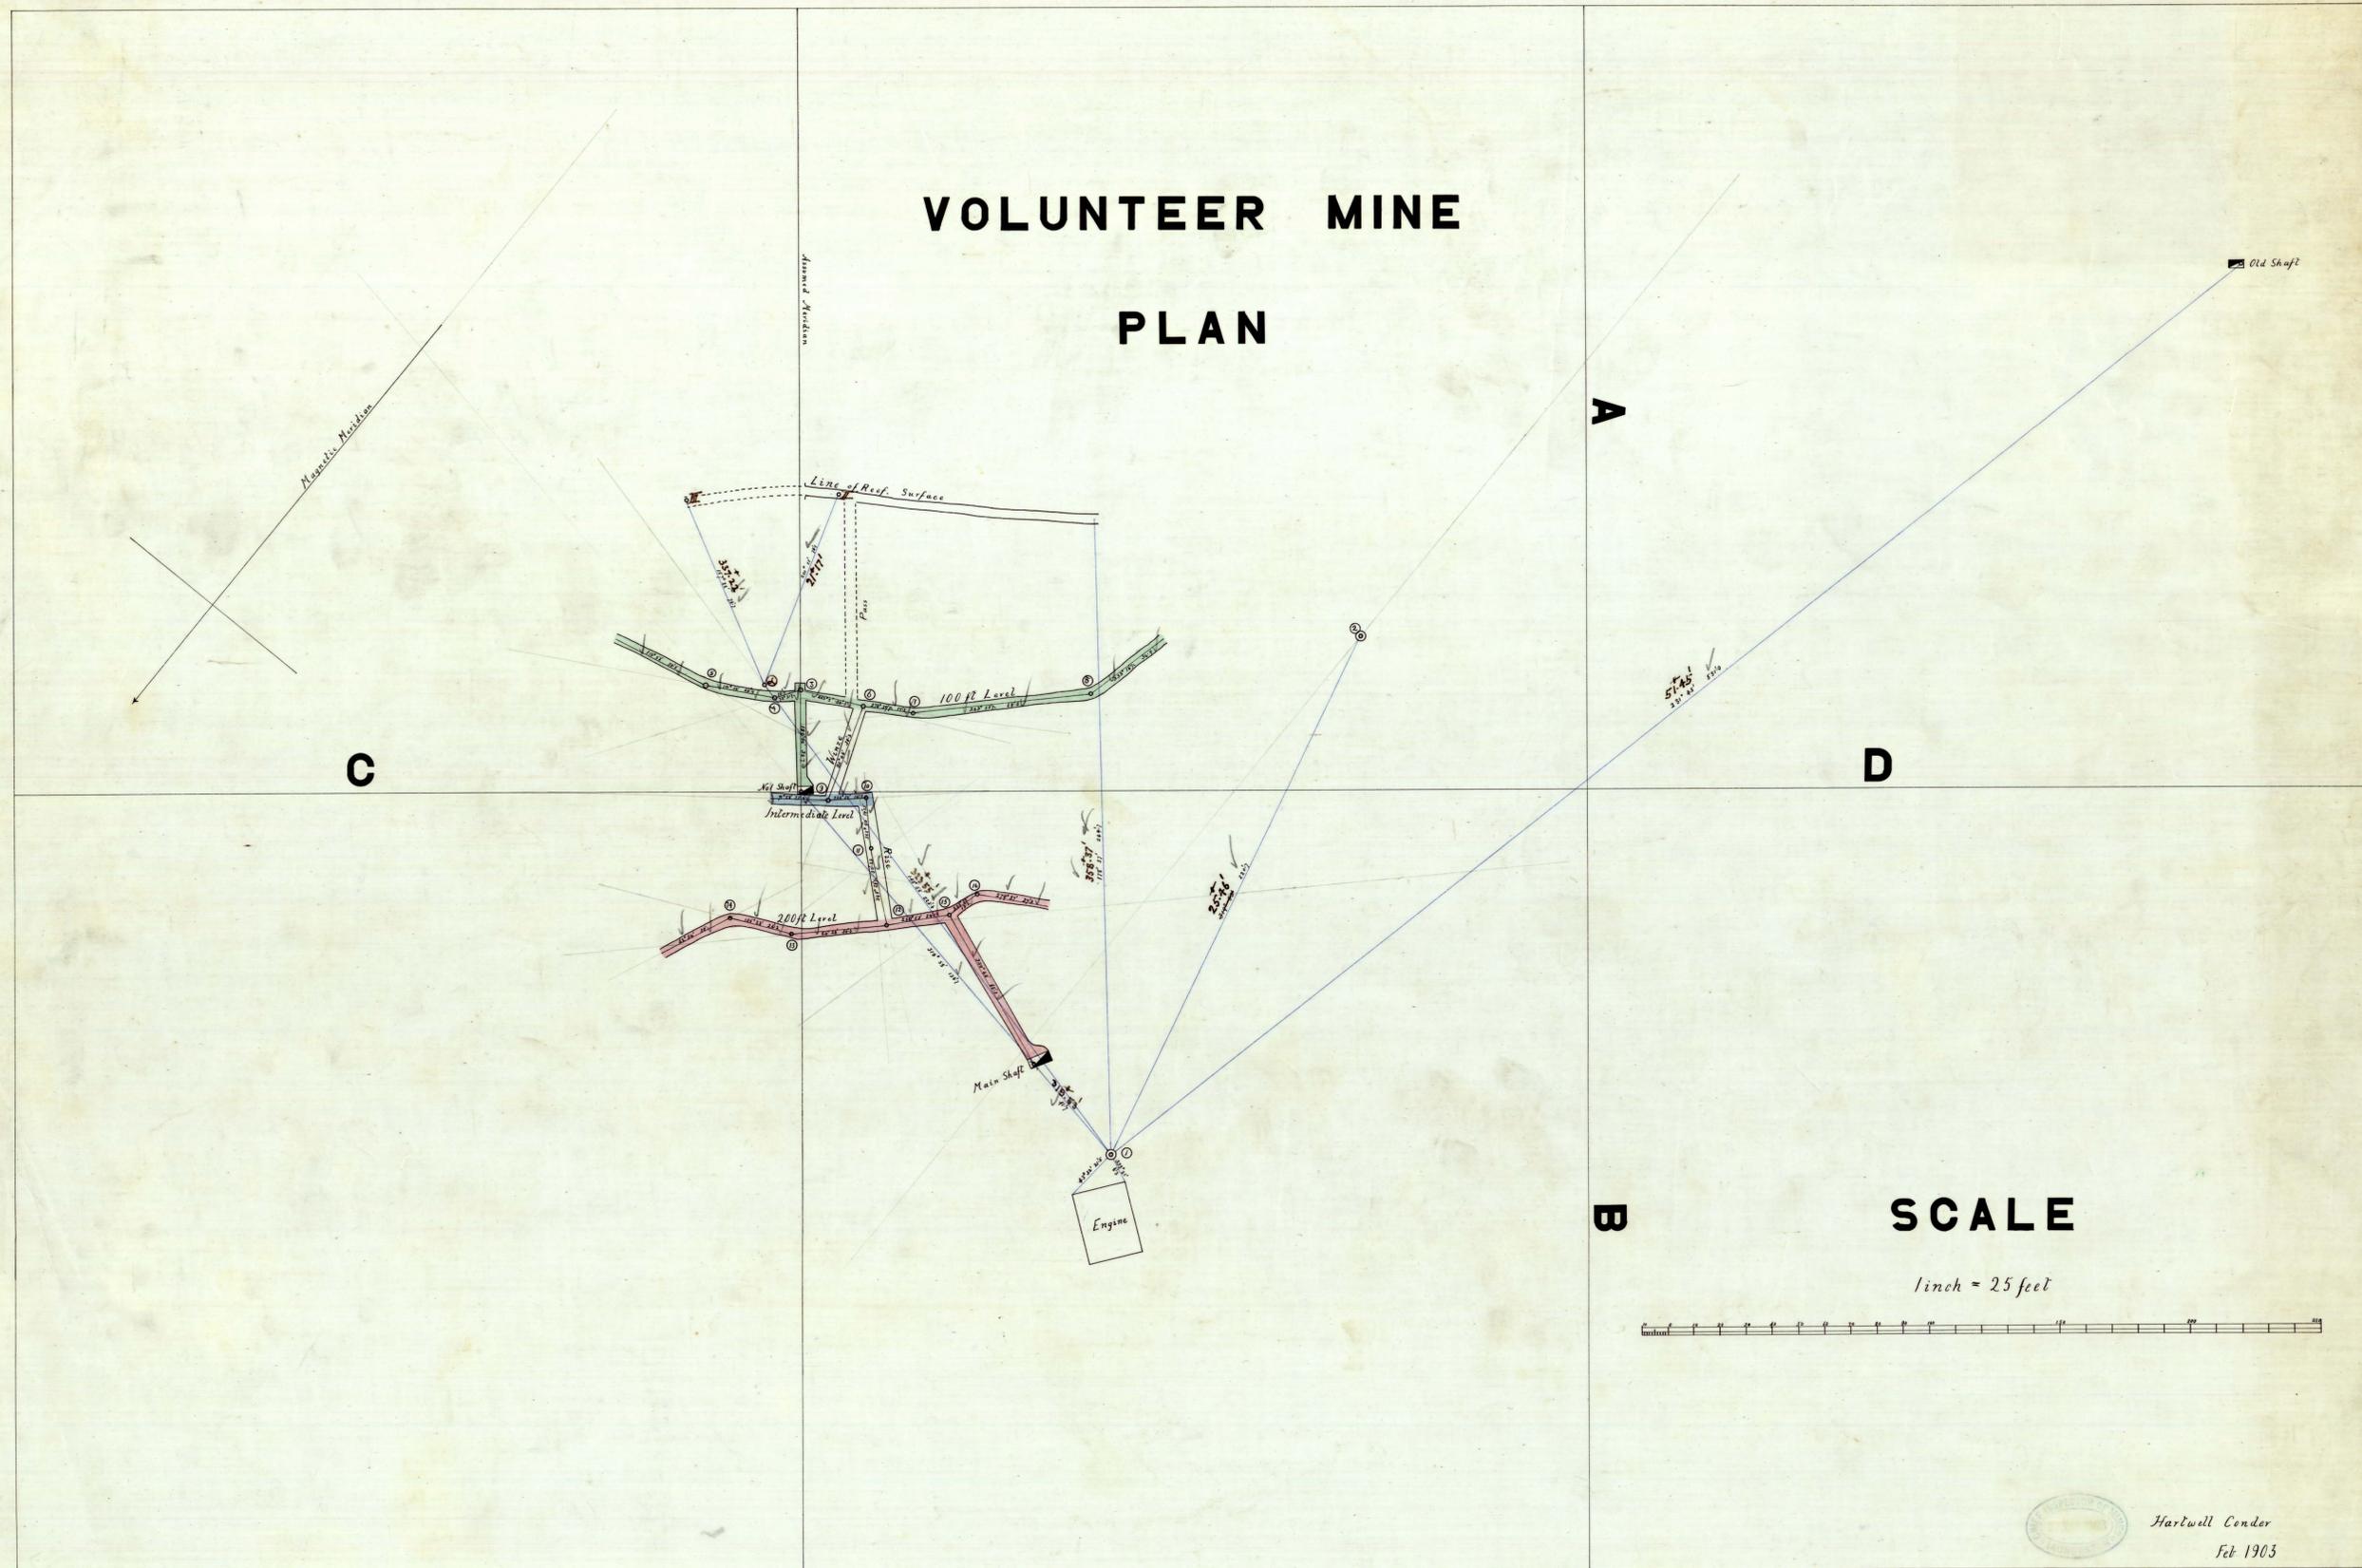

## SCALE

1 inch = 25 feet



Harlowell Conder  
Feb 1903

1303  
1001  
1001

3e

3e

3e

3e