
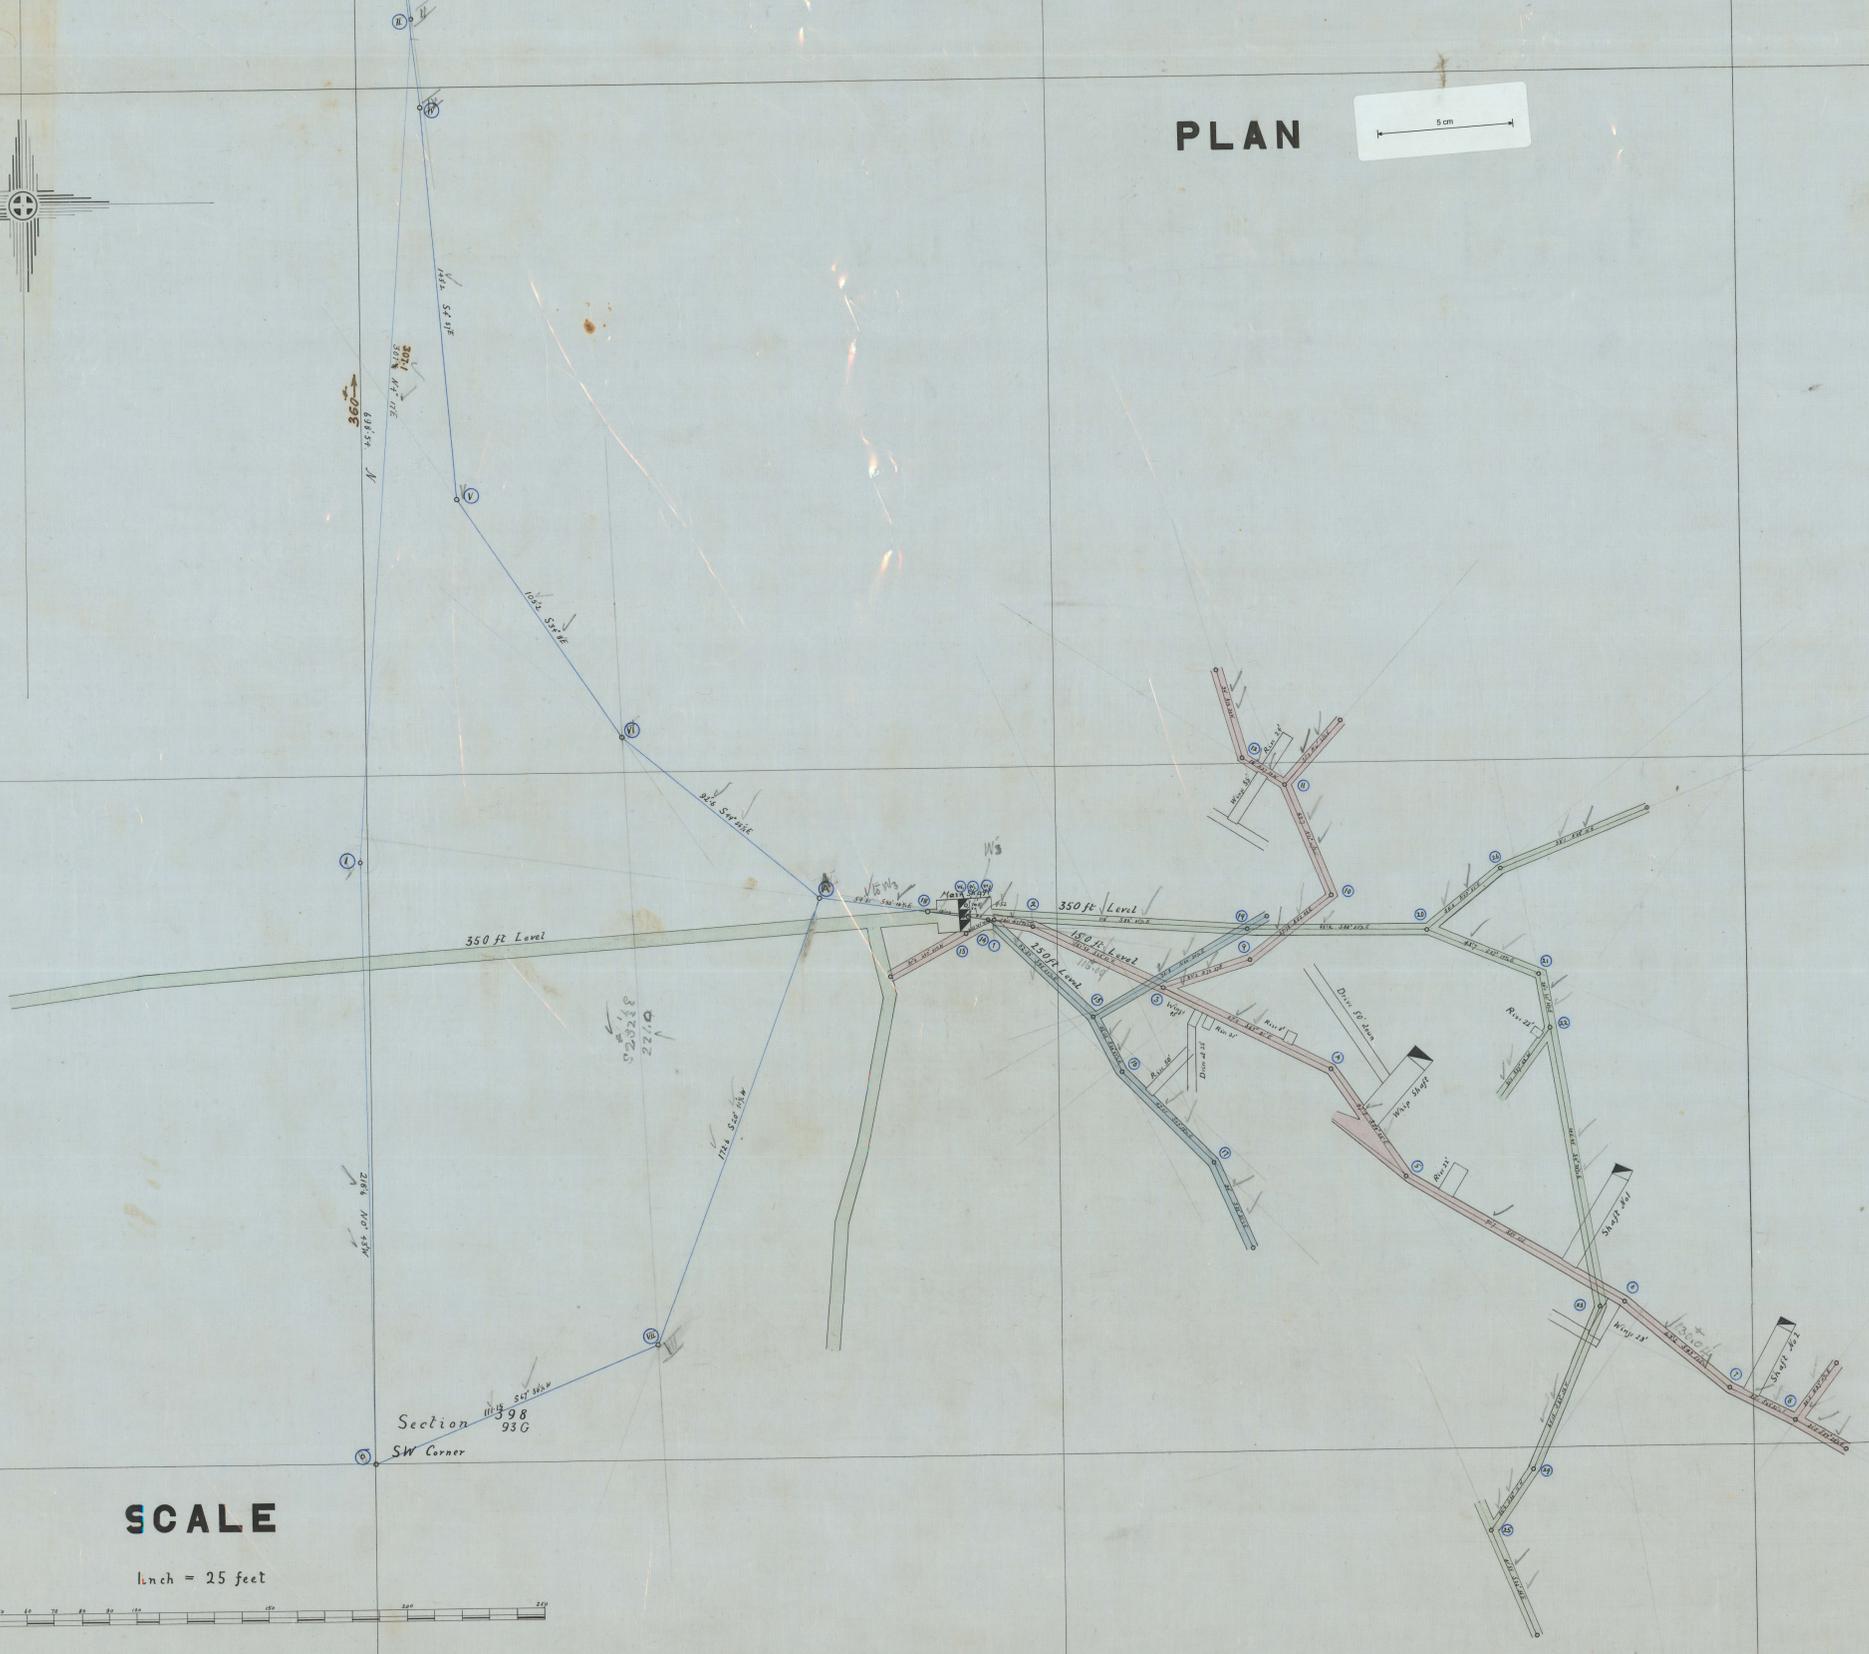


not. P. ... 1901 not.

NW Corner Peg

# VOLUNTEER MINE

## PLAN

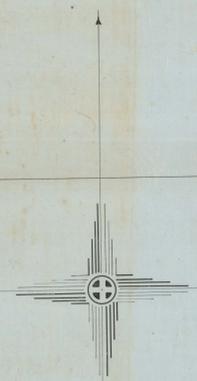

### SCALE

1 inch = 25 feet

