


Section. $\frac{834}{84.6}$

Centre of Main Wing
at: No 8 Level to South
Boundary. 126'2"

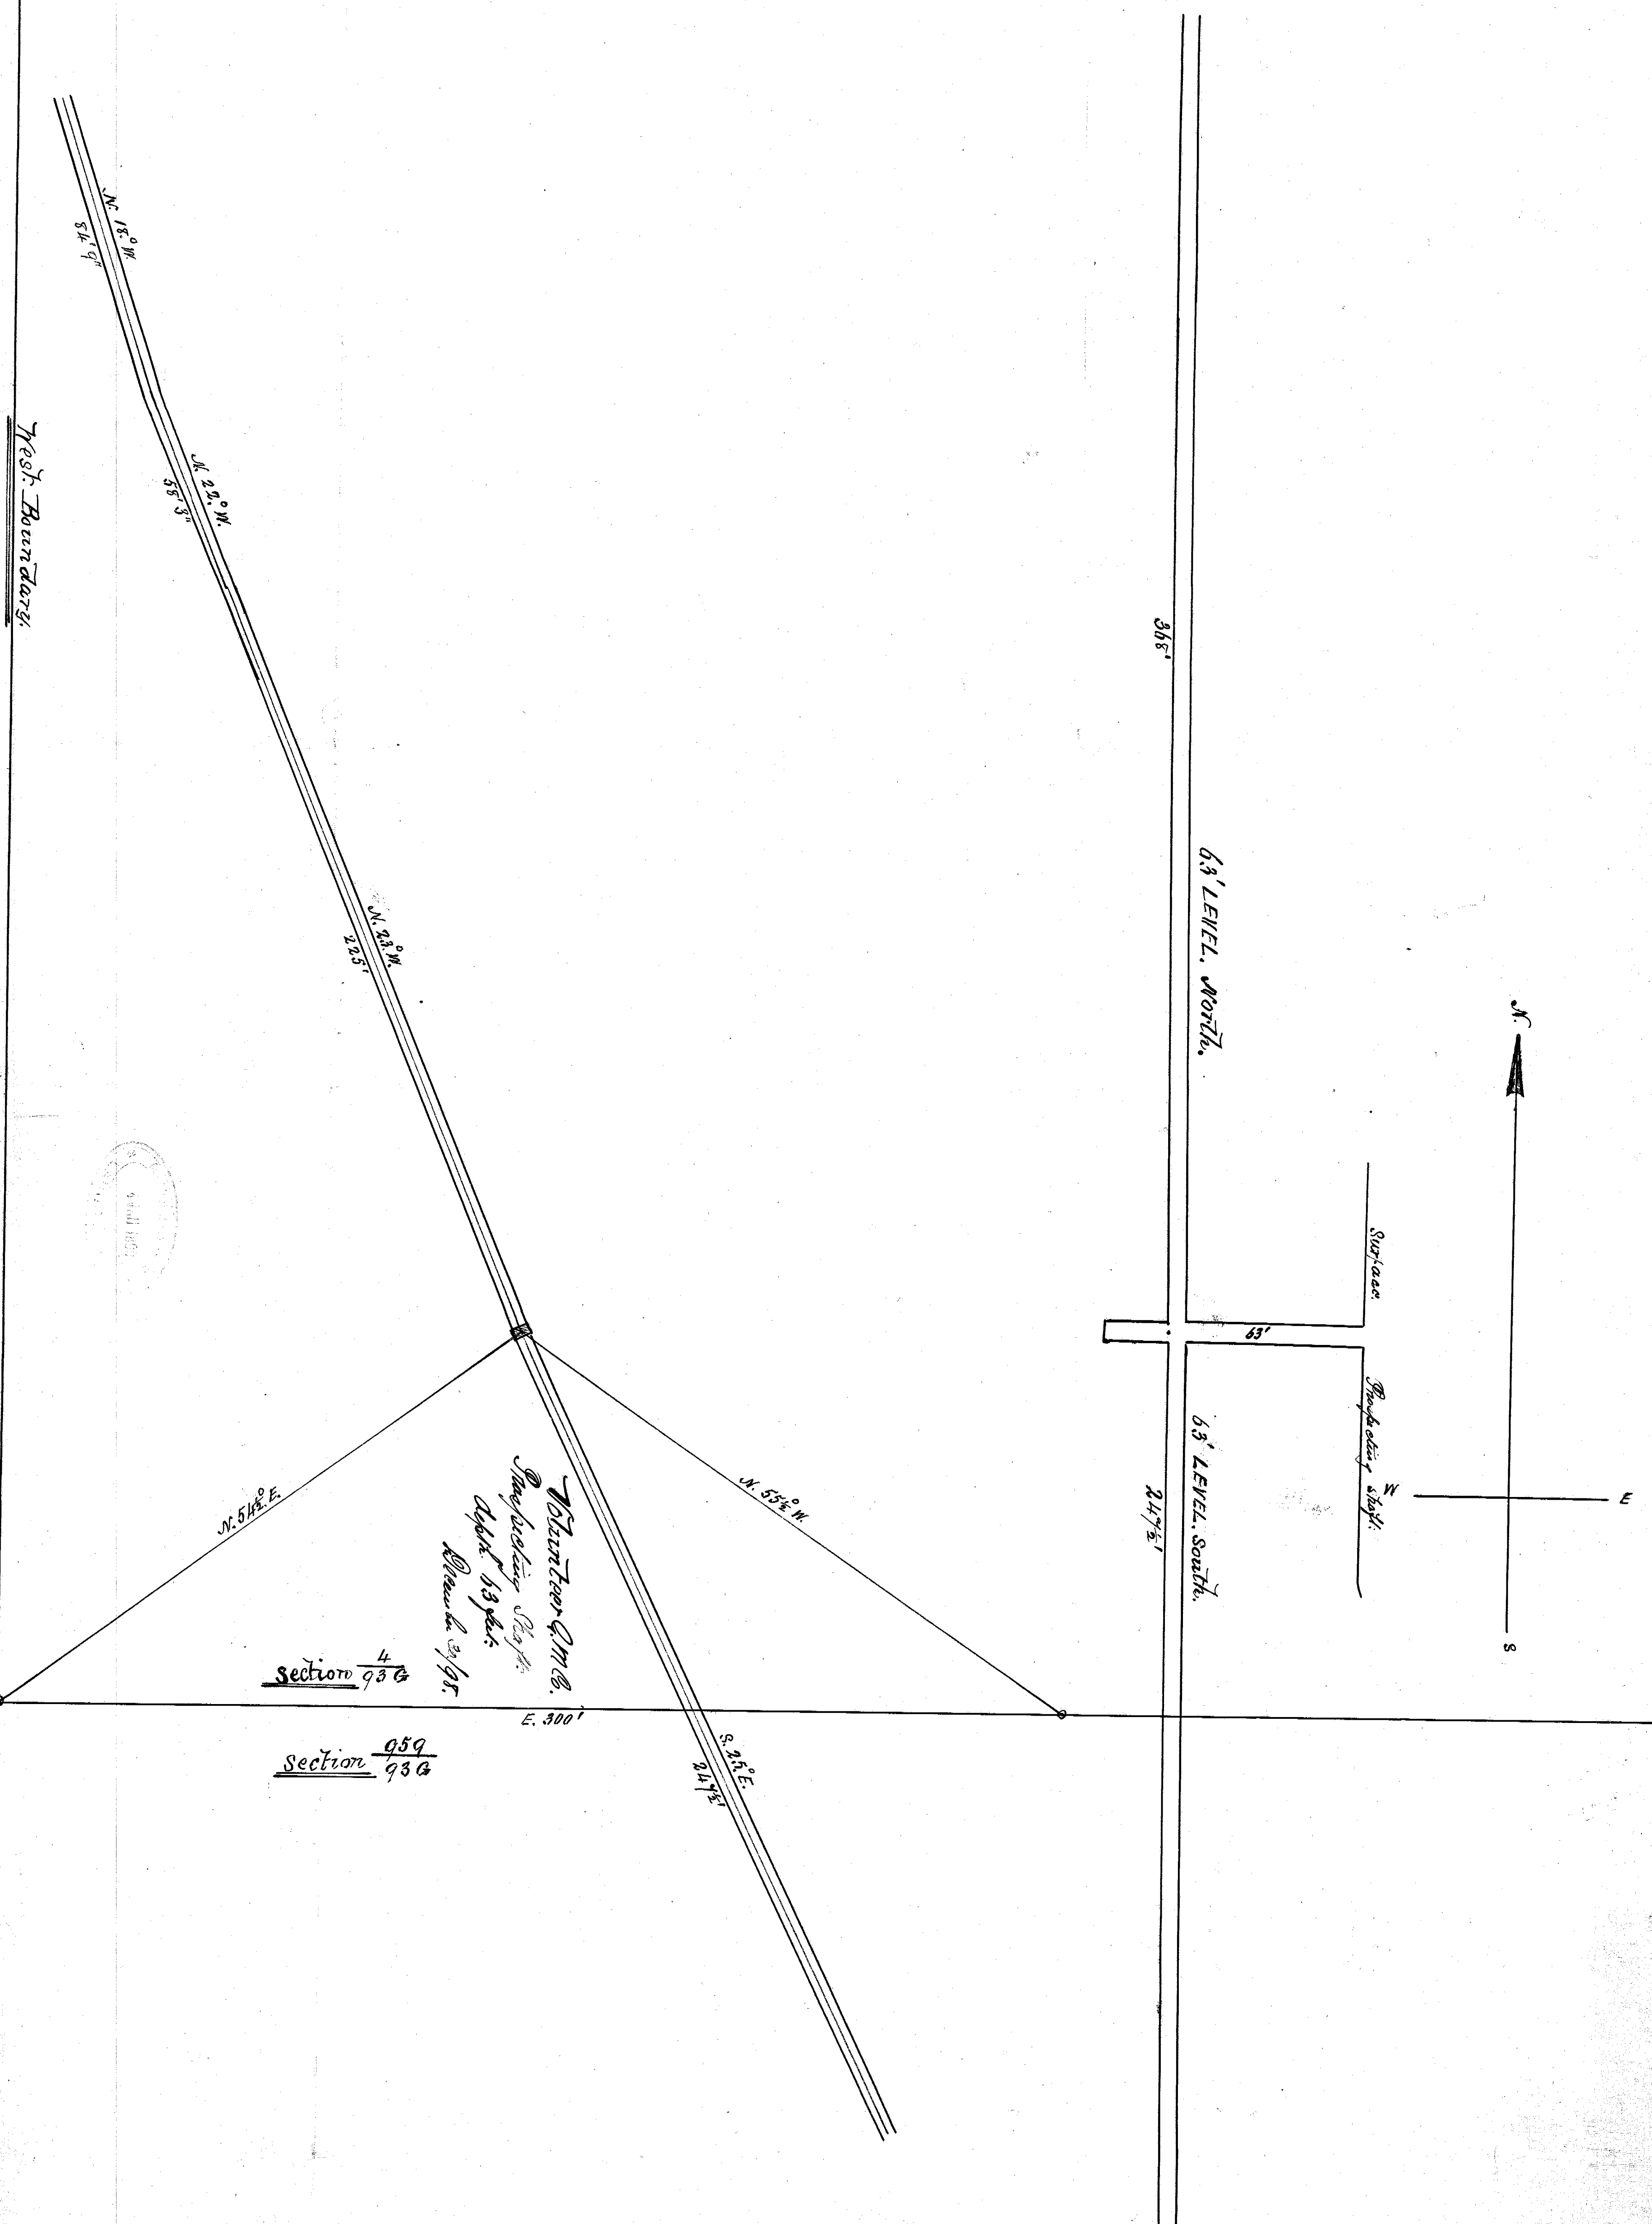

Jan 1833
Kempster & M.