

281


Volunteer Consolidated Mine

S N

Sections

Scale 1 in = 25 ft

E W

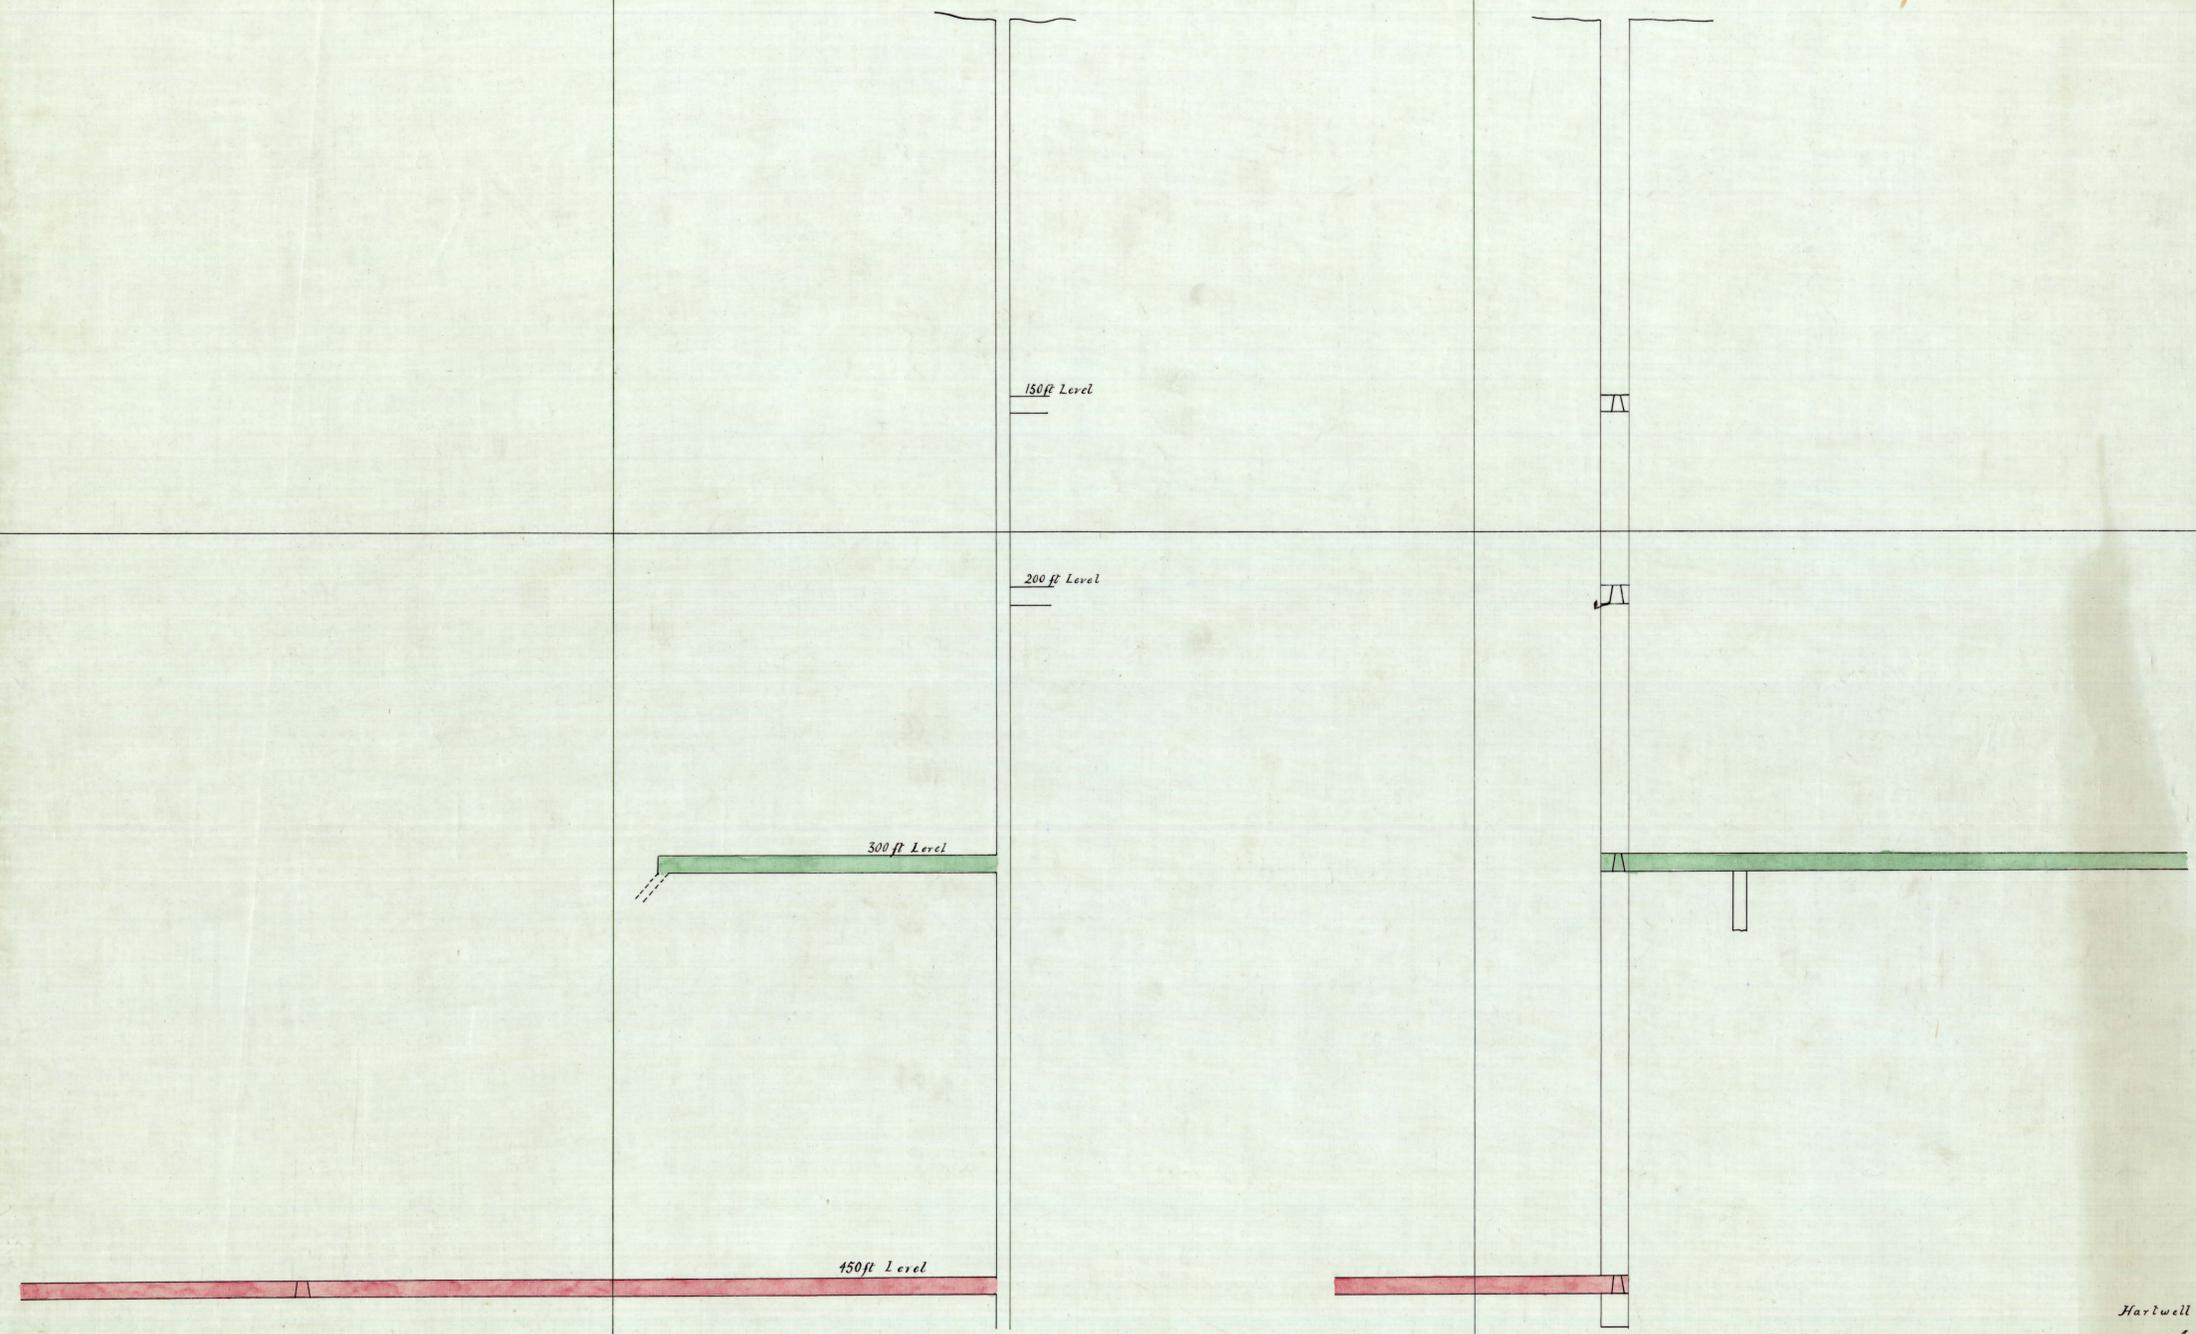

Harwell Conder
Aug 1903



Volunteer Consolidated Mine

1903

312