


Volunteer Consolidated Mine

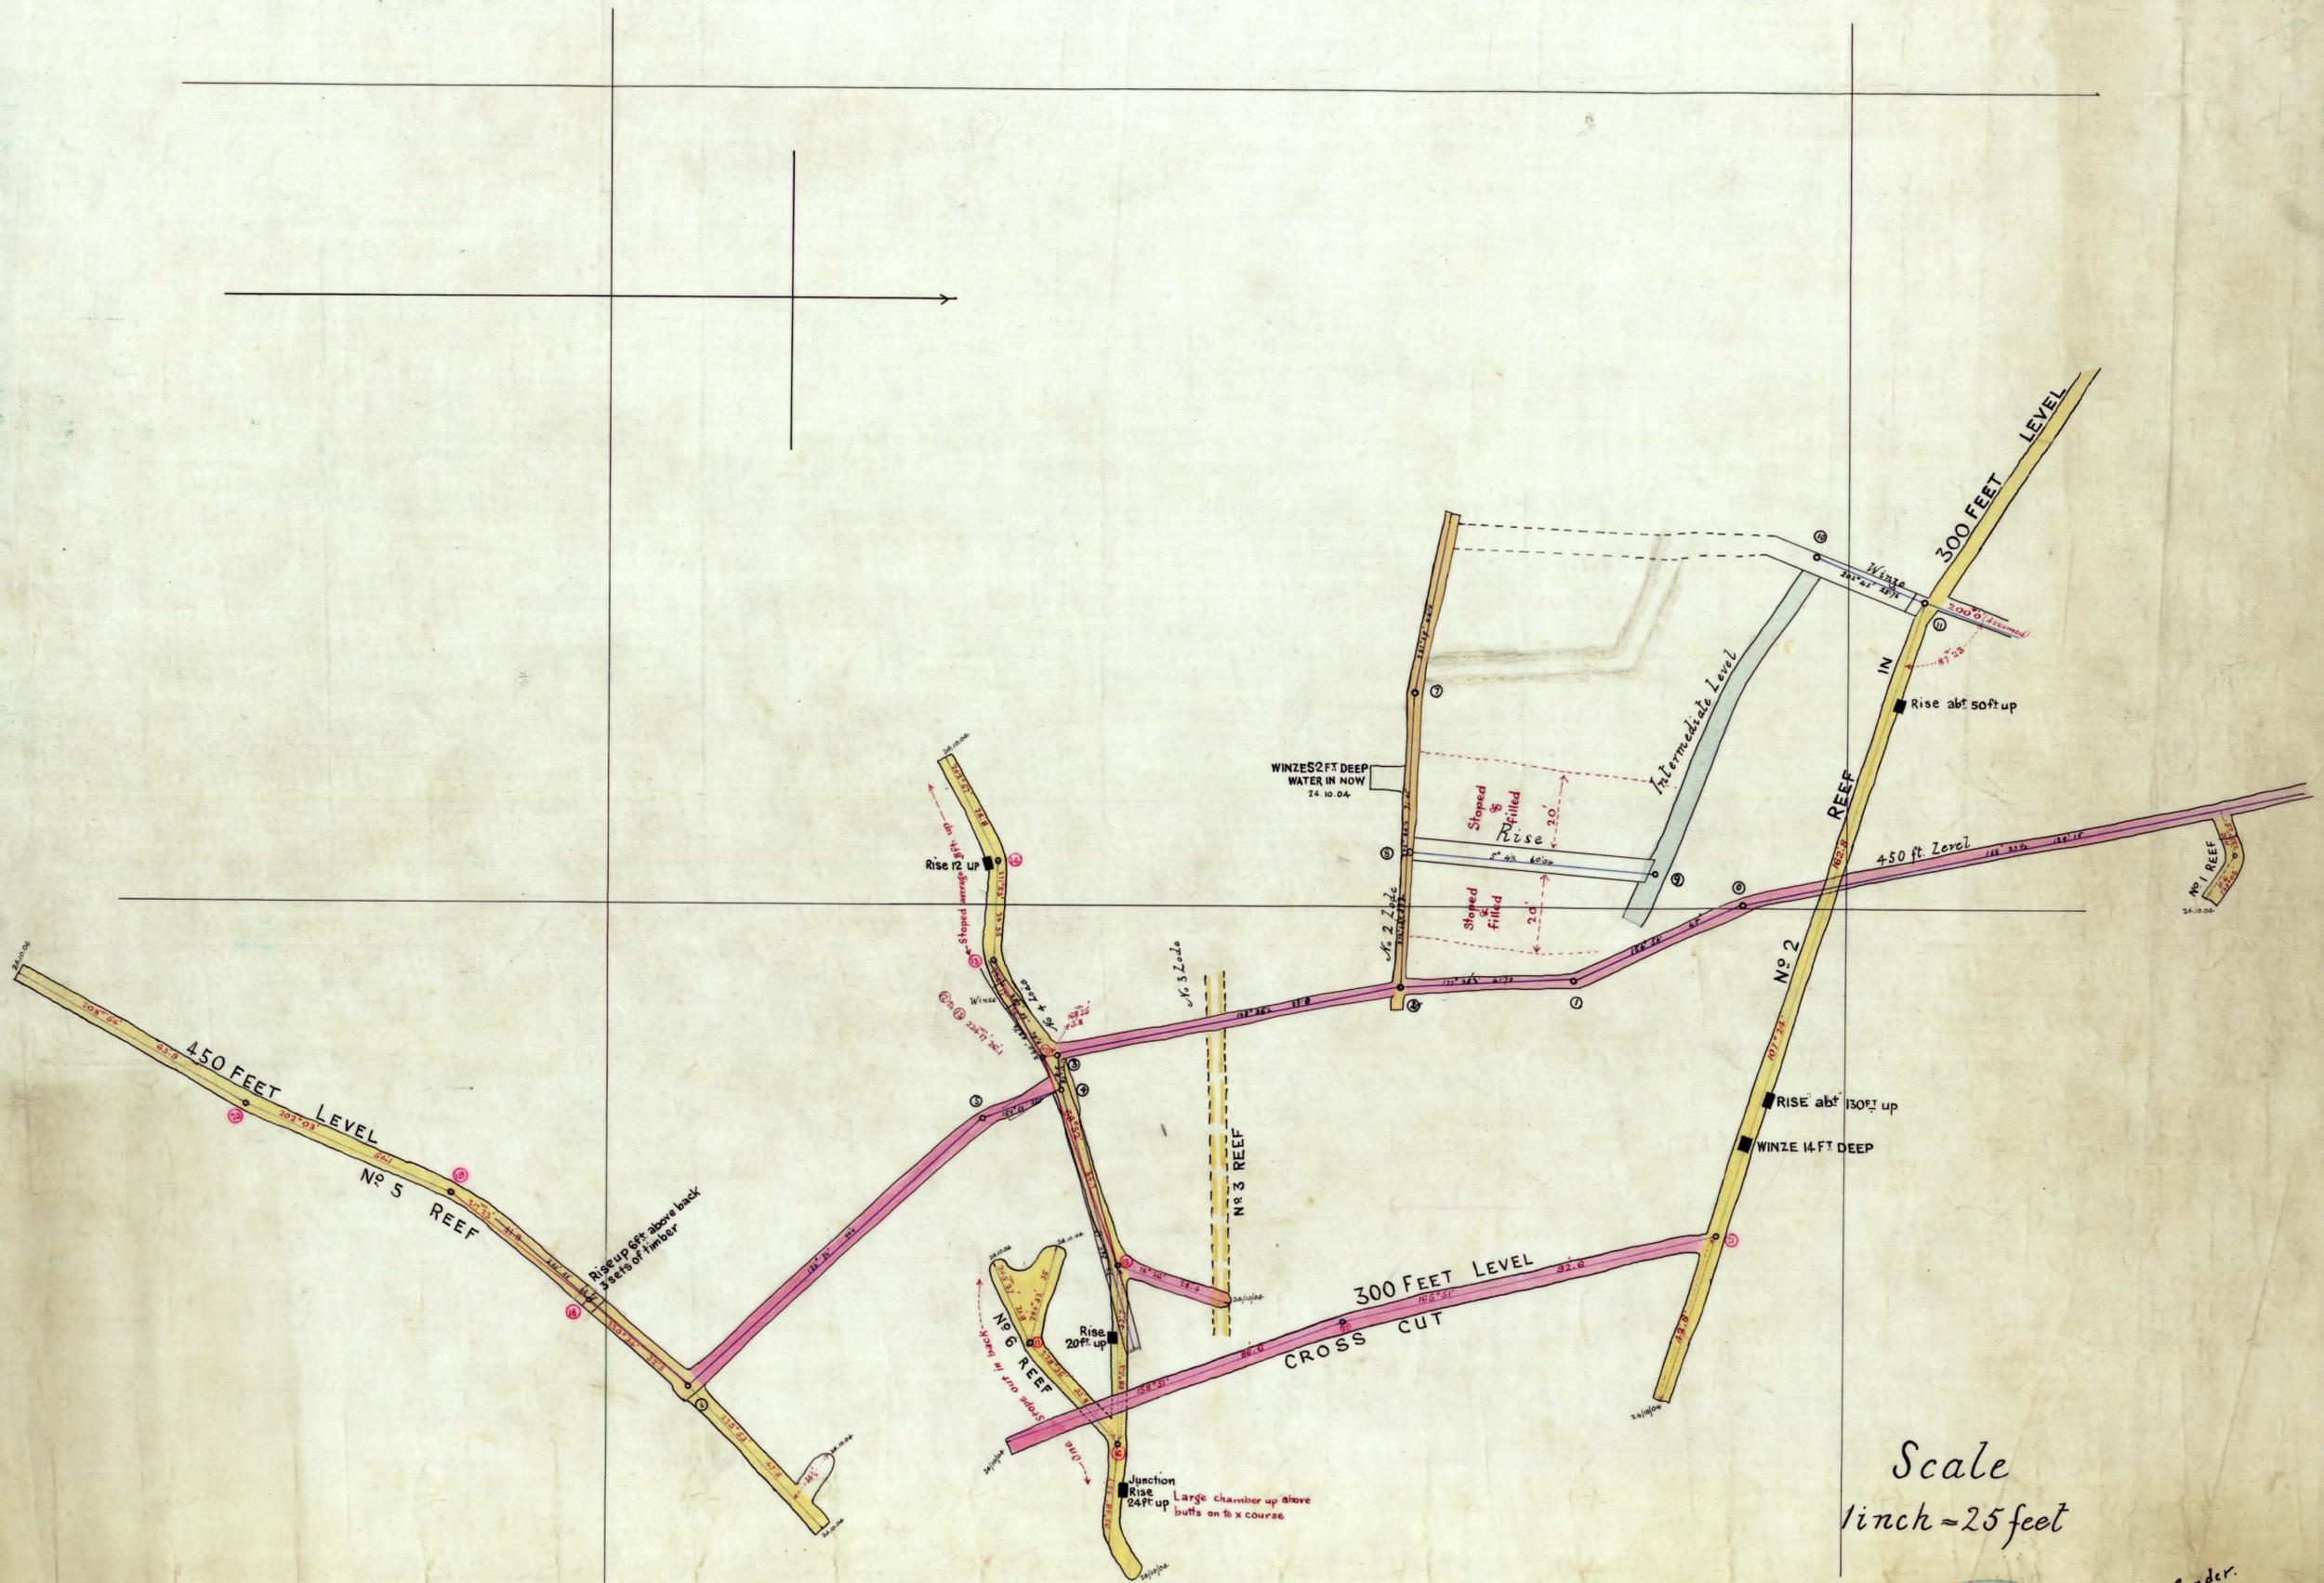

Scale
1 inch = 25 feet

Added to 24/10/04
Scherkodie
24/11/04



Hartwell Conder.
9/4/04



319
17