


24/10/04 underlies to Right

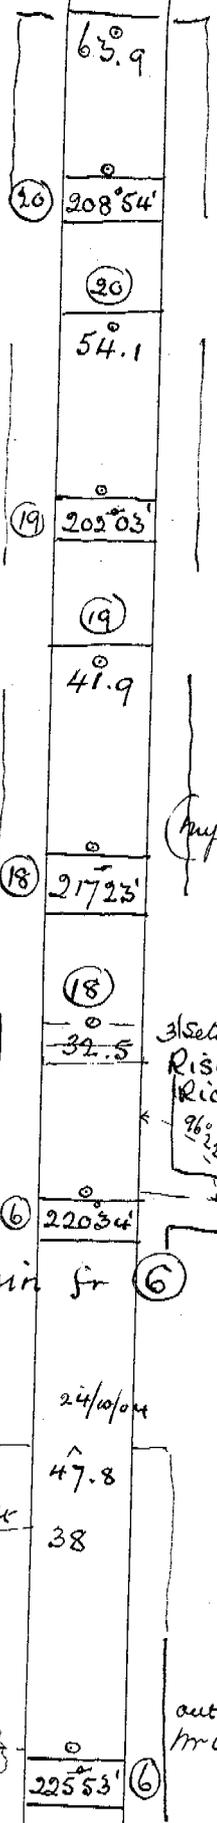

(my needle 217°54')

3 sets tricker back  
Rise up 6' above  
Rich pocket  
76°22'

316°56'

again fr (6)


136°56'  
Mr Cauder

now  
out. new plug put in  
Mr Cauder's plug

From Mr Cauder's (6) No 5 Reef


End 450ft Level

x cut

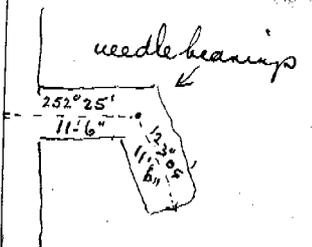

No 1 Reef in 450ft LEVEL

x cut

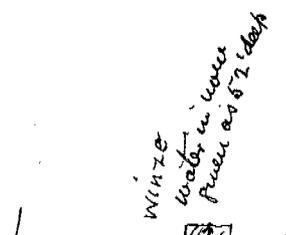

450ft LEVEL

Winze in No 2 Reef west