

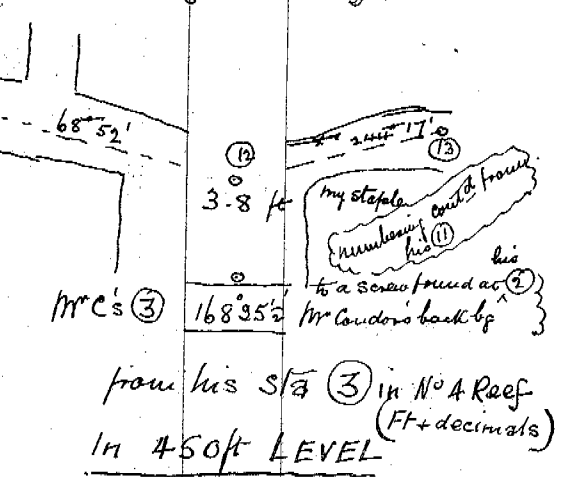
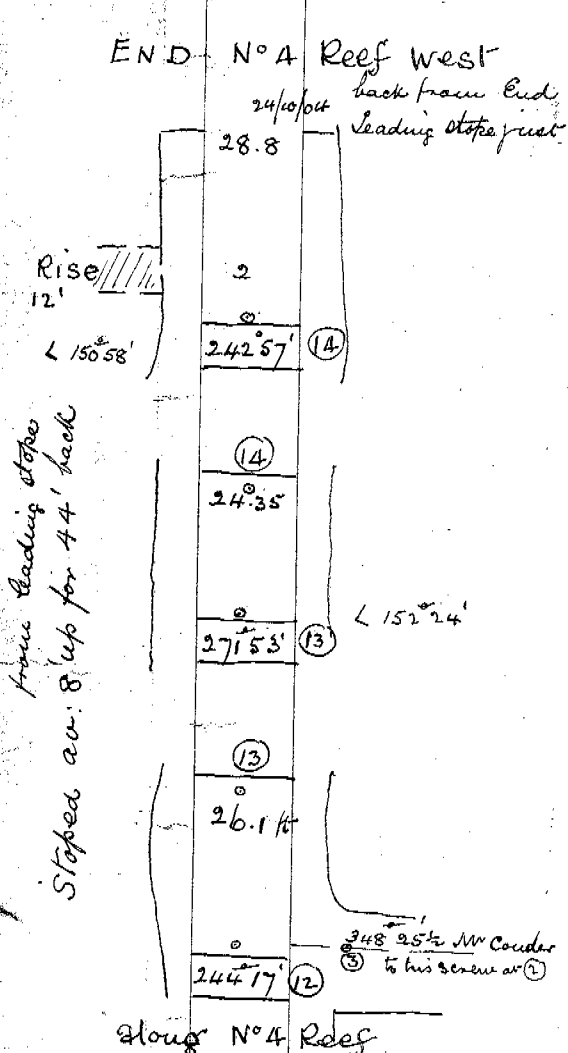
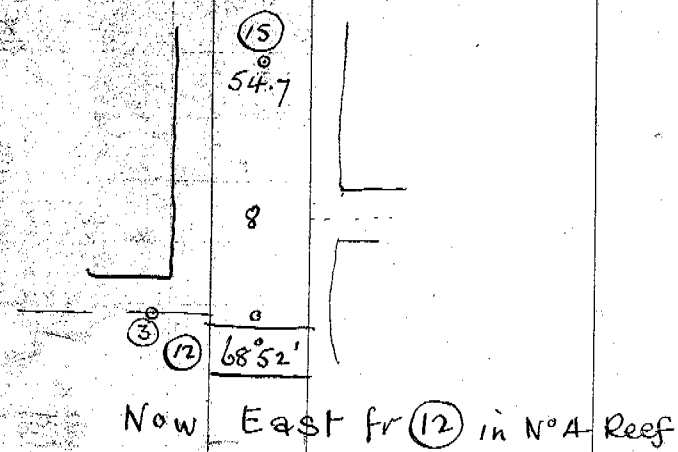
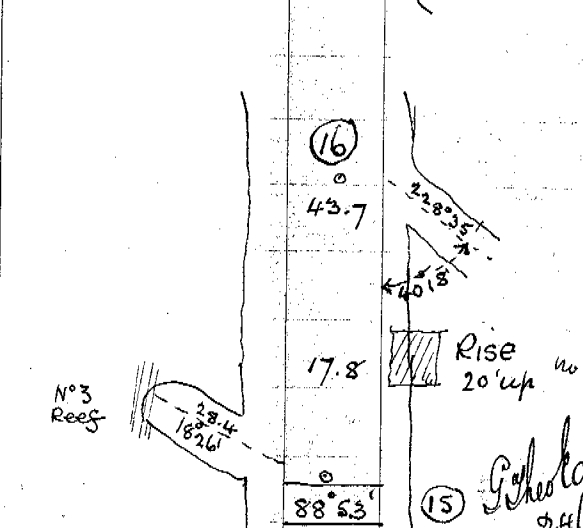


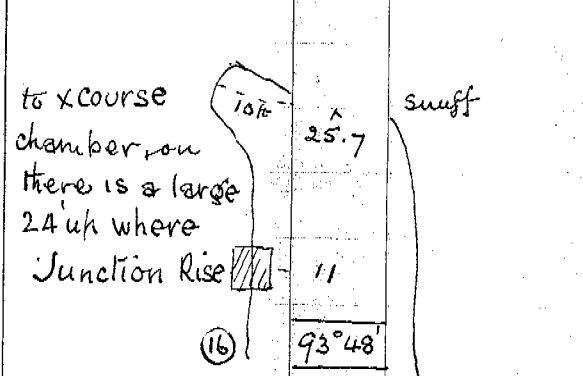

by Mr Hartwell Couder and continued from his marks
Field notes of survey by me 24/10/04 in continuation of survey
The Volunteer Consolidated Gold Mine, at Mathinna

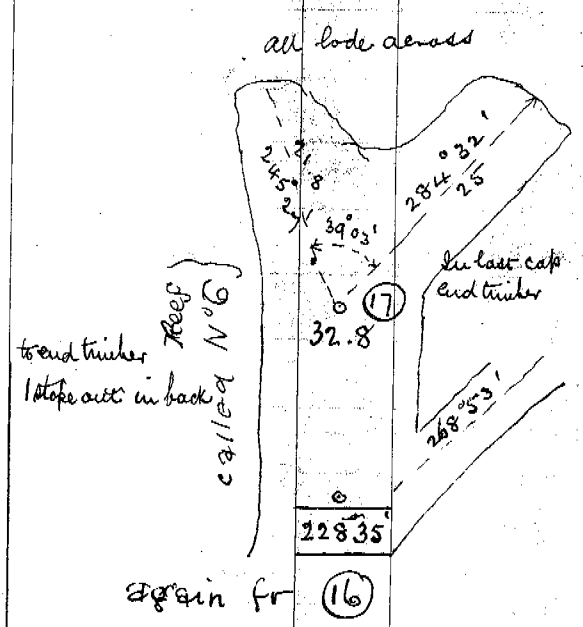

by Mr Hartwell Couder and continued from his marks
Field notes of survey by me 24/10/04 in continuation of survey
The Volunteer Consolidated Gold Mine, at Mathinna