


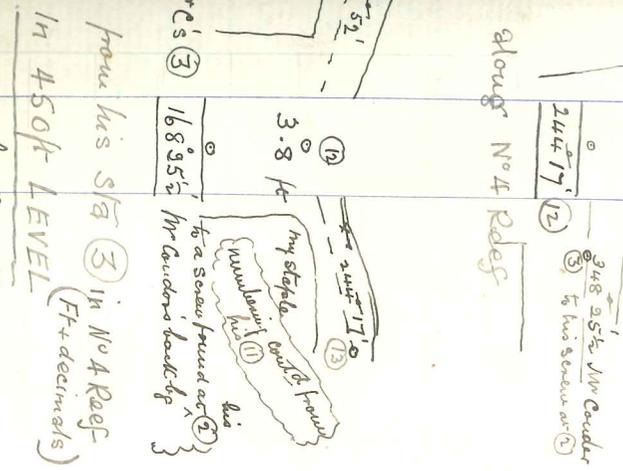


from leading steps  
Stoped av: 8' up for 44' back

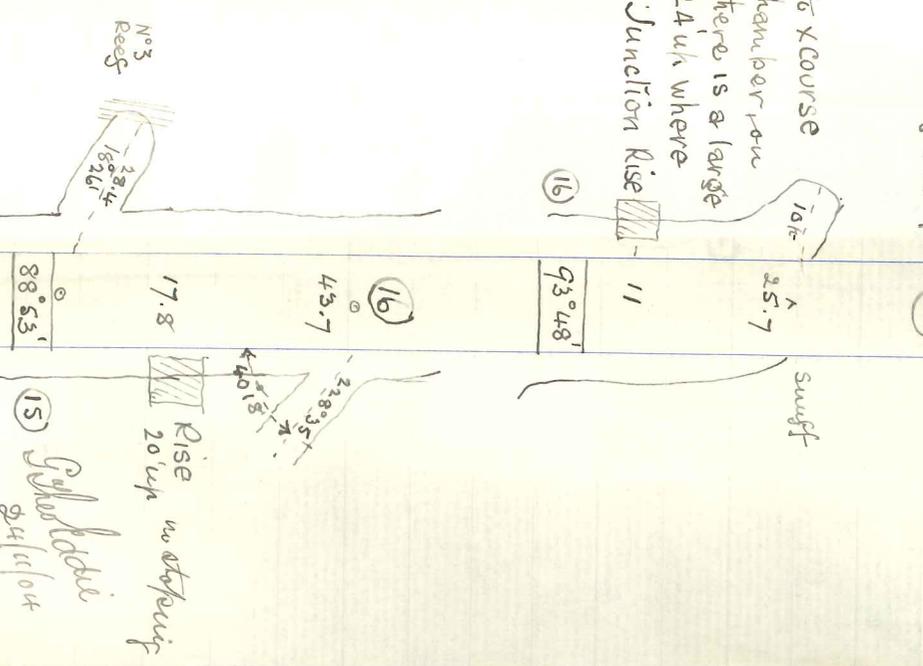


by Mr Startwell Cauder and continued from his marks  
Tada notes of survey by me 24/10/04 in continuation of survey  
The Structures Calculated Sals Nive, at Mathurina

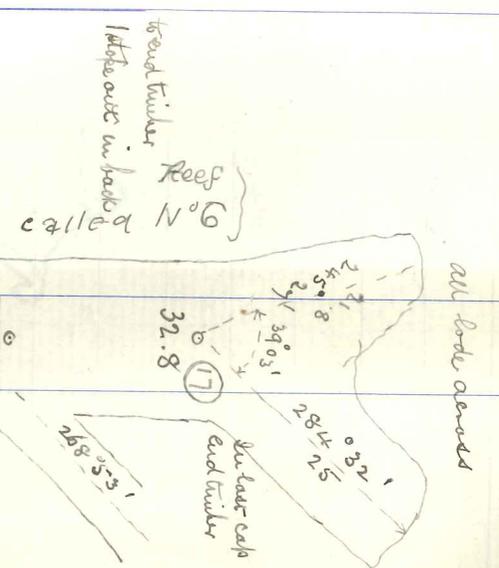


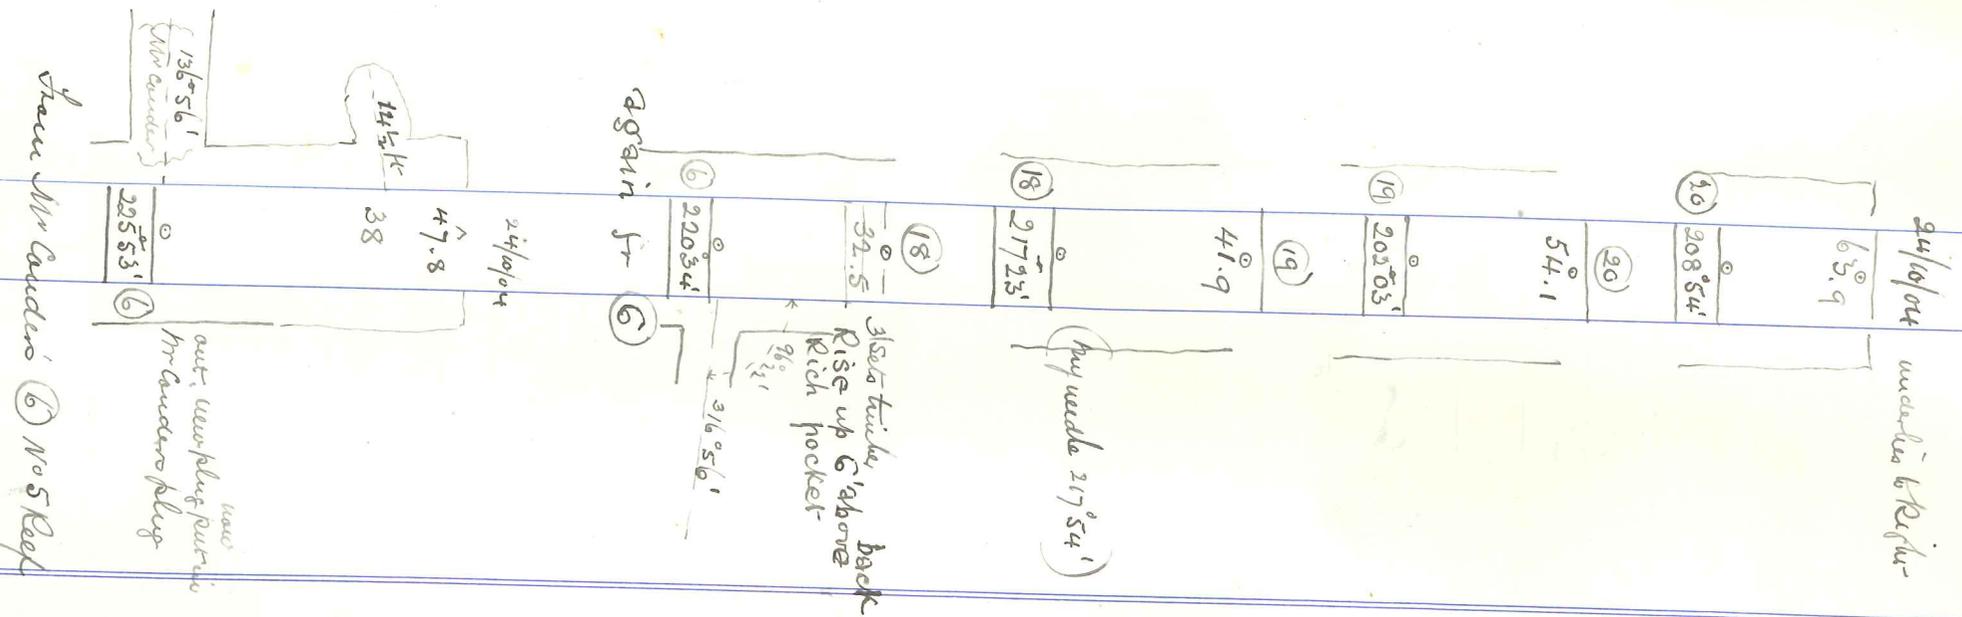

End 450+ Level

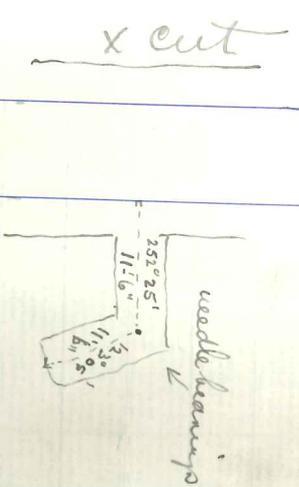

No 1 Reef in 450+ LEVEL

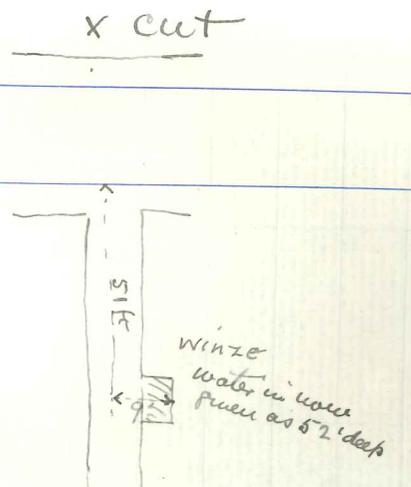

450+ LEVEL  
Winze in No 2 Reef west

the level

24/10/04

86.6

L173

158.51' (22)

(22)

92.6

needle 166°30'

(21)

165.51'

287°24'

24/10/04

42.8

162.7 (21)

165.51'

Witze alt 14' deep  
screw

139.3

127

Rise alt 130ft

25.7

Rise about 50' (guess) 17'

with Cauder's (11) which is identical

Witze

107.24' (11)

From Mr Cauder's (11)

14 300ft Level

