

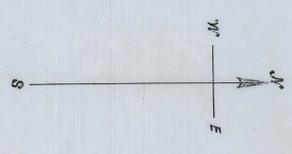
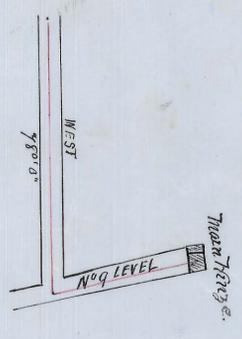


1001/1011
pp87-7

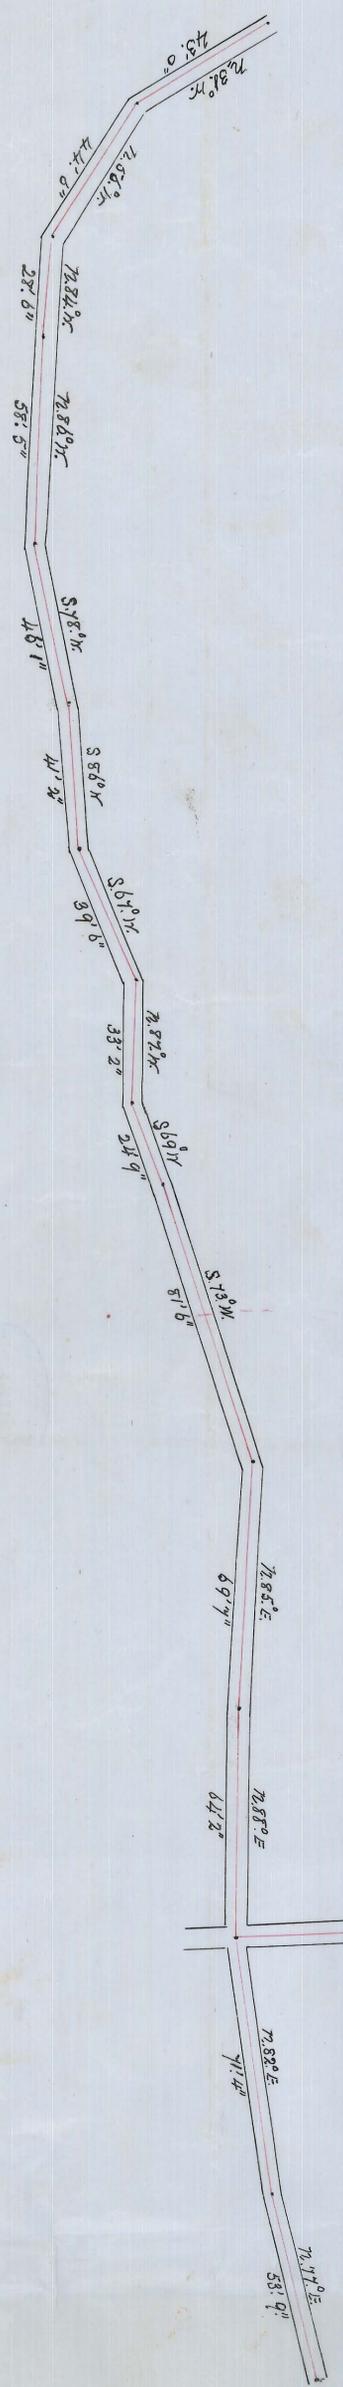

Wm. G. M. Co.
 No. 10. Level
 Resurveyed 30th 11/19 S.

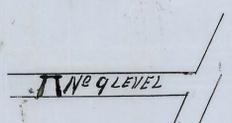

Vertical depth from
 surface 1250.5'
 on the centerline 1300'-0"
 From Centre Place
 Shaft to Centre Main
 Piece 334'-6" South.

