


West Pinafore C. M.

Scale 25ft. to an inch.

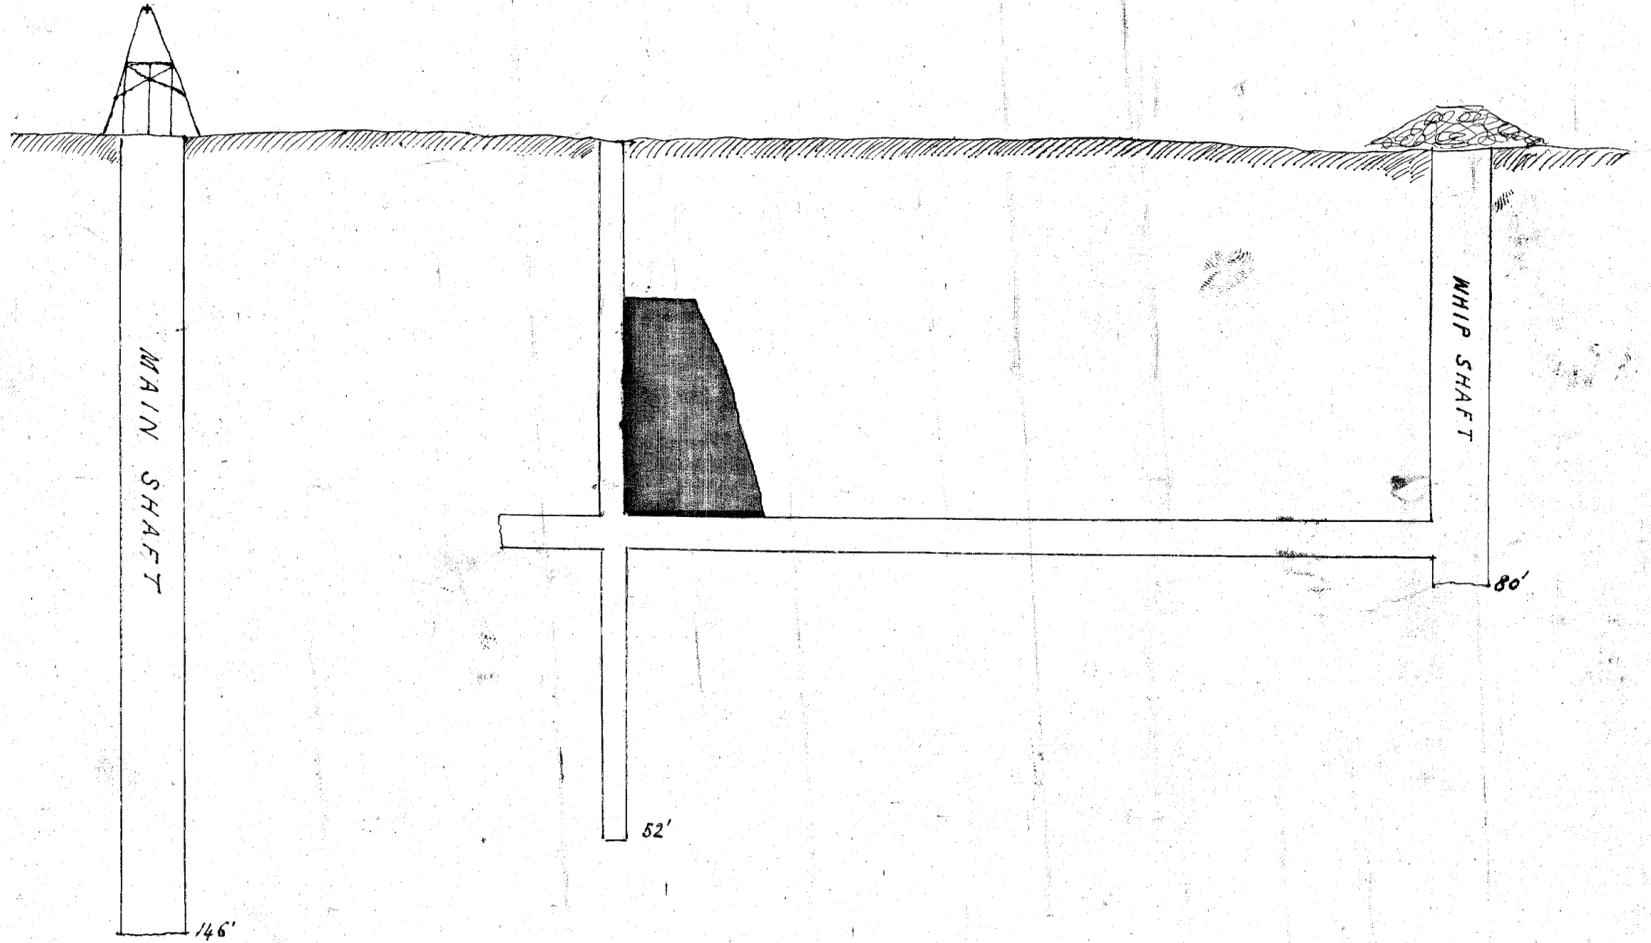

330
01

INSPECTOR OF MINES
9th July
1893
LAUNCESTON

Verified correct against
Plan in Manager's office
C. Bailey Watson
15/1/92