



WEST EXTENDED PINAFORE CMC

—LEFROY—

PLAN

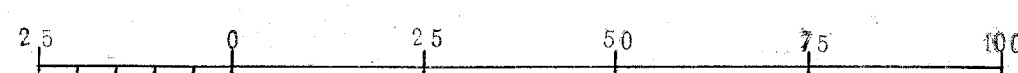

CHUMS PRO^F

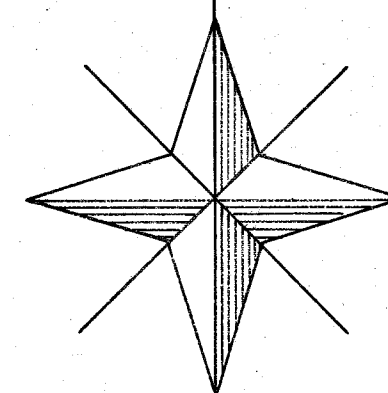

WINN SHAFT

MAIN

SHAFT

Surveyed and approved
by J. B. Richards
Lieut. Col.
Custodian of the
H. B. L. Mine
10 March 1881

WEST PINAFORE

Surveyed and approved
by J. B. Richards
Lieut. Col.
Custodian of the
H. B. L. Mine
10 March 1881

Surveyed and approved
by J. B. Richards
Lieut. Col.
Custodian of the
H. B. L. Mine
10 March 1881