



WEST PINAFORE C M C^o N L

Scale 25 feet to an inch

Longitudinal Section

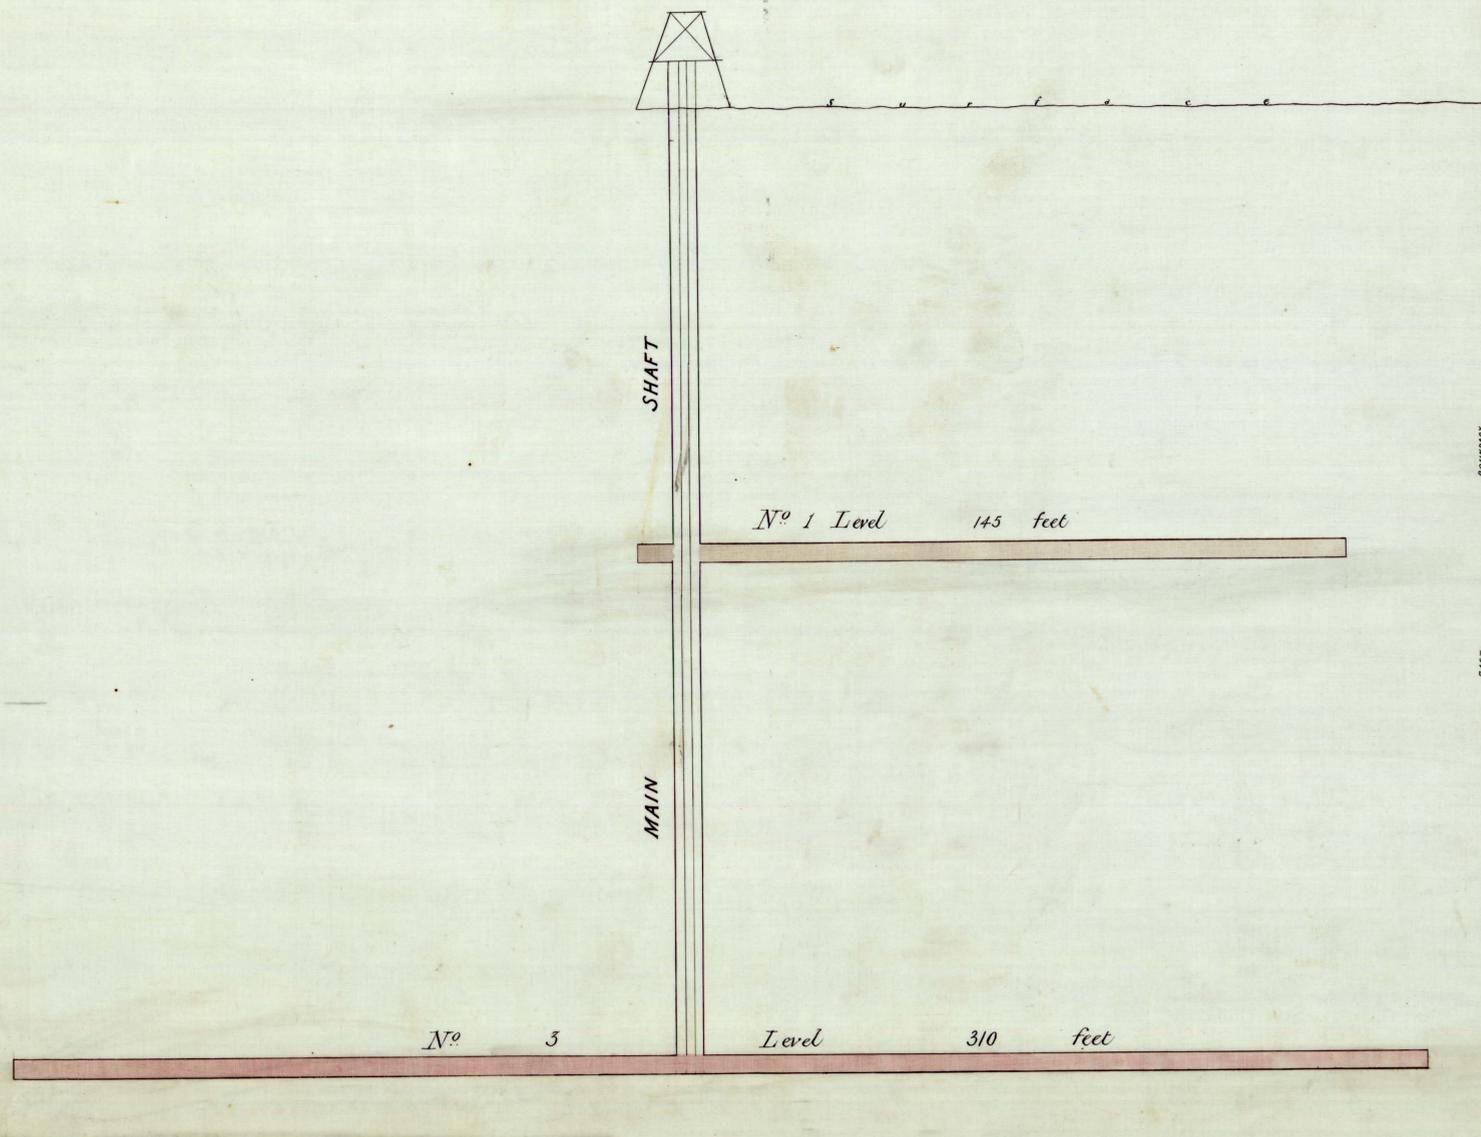

Cross Section

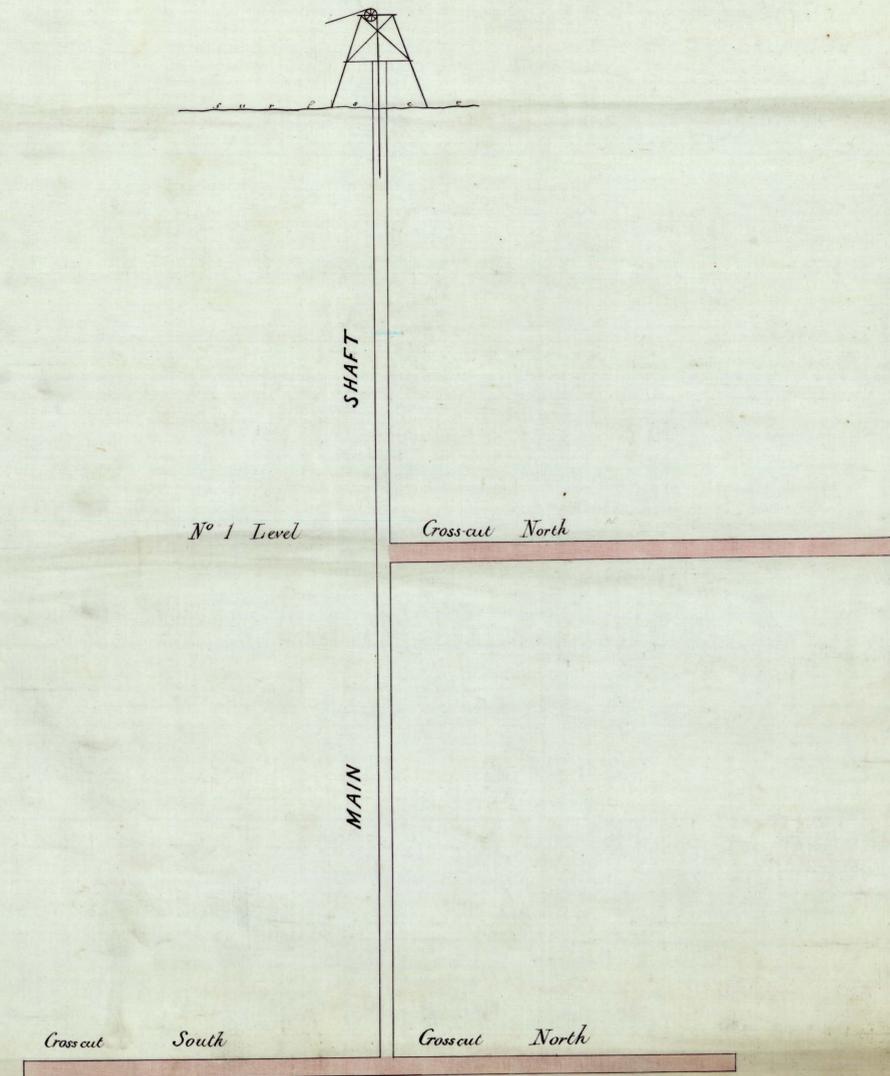

Correct copy of Plan to 25/1/95

25 April 1895

W. P. Tilden
Authorized Surveyor
11/19/95