


21 West Pinarofre G.M. Co.

West Pinarofre G.M. Co. To Lico


Lefroy

Scale 25 feet to an inch

Longitudinal Plan

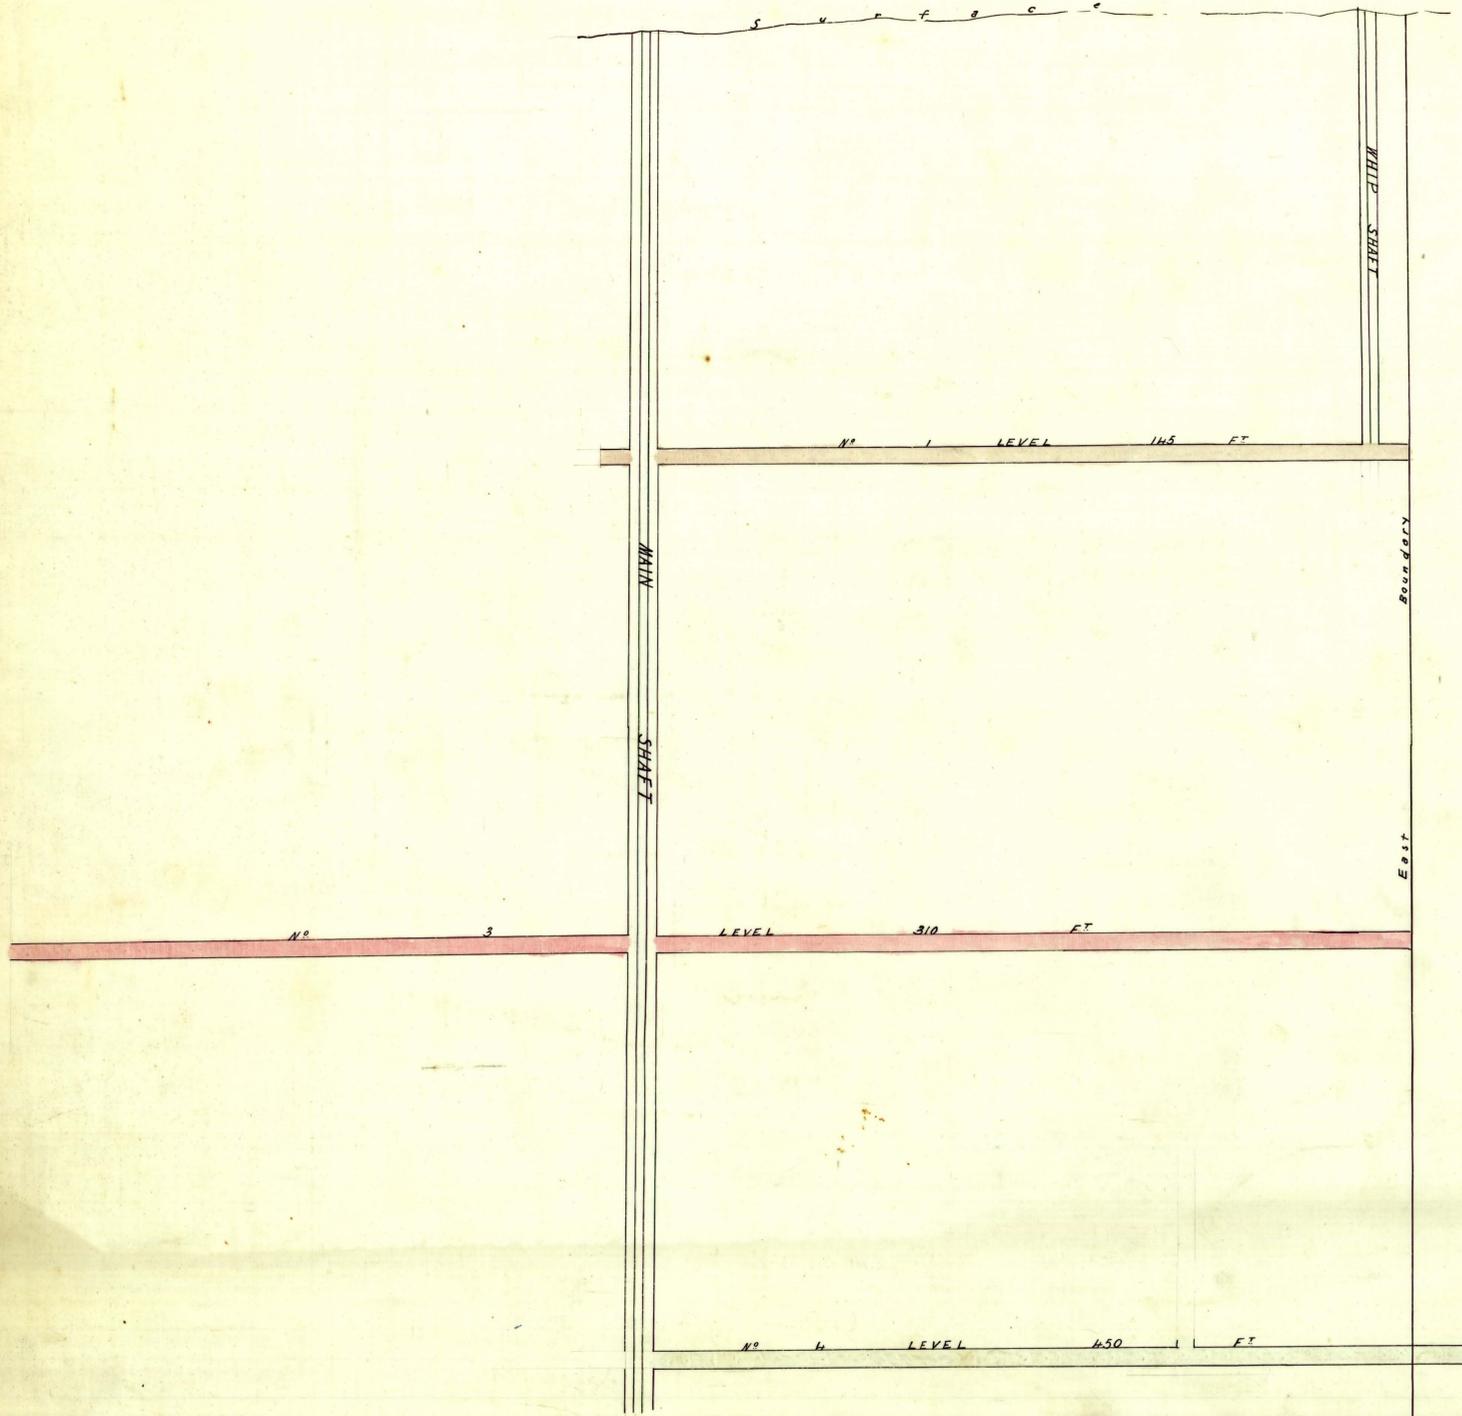

Ground Plan

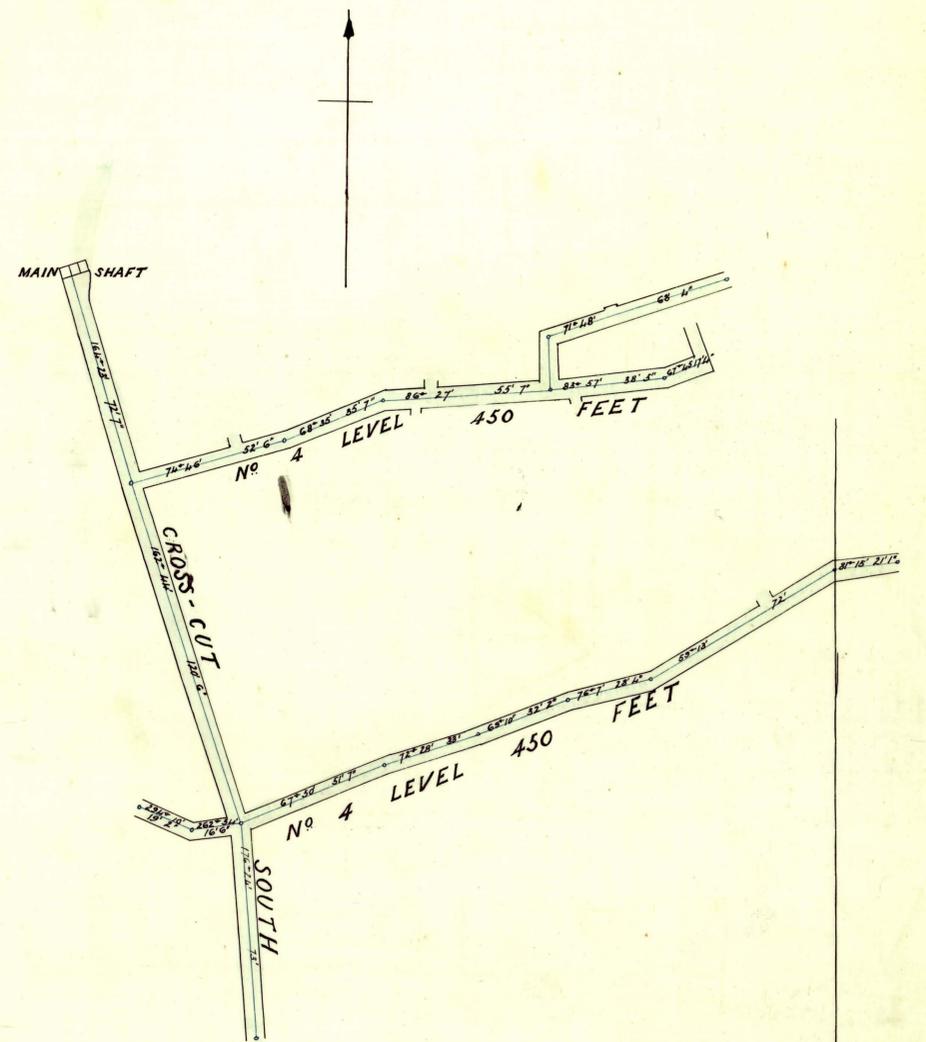

APPROVED BY THE STATE
JAN 19 1907

M. A. Pilsa
Assistant Engineer
Jan. 1907