




43

43

TRANSVERSE SECTION LOOKING WEST

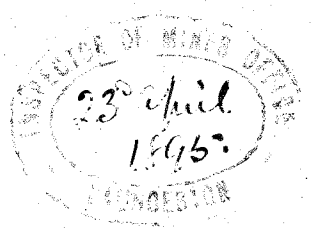

C

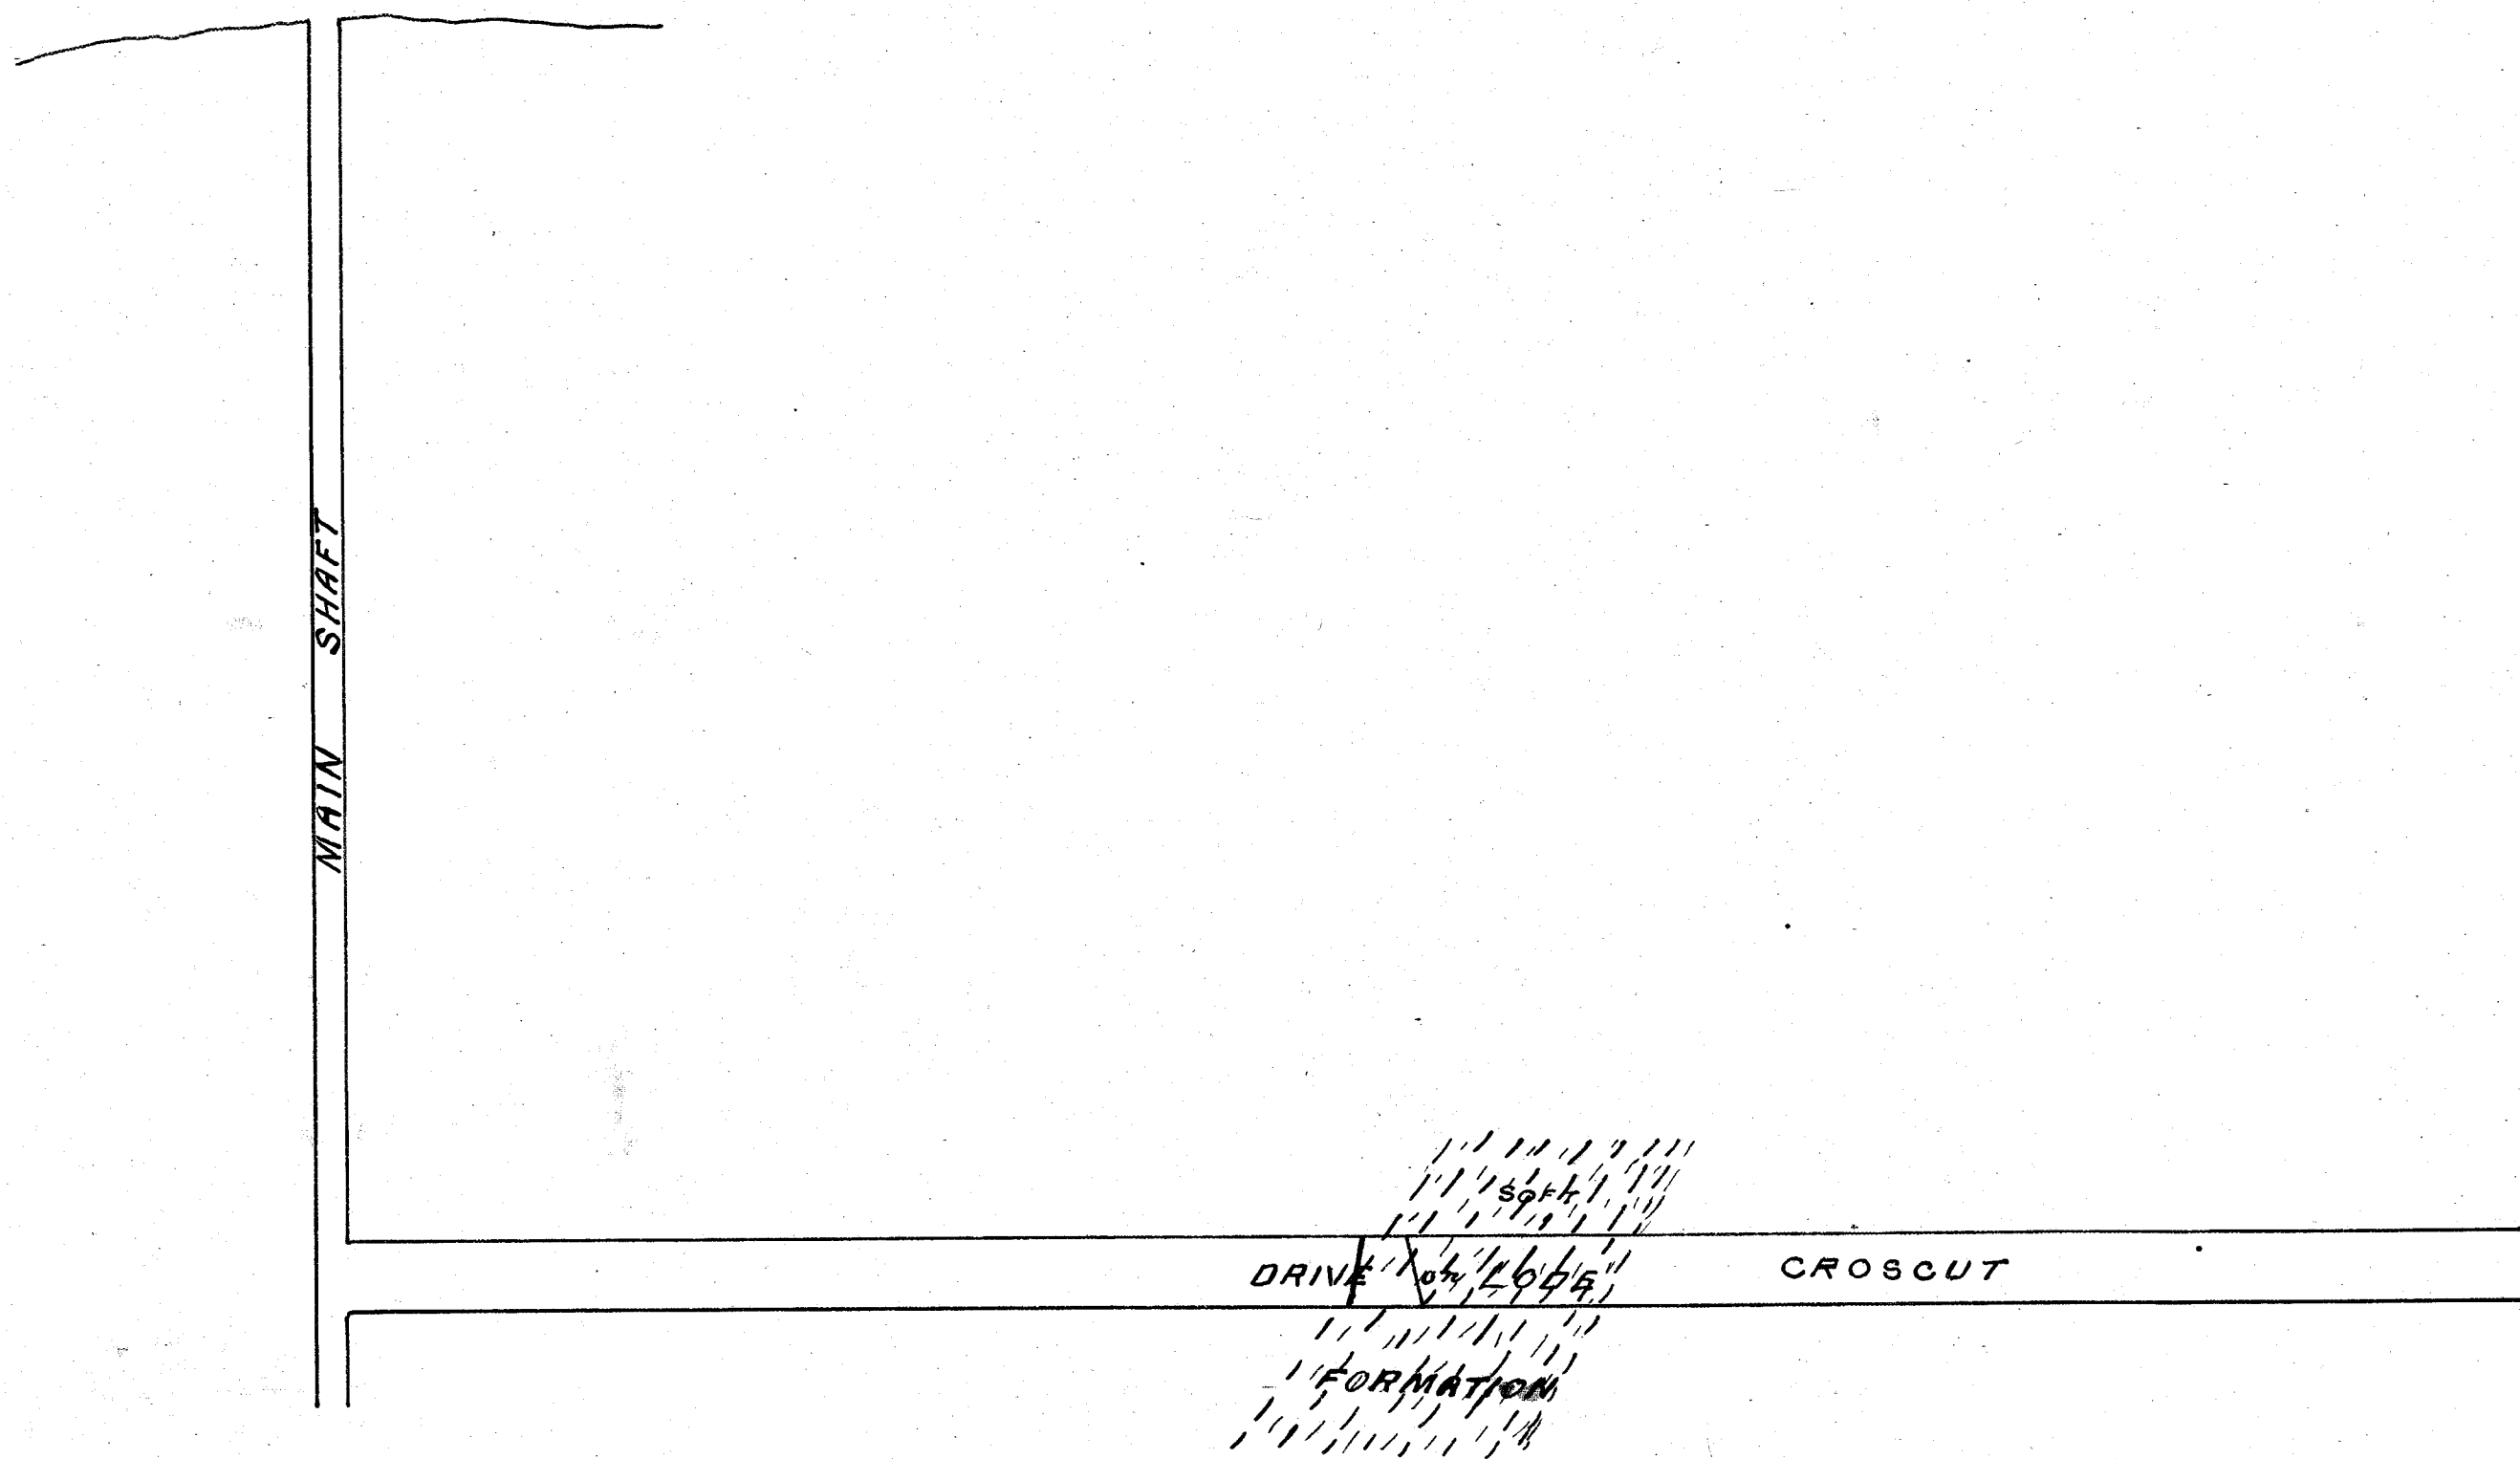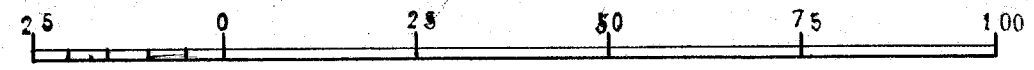

CHUMS PROP

43

43

*Surveyed and drawn by
S. E. Richards
18th March 1895*