


320
89


WEST PINAFORE G.M.C.^o NO LIA

LEFROY

Scale 25 feet to an inch

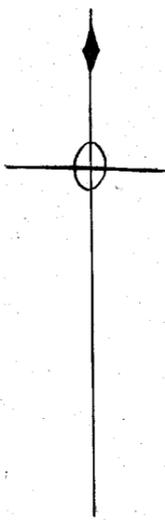

Boundary

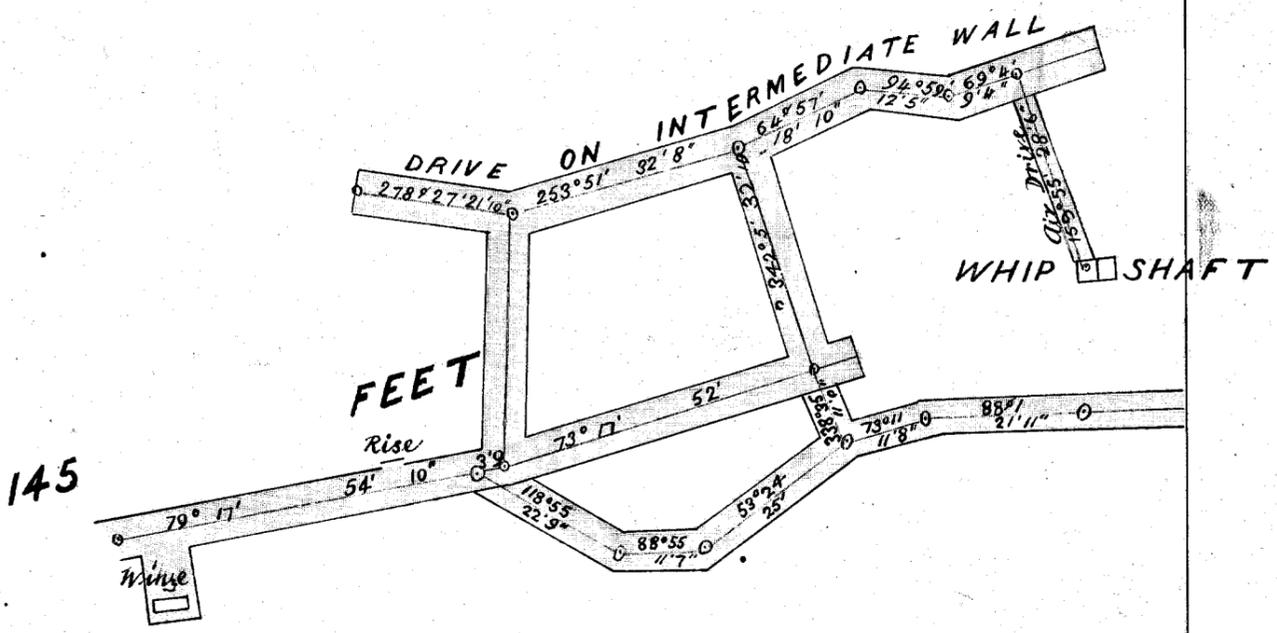

Eastern

STATE OF MISSISSIPPI
30th heard
1896.

W. J. Miles,
Surveyor
Lefroy
Jan'y '96