

320

10.


West Pinafore G M C^o NO LIA

Lefroy

Scale 25 feet to an inch

Longitudinal Section

Surface

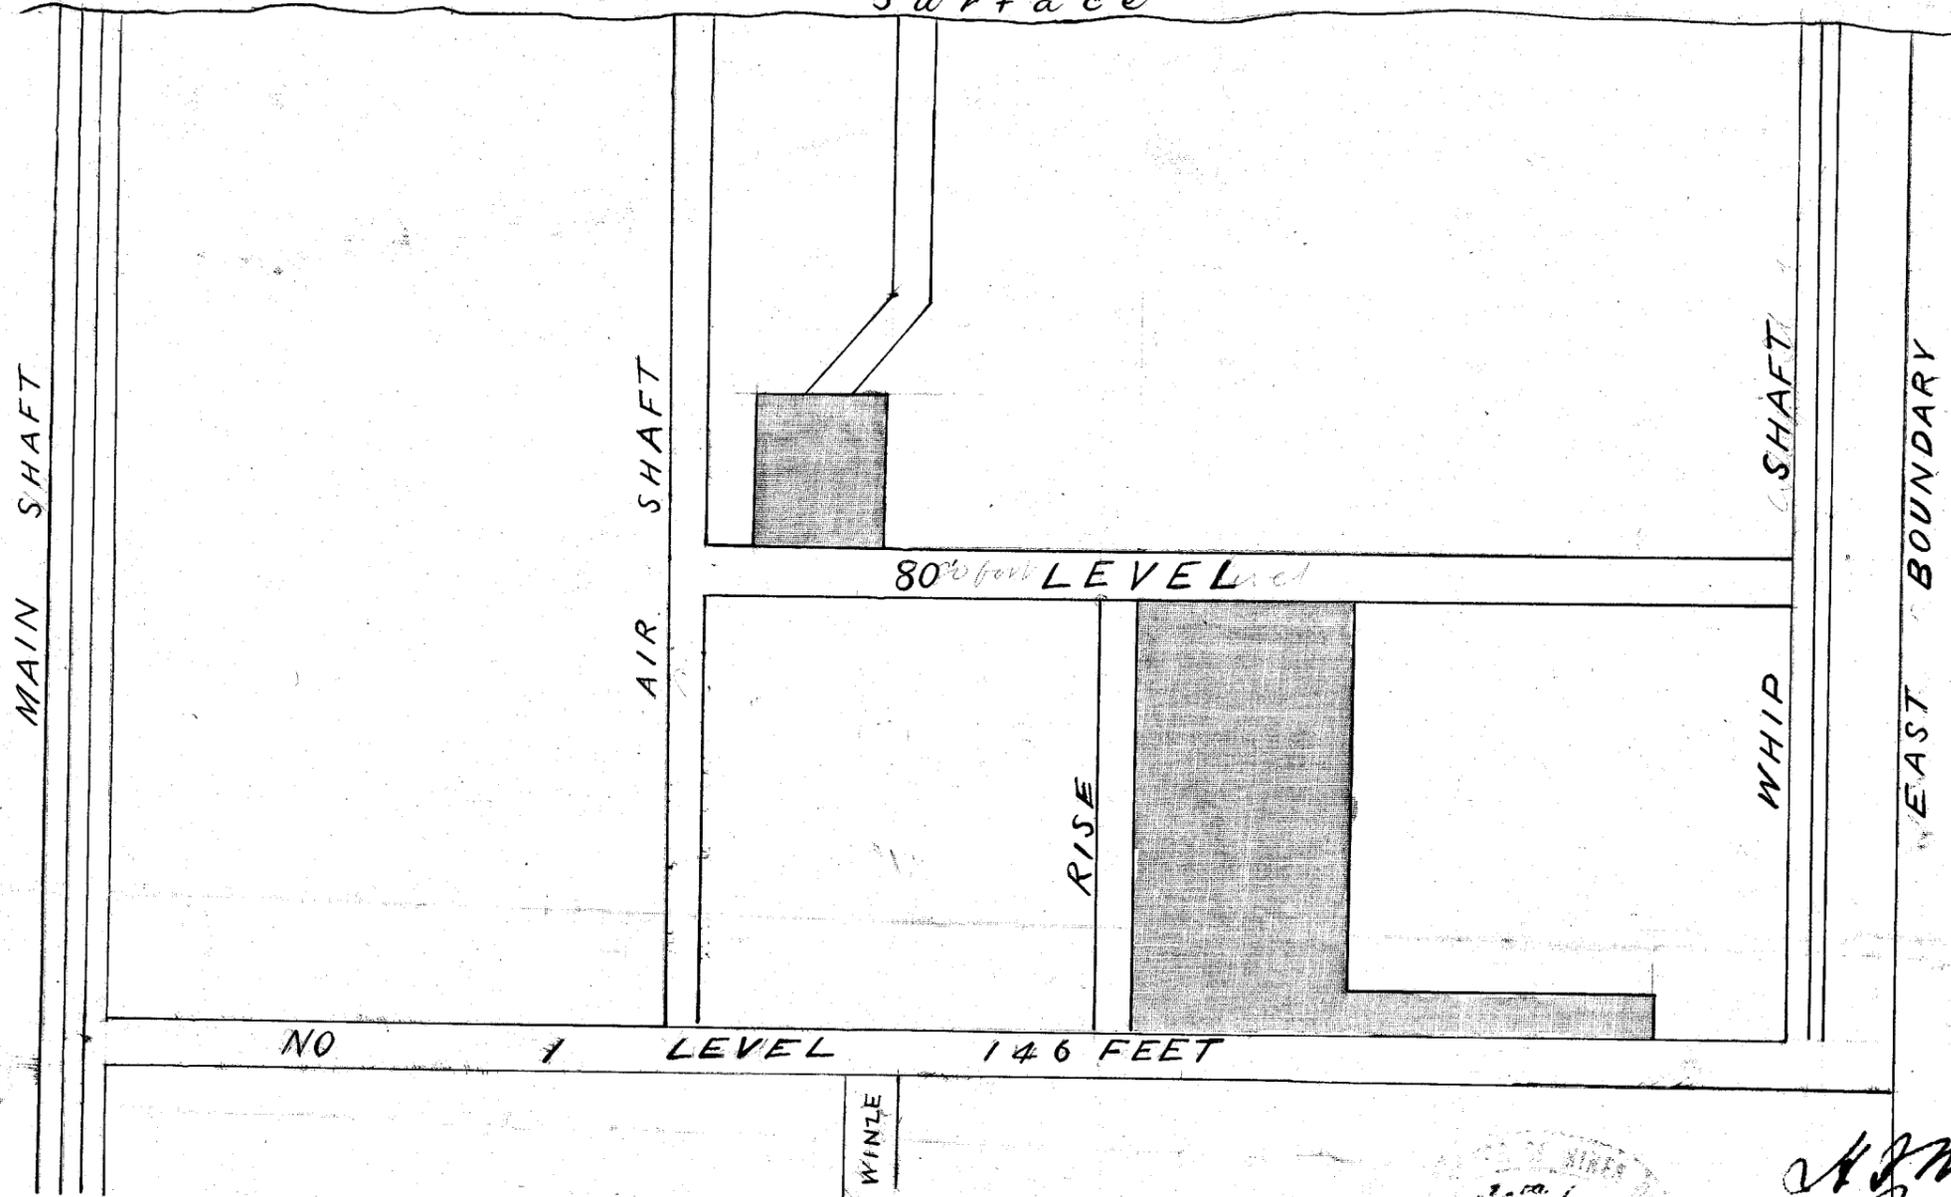

30° heads
 1896.

H. J. Miles
 Surveyor
 Lefroy
 Jan 1896