


# WEST PINAFORE C.M.

Scale 25 ft to an inch



*Believed correct copy of  
plan in Manager's office  
C. Brough Waterhouse  
15/1/92*

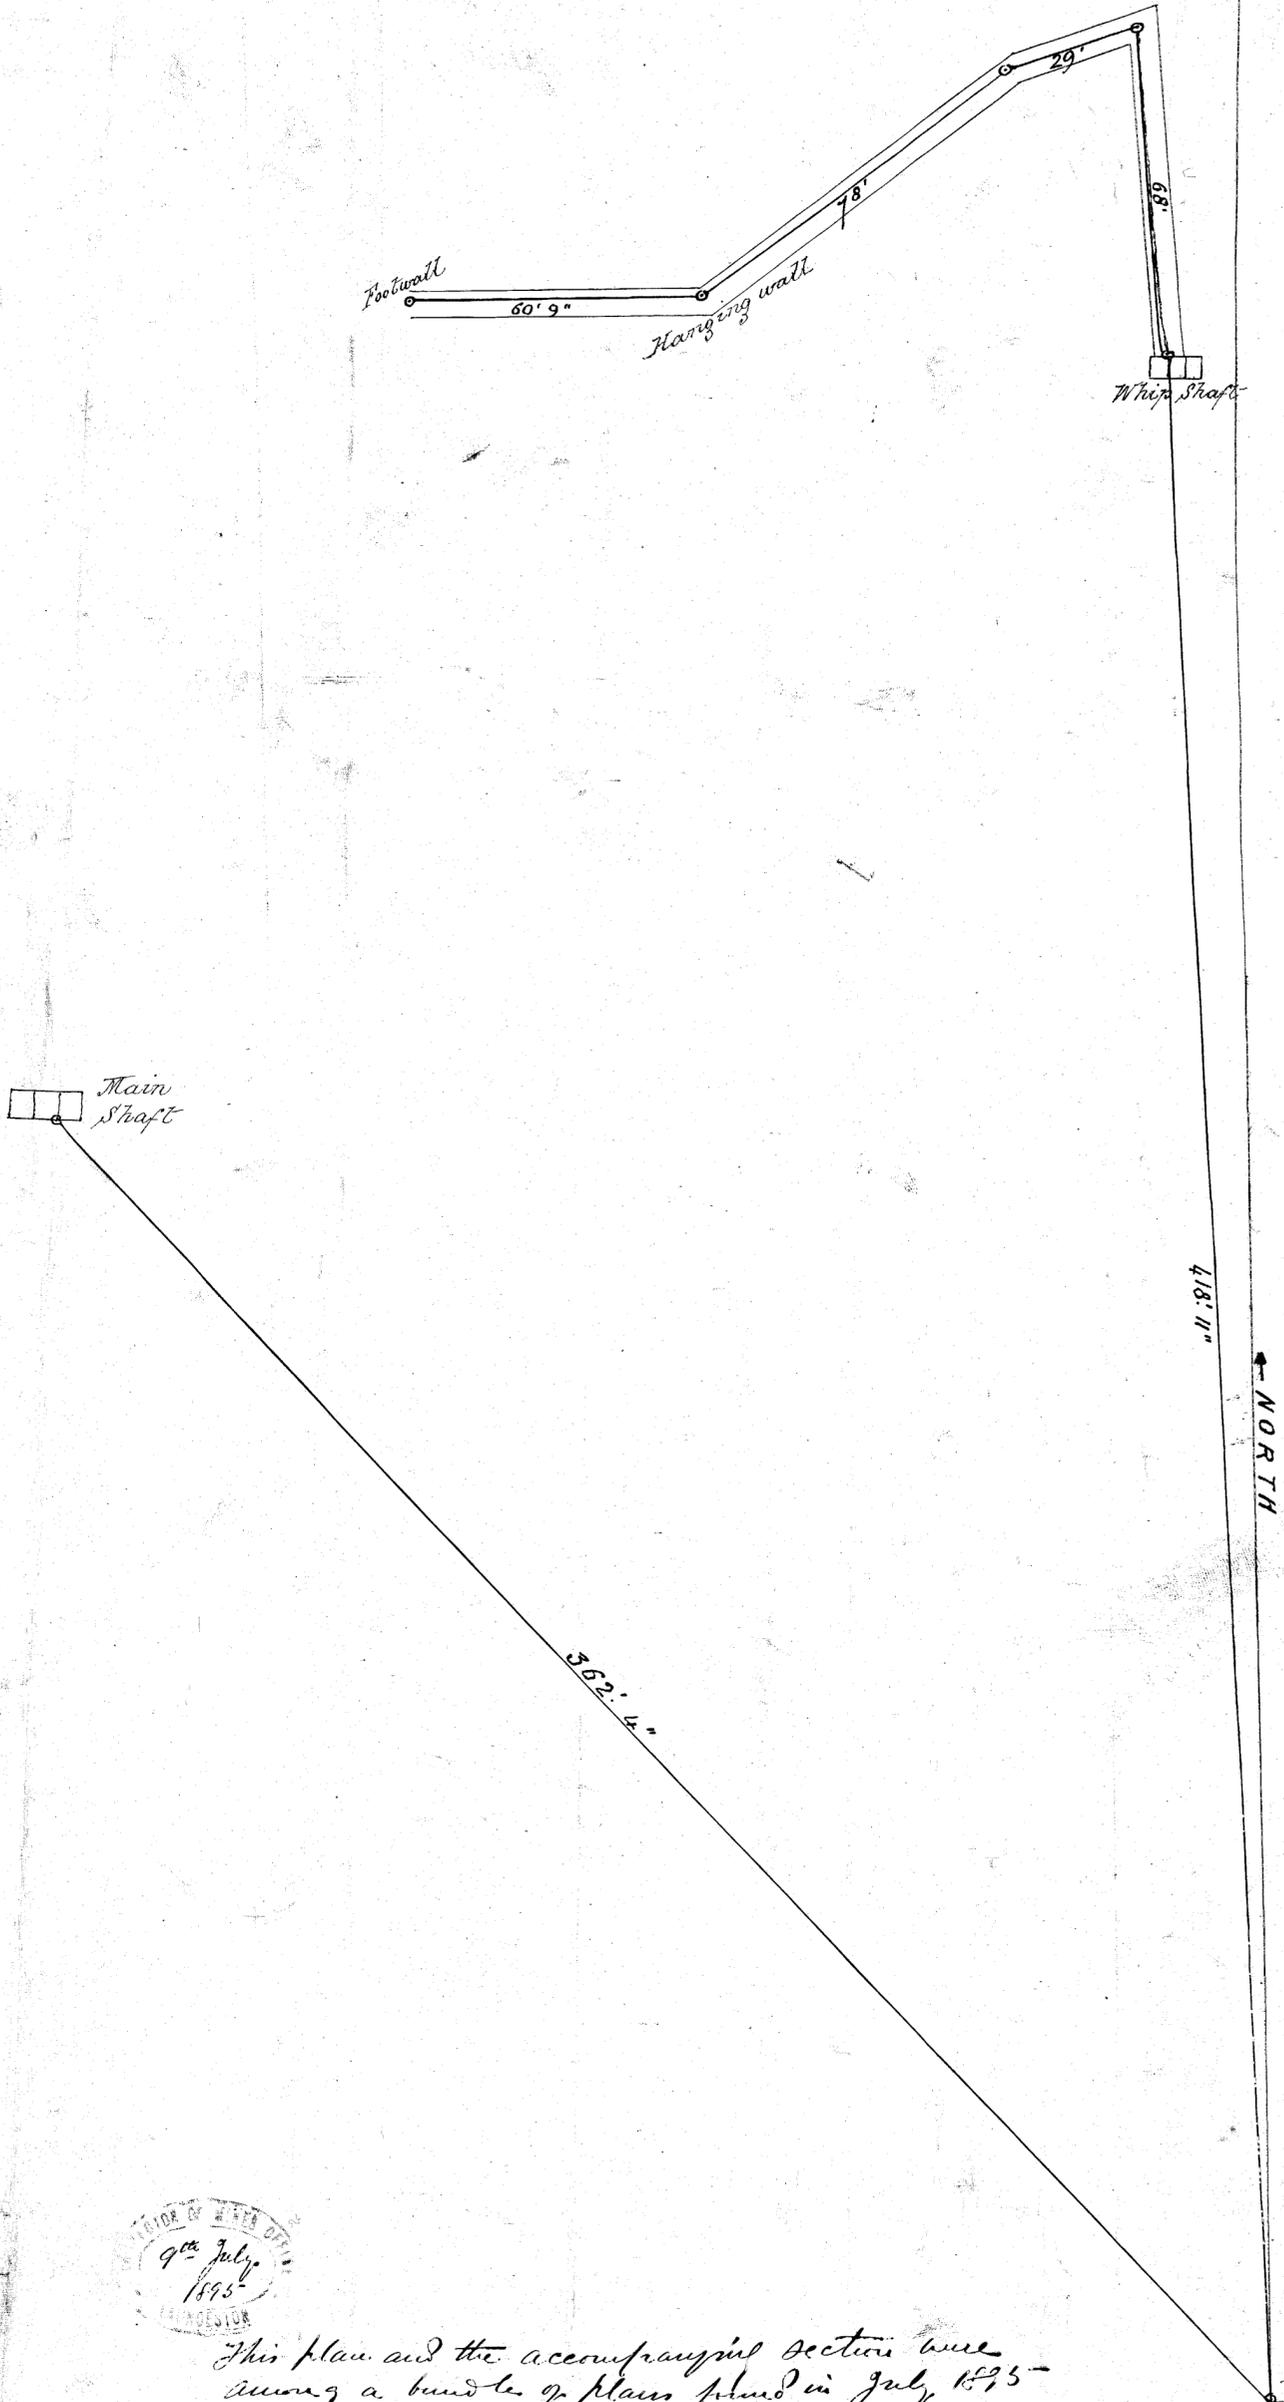

*This plan and the accompanying section were among a bundle of plans found in July 1895 - stuck behind a press in the Registrar of Mines Office, Lancaster, & presumably sent in in 1892. A. Montgomery  
Inspector of Mines  
12th July 1895*

New Pinafore

*29/1/70*