




Scale 25 feet to an inch



References  
 Present Survey  
 Inaccessible Copied from Mr. Richards Survey

CHUMS PROPY G M CO N L

368

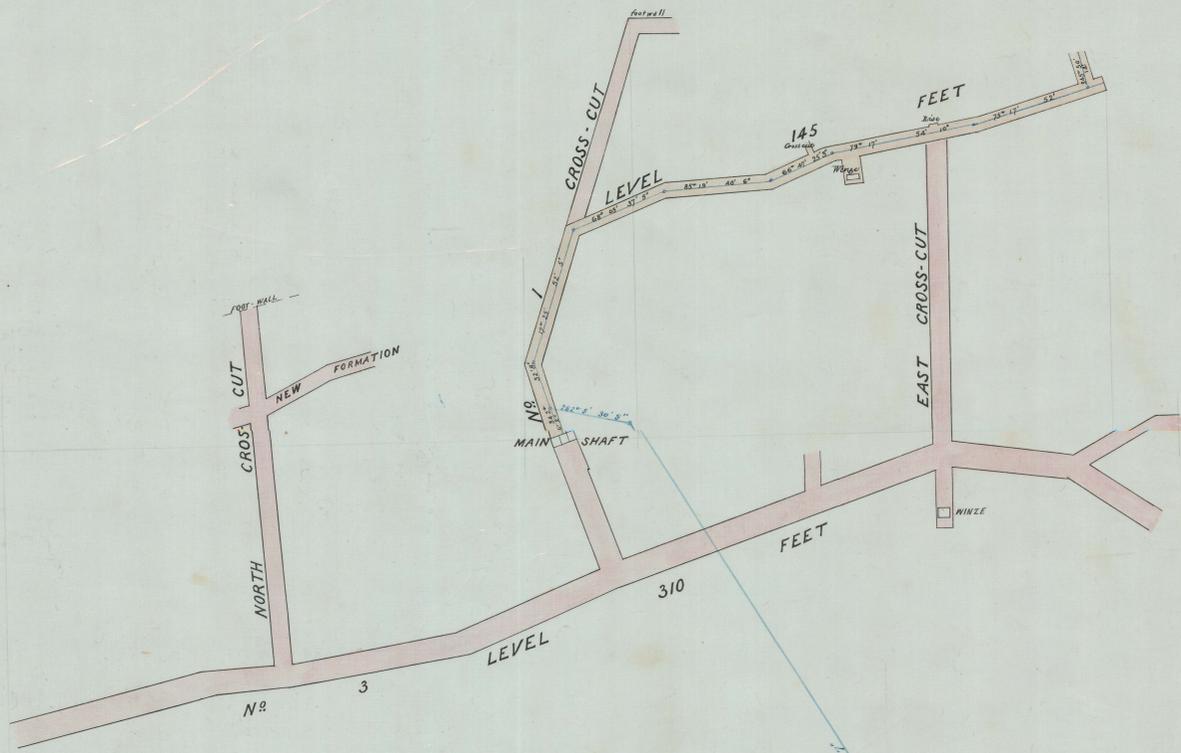

NEW PINAFORE G M CO N L

363  
376

WEST EXT. PINAFORE G M CO N L

$\frac{847}{876}$

$\frac{974}{876}$

Correct Copy of Plan to Feb 28<sup>th</sup> 1895

25<sup>th</sup> April 1895

A. J. Miles  
Authorized Surveyor  
Leroy  
4/14/95