


PLAN OF HICKSON'S MINE No LIA


(HAVELOCK)

County of Cornwall, Parish of Fraser

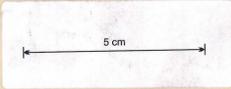

270° 0' 0" BOUNDARY LINE

21 JUN 1898
LUNCESTON

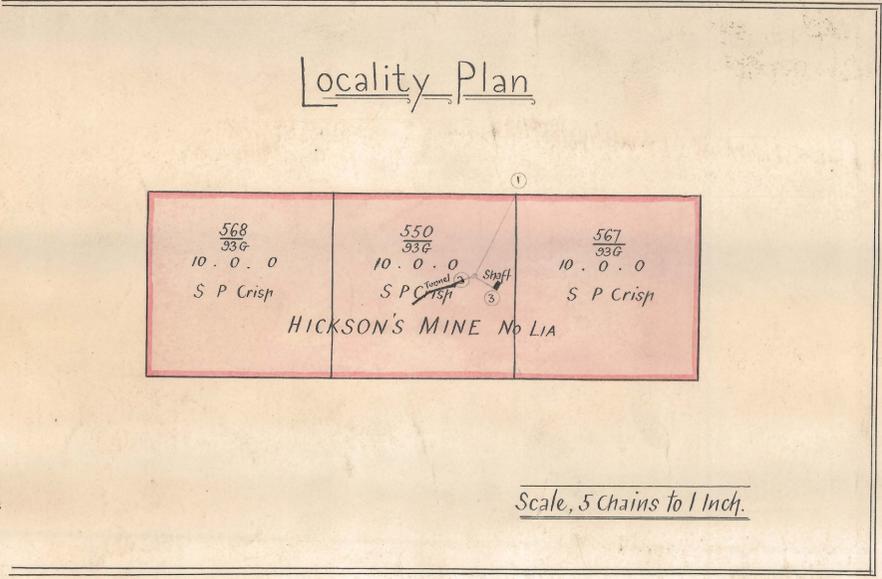


550
33G

A R P
10 . 0 . 0

180° 0' 0" DATUM


S P CRISP GOLD LEASE

HICKSON'S MINE No LIA

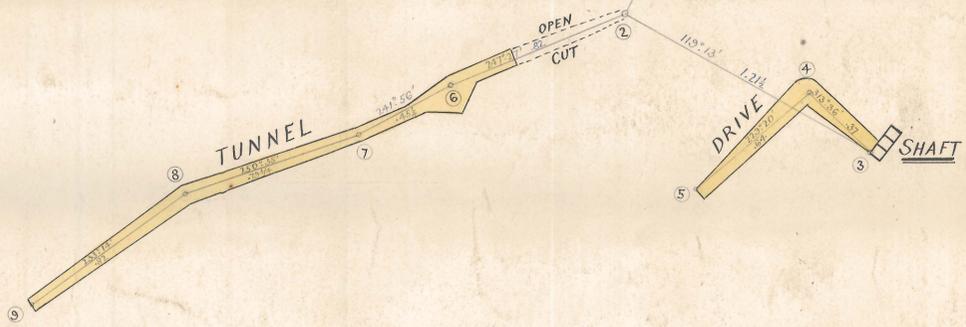

VERTICAL SECTION

Scale, 25 Ft to 1 In.

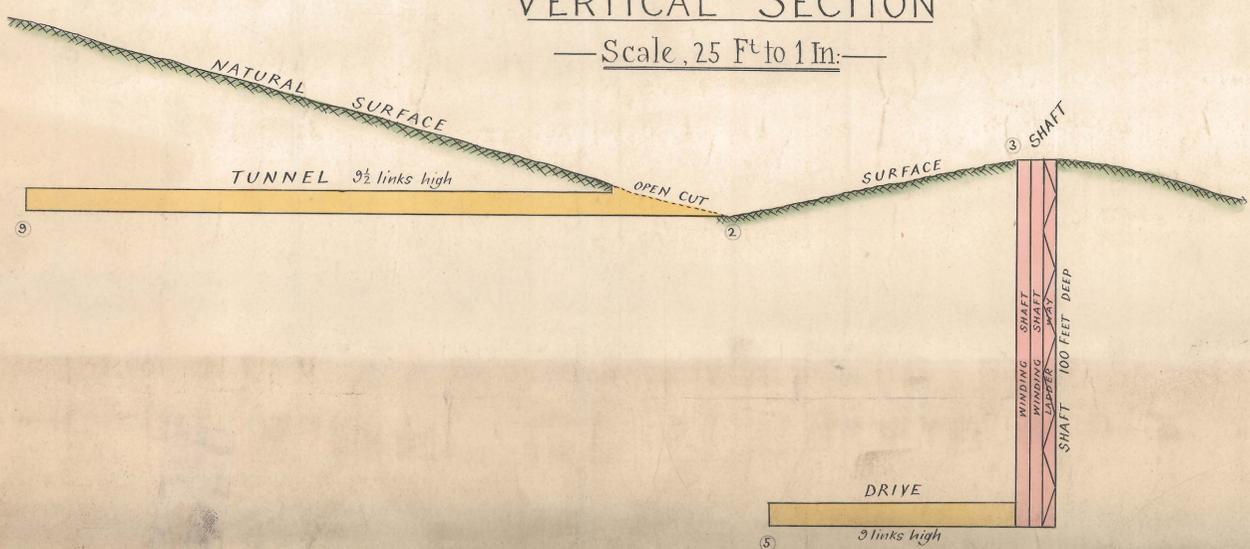

Thomas Clark
DISTRICT and MINING SURVEYOR