


PLAN

TRACING

OF


NEW GOLDEN KING COLDMINE

SCALE 25 FT TO 1 INCH


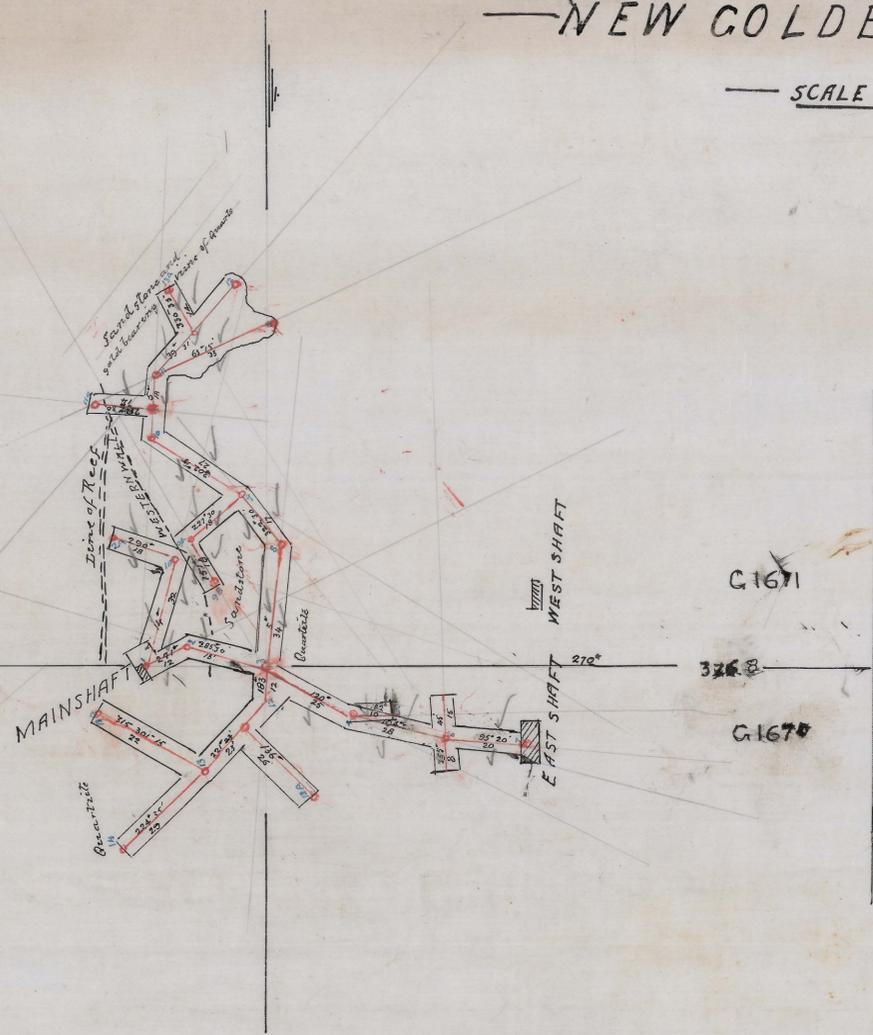


CROSS SECTION

CROSS SECTION LOOKING NORTH

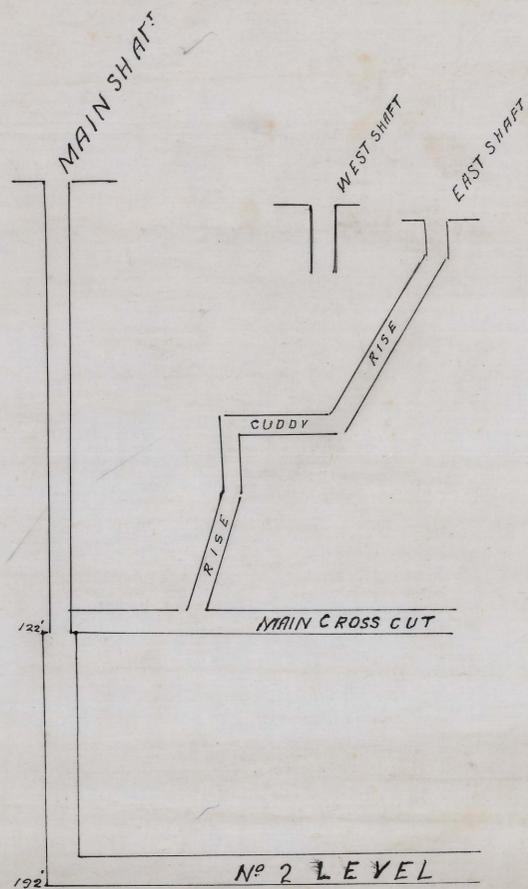

LONGITUDINAL SECTION LOOKING EAST

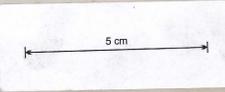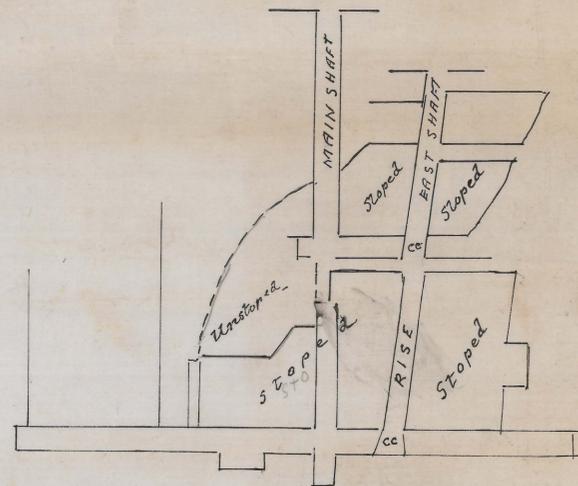

W. J. Burrows
 Author & Miner
 Surveyor
 26th July 1903
 The above used

