


325  
02

5 cm

MATHINNA C. M.  
Longitudinal section.  
Scale 25 ft to 1 inch.

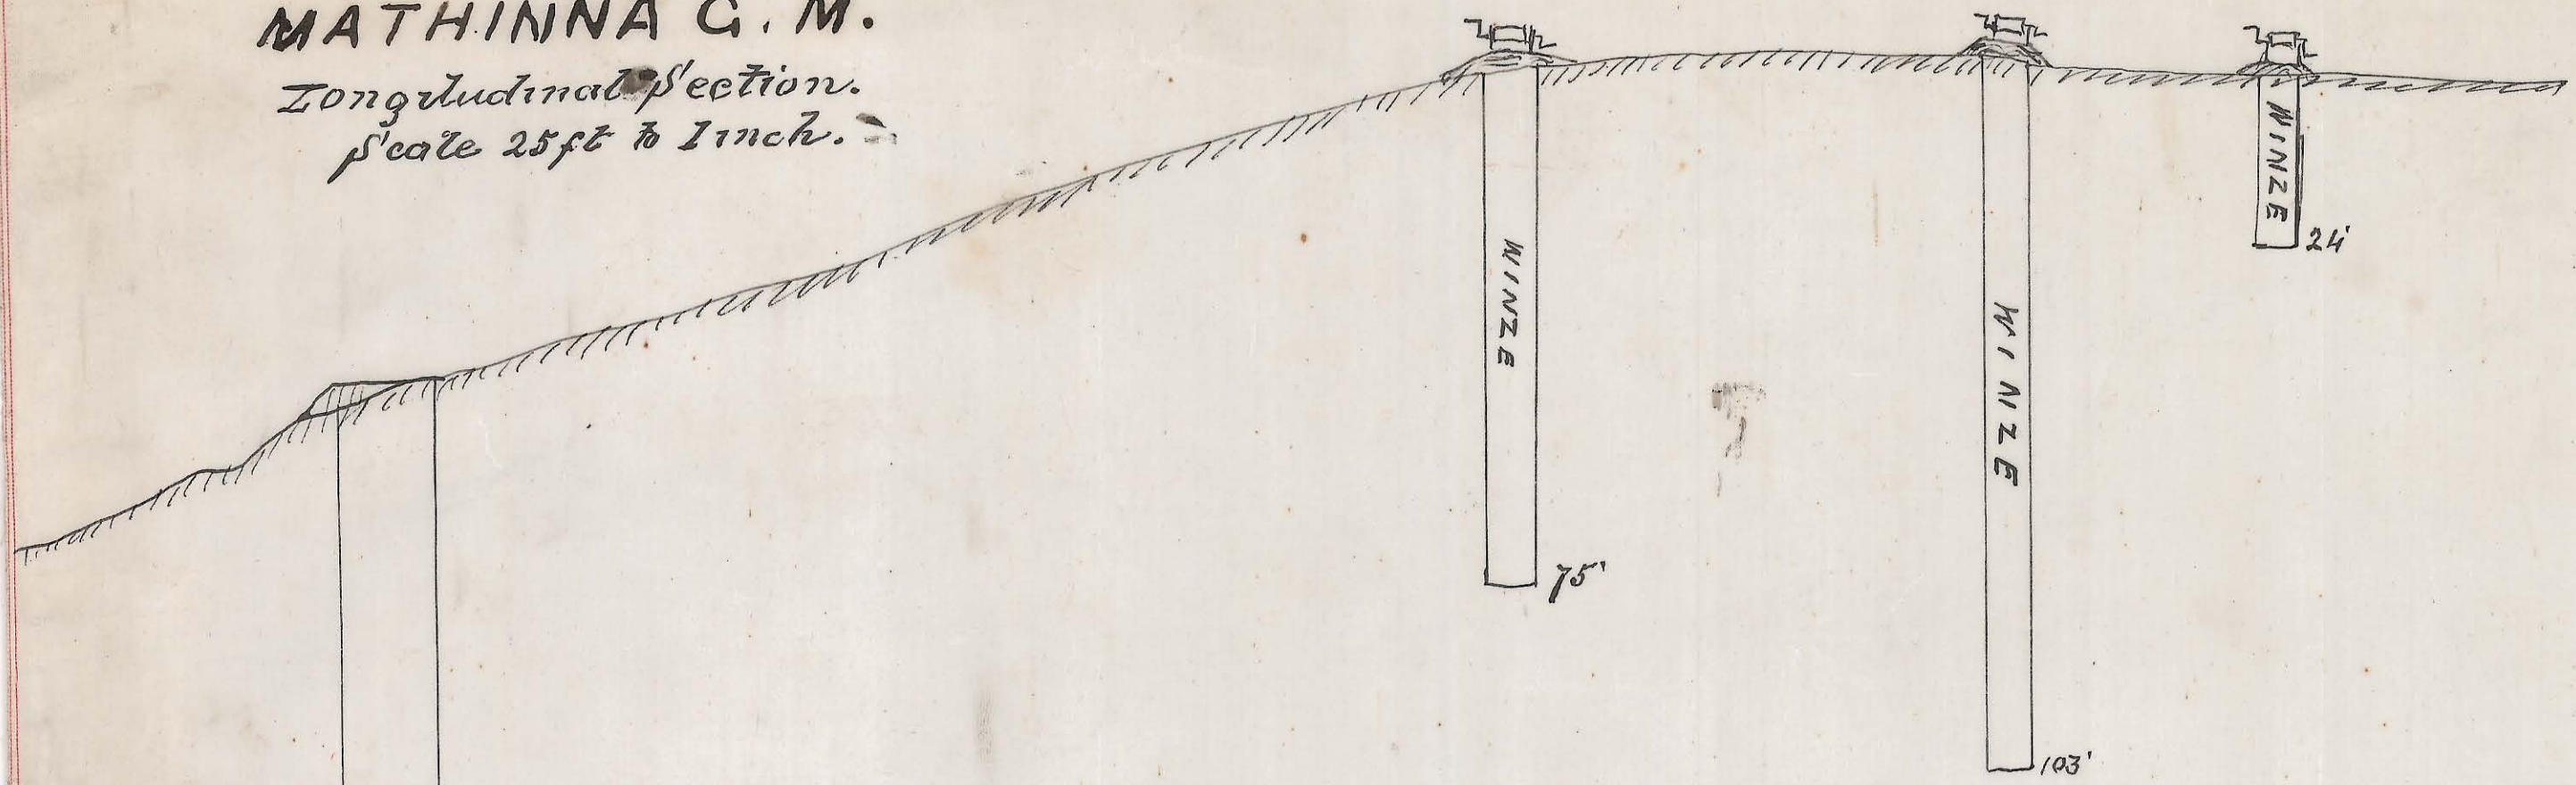

Certified correct copy of workings of above  
mine as far as can be obtained up  
to end of year 1890

*Benjamin Watson*  
Mining & Land Surveyor  
R. P. Act