
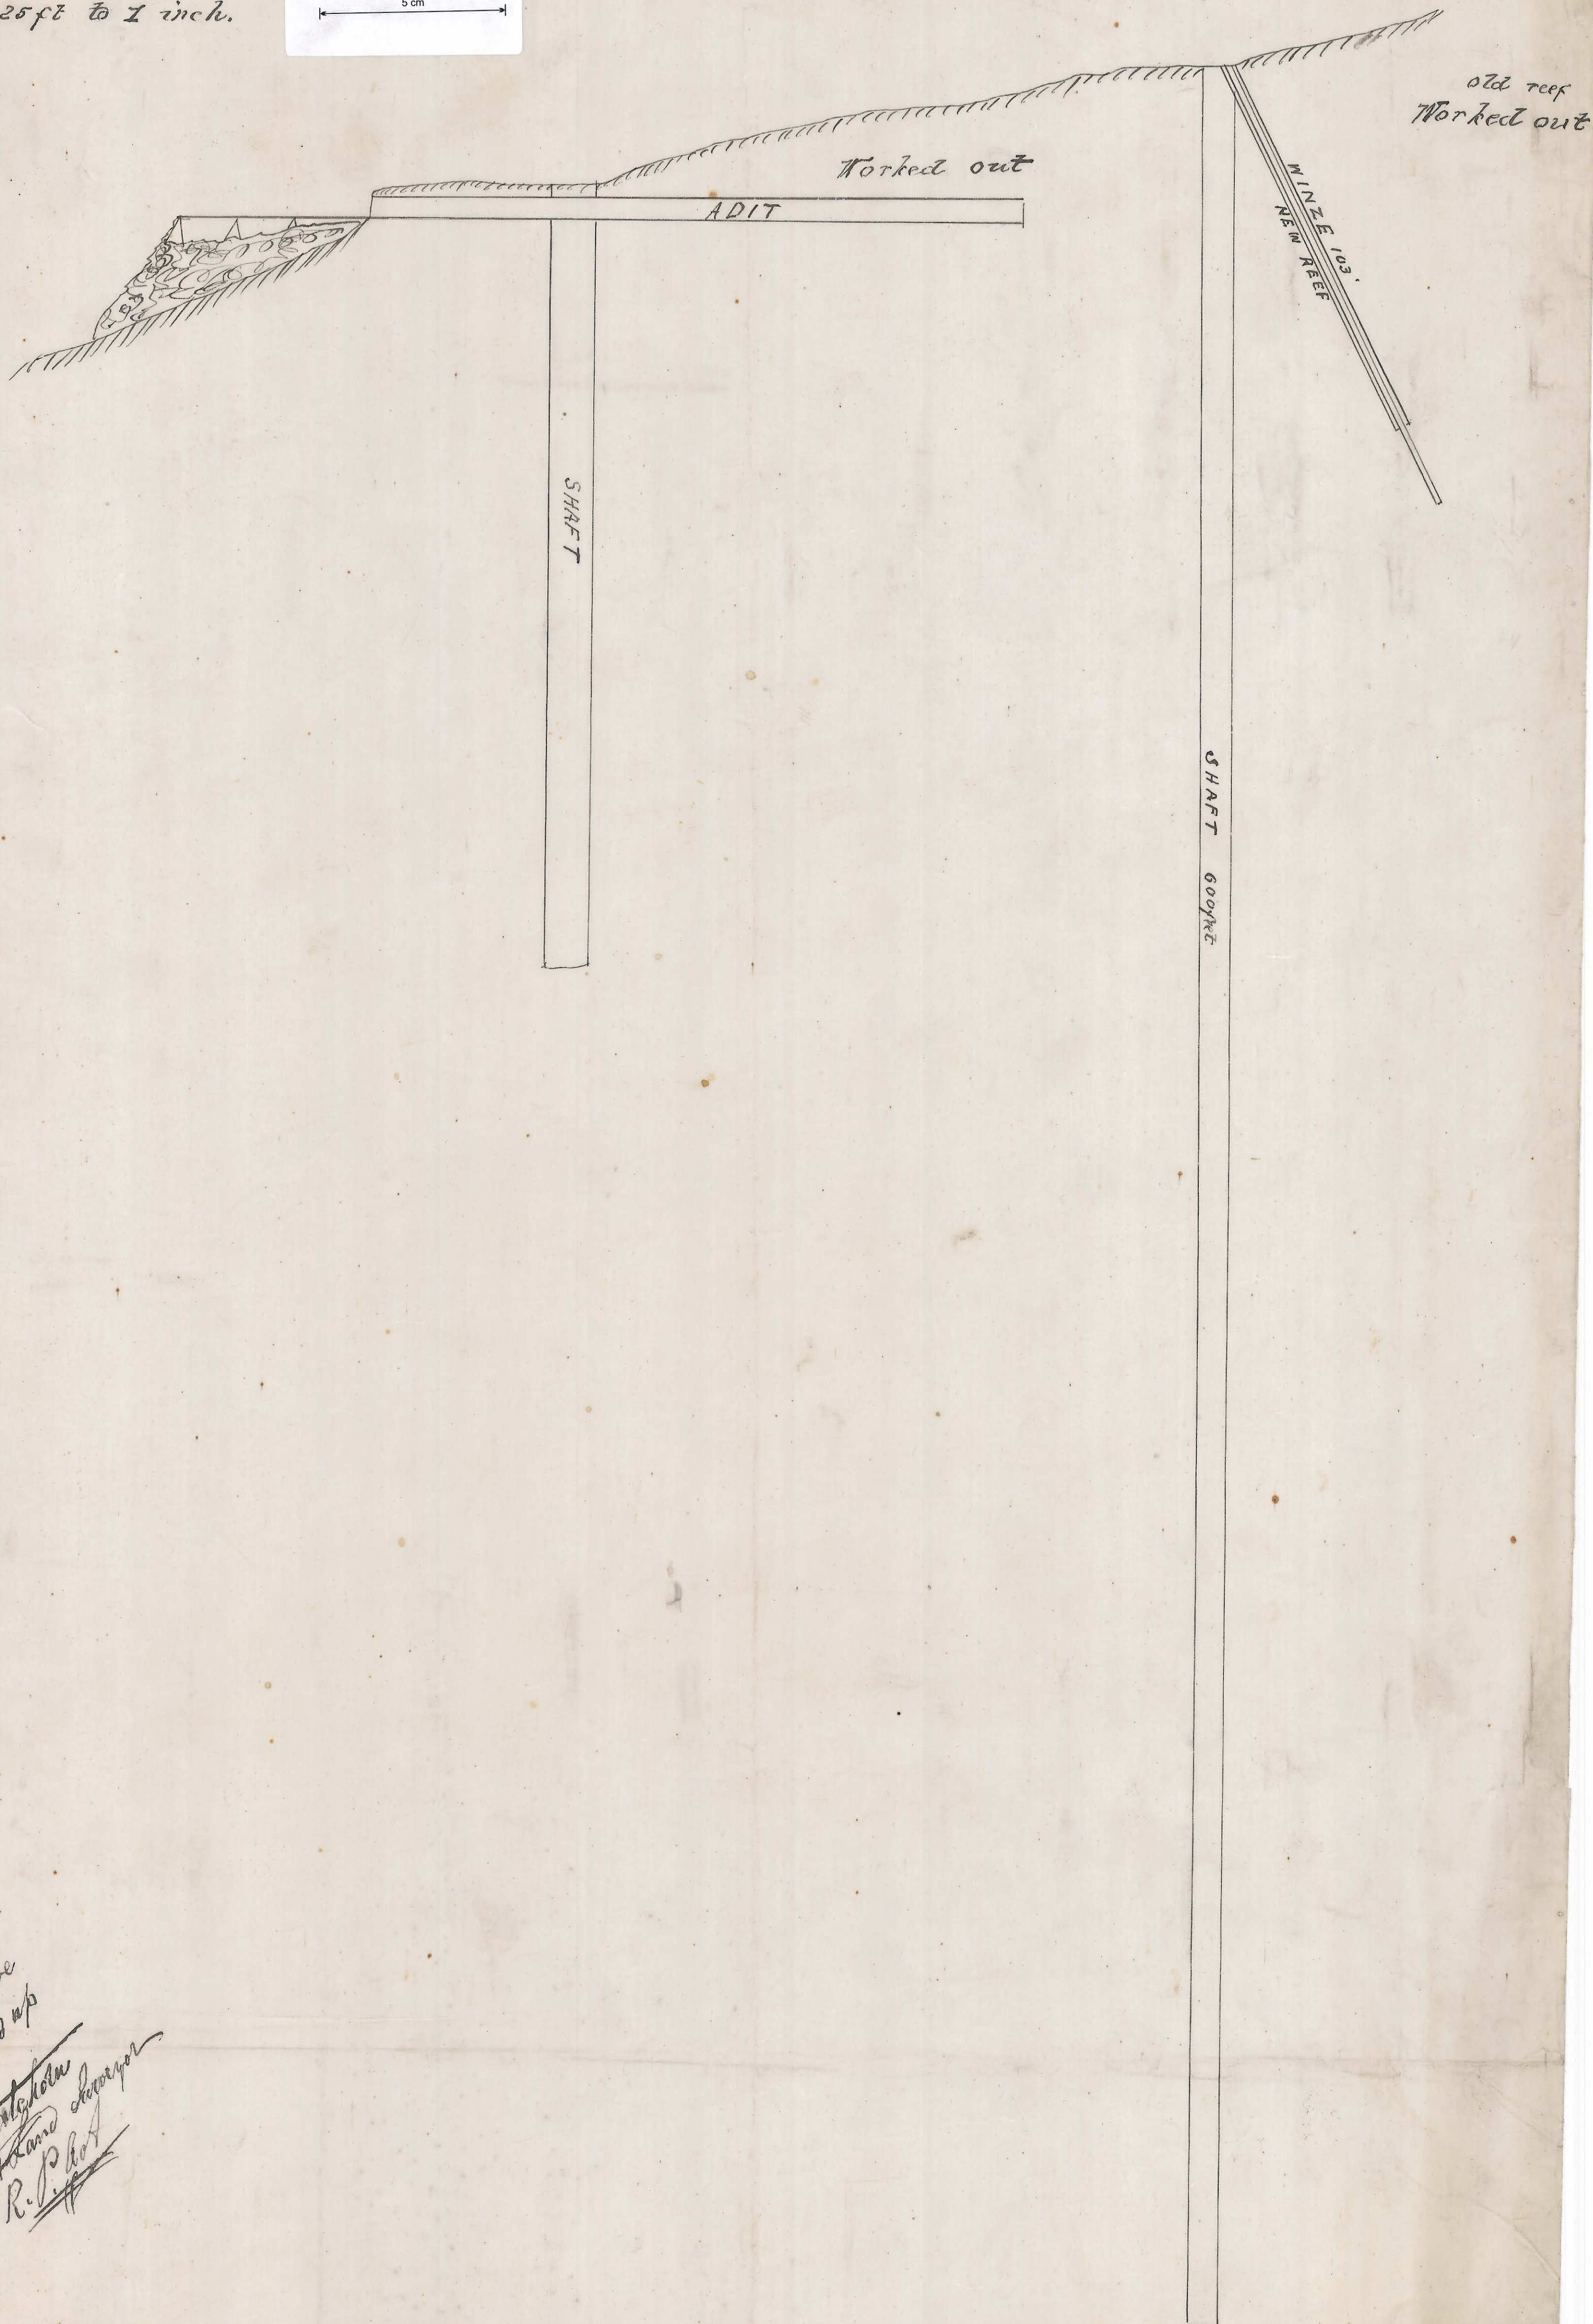


MATHINNA G. M.
Cross Section
Scale 25 ft to 1 inch.

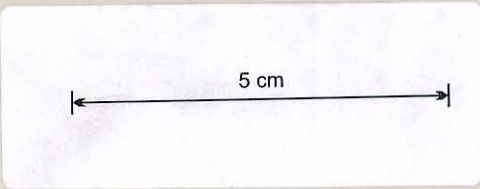

325
02

Verified correct plan of above
mine as far as can be obtained up
to end of year 1890
G. B. Smith, Washington
Mining R. P. Smith