


MATHINNA.C.M.

Scale 25ft to an inch.

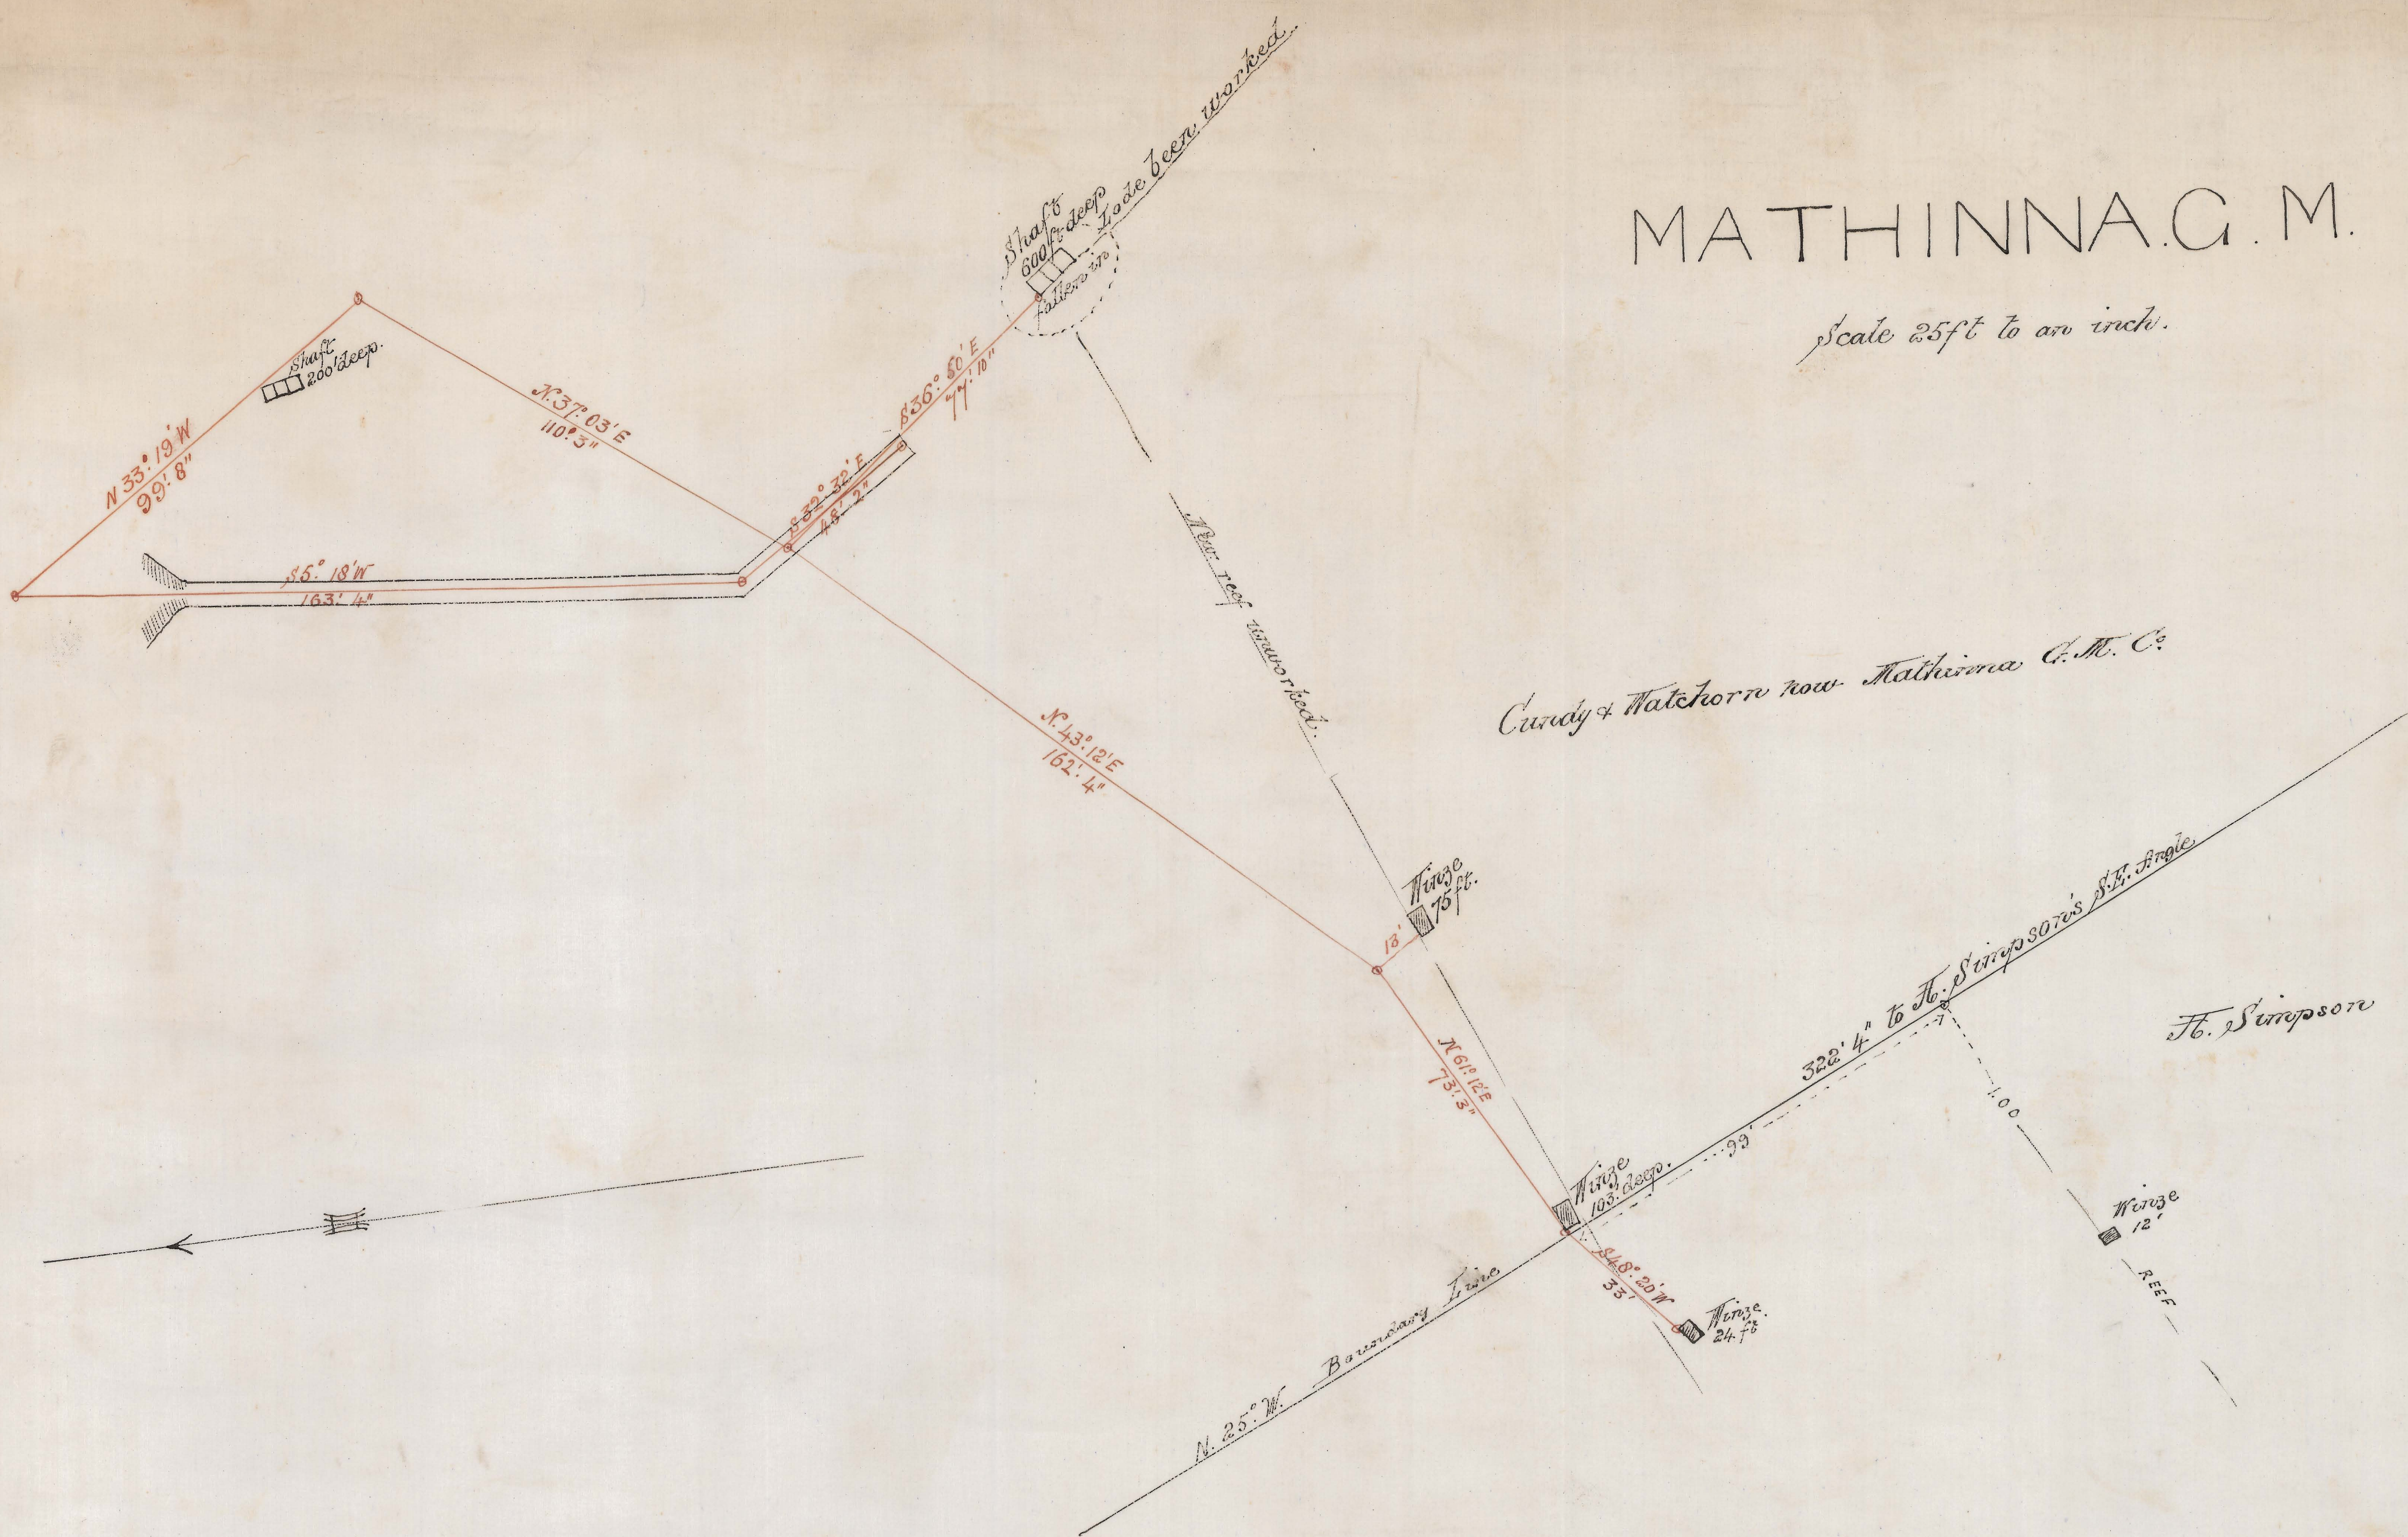

Certified correct plan of workings of the above mine to end of year 1870, as far as can be obtained.

Brigley Watchorn.
Mining & Land Surveyor
R. P. Act

20