



Workings on land held by
O'Brien's Prospecting Association
near Dan's Rivulet,
County of Cornwall


Scale . Twenty-five feet to an inch

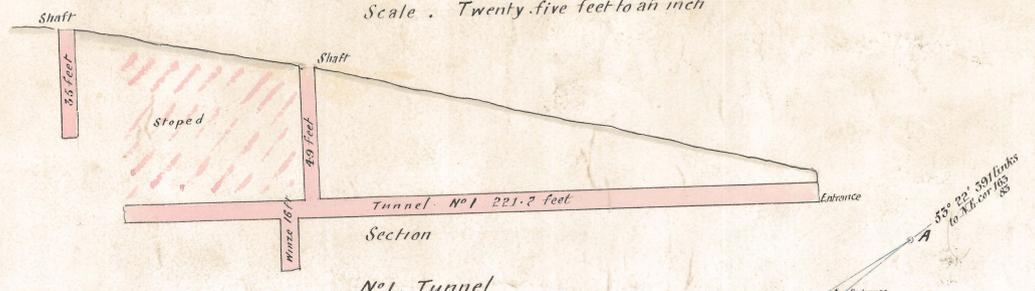

Section No 1 Tunnel

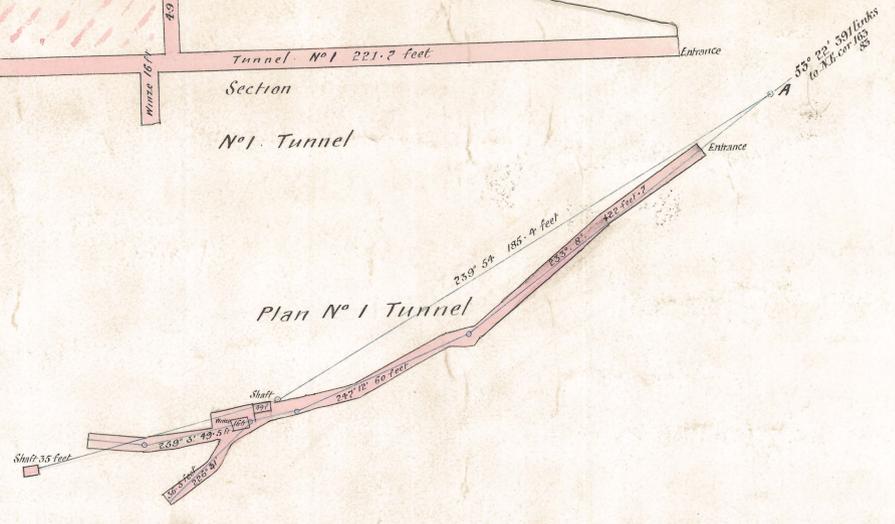


Plan No 1 Tunnel

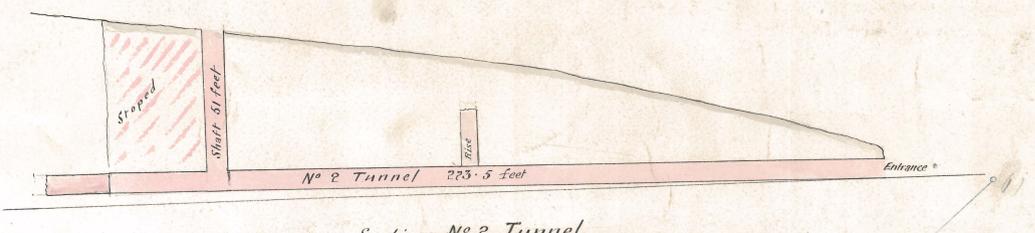


Section No 2 Tunnel



Plan of No 2 Tunnel

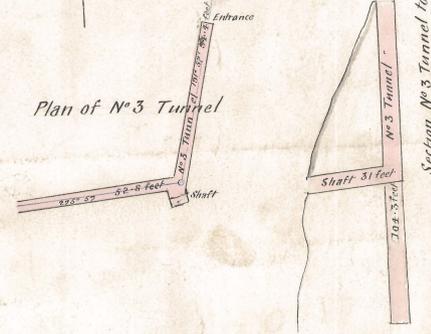


Plan of No 3 Tunnel

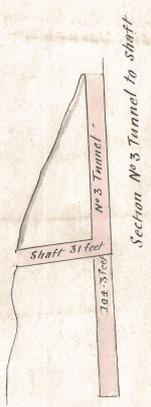

Section No 3 Tunnel to shaft

Survey of No 1 Tunnel beginning on SW cor		of 227 7/8	
102 1/2	Shaft	127	Shaft 35 feet deep
191' 57"	angle of elevation 4 1/2°	120	
from 183' on N 1/2		11	Shaft
196		4	
165		25' 36"	11' up
65		43	top of entrance to Tunnel
70		230° 57'	18 1/2" up
191' 57"		65	
30° 41'		5	
		26	
		17	
		15	
		26' 41"	
		5	
		27' 12"	
		25	
		32	
		23	
		20	
		269' 3'	
		61	
		242' 12"	
		186	
		183	
		161	
		100	
		83	
		235' 8"	
		169	
		232° 22'	
		228' 67"	

Plan showing position of Workings as to boundary lines of Sections
Scale 5 chains to an inch

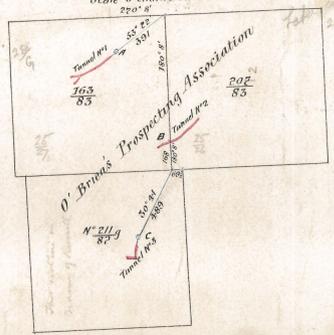

30th January 1890
J. J. G. G. G.