

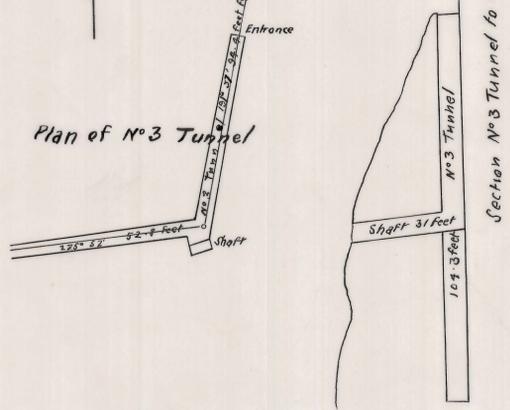
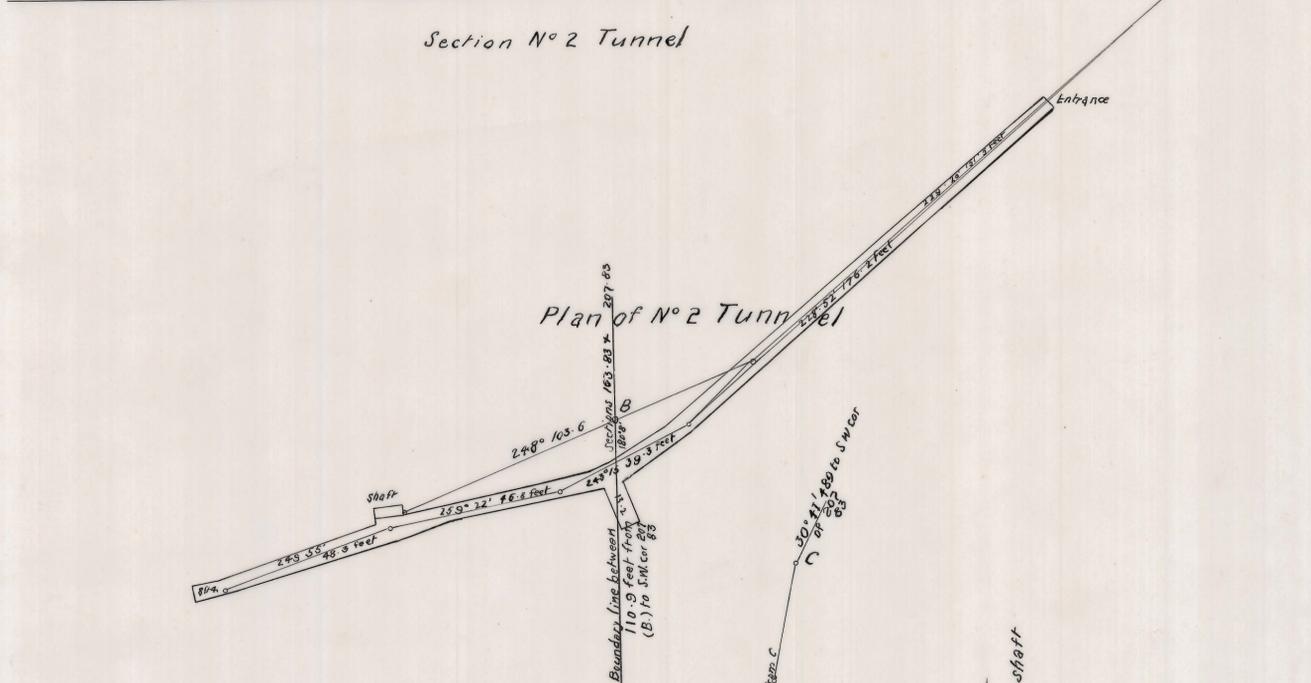


Workings on land held by
O'Brien's Prospecting Association
near Dan's Rivulet,
County of Cornwall

Scale Twenty five feet to an inch

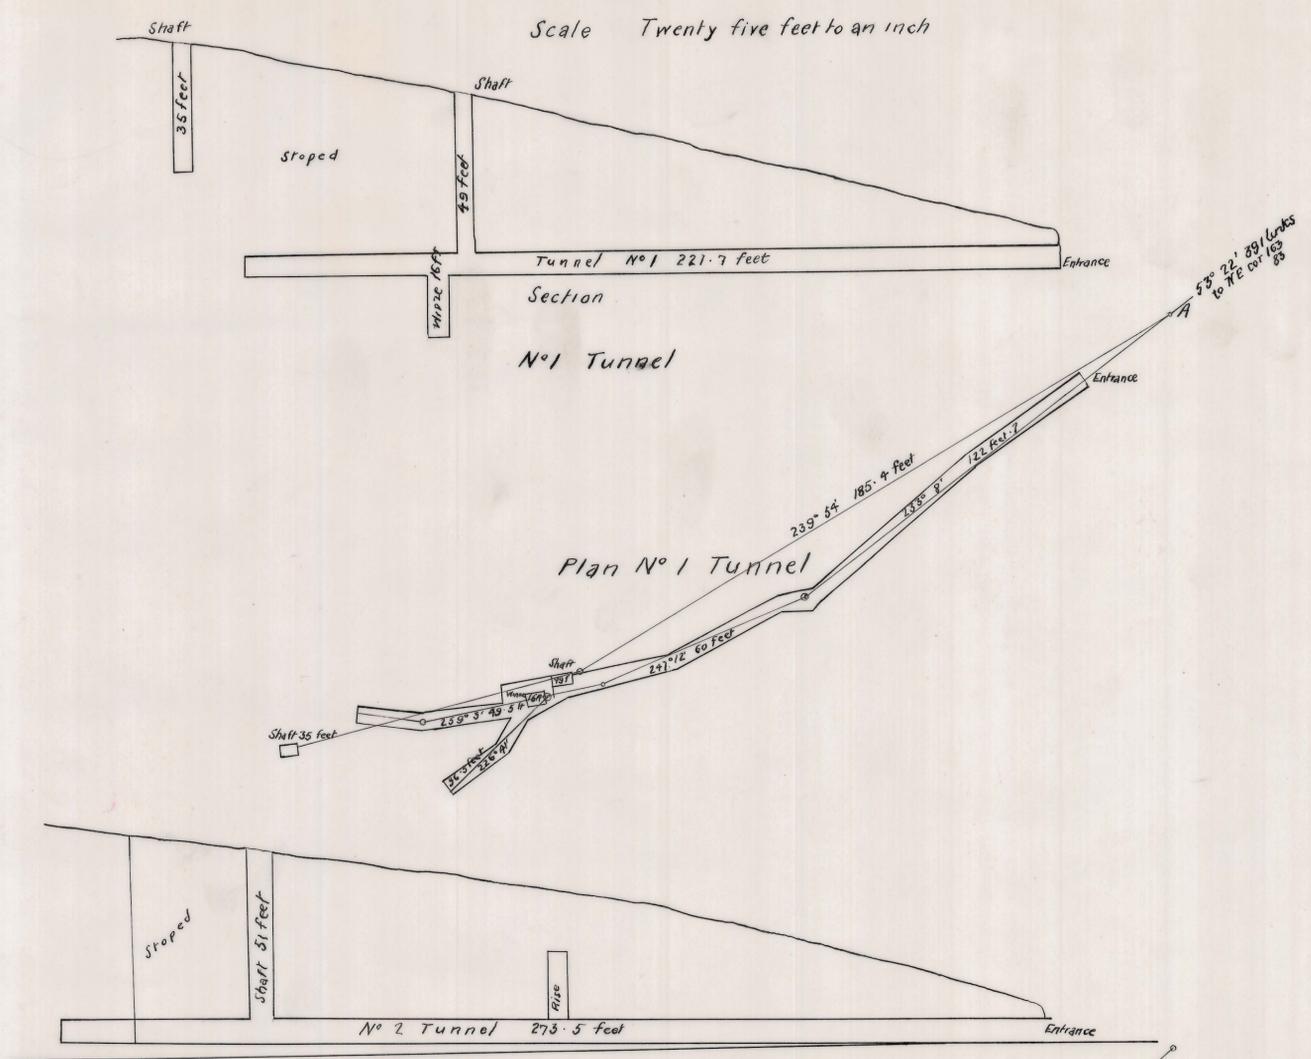

Survey made with theodolite & compass with 22/1/90		
107 1/2	Shaft	
191° 57'	angle of elevation 29 1/2'	
again from 79 on N° 1		
80		
from 143 on Act 225° 57'		
146		
143		
65		
49		
191° 57'		
789		
30° 41'		
of 207 1/3 Survey of N° 3 Tunnel beginning on SW cor		
169		
157		
62		
298° 0'	9° up	
228	reduced	
69	approximate entrance	
229° 20'	angle of elev 11 1/2°	
again from N° 1		
36	from	
75 1/2	mark	
81		
279° 56'	steep	
21		
31		
259° 22'		
206 1/2		
35 1/2		
243° 15'		
2		
267		
258		
62		
228° 57'		
Survey of N° 2 Tunnel beginning on N° 207 1/3		
127	Shaft 35 feet deep	
120		
11	Shaft	
+		
265° 36'	11° up	
41	corner	
43	approximate to Tunnel	
again from N° 1		
65		
26		
17		
13		
226° 41'		
from 23 on N° 1		
27		
277° 12'		
42	mark	
23		
20		
237° 8'	mark	
27		
61		
11		
247° 12'		
166		
183		
161		
100		
83		
238° 5'	entrance of tunnel	
27		
232° 22'		
of 168-83 (N° 1 Tunnel)		
O'Brien's Prospecting Association beginning at N.E. cor.		
Survey of workings on N° 168 1/2 and 83		

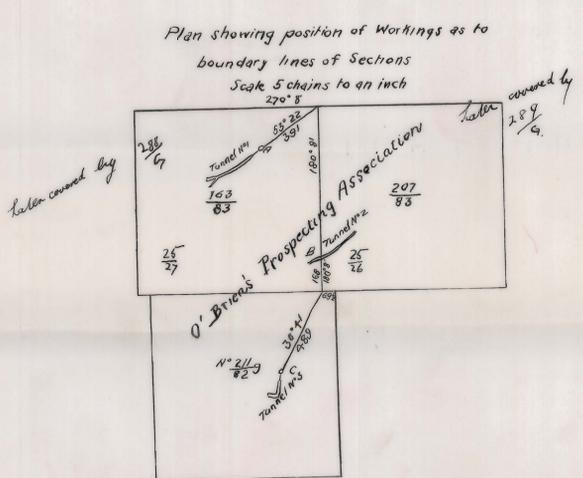

30th January 1890
George Smith