

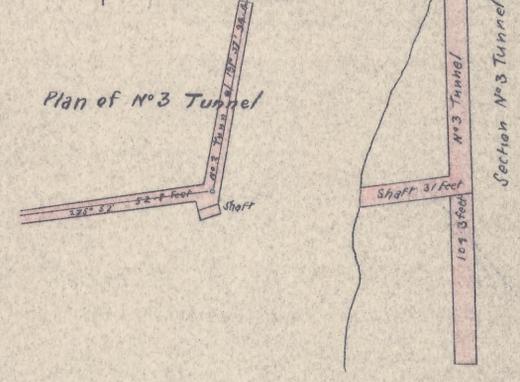
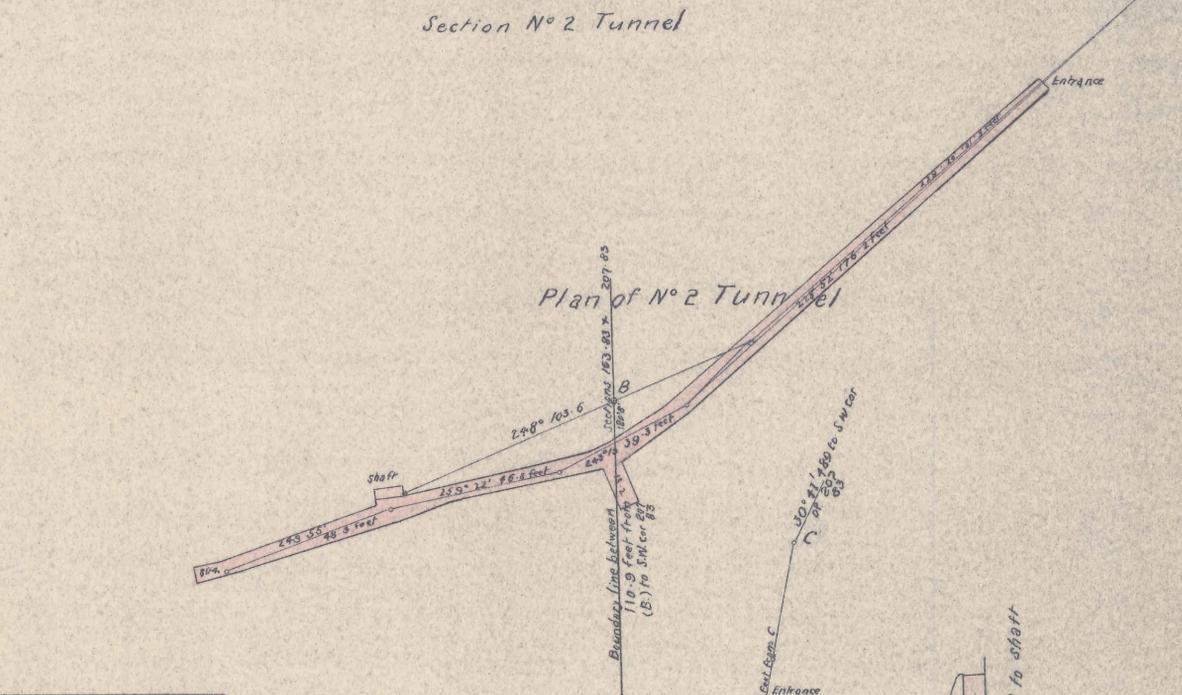


Workings on land held by  
O'Brien's Prospecting Association  
near Dan's Rivulet,  
County of Cornwall

Scale Twenty five feet to an inch

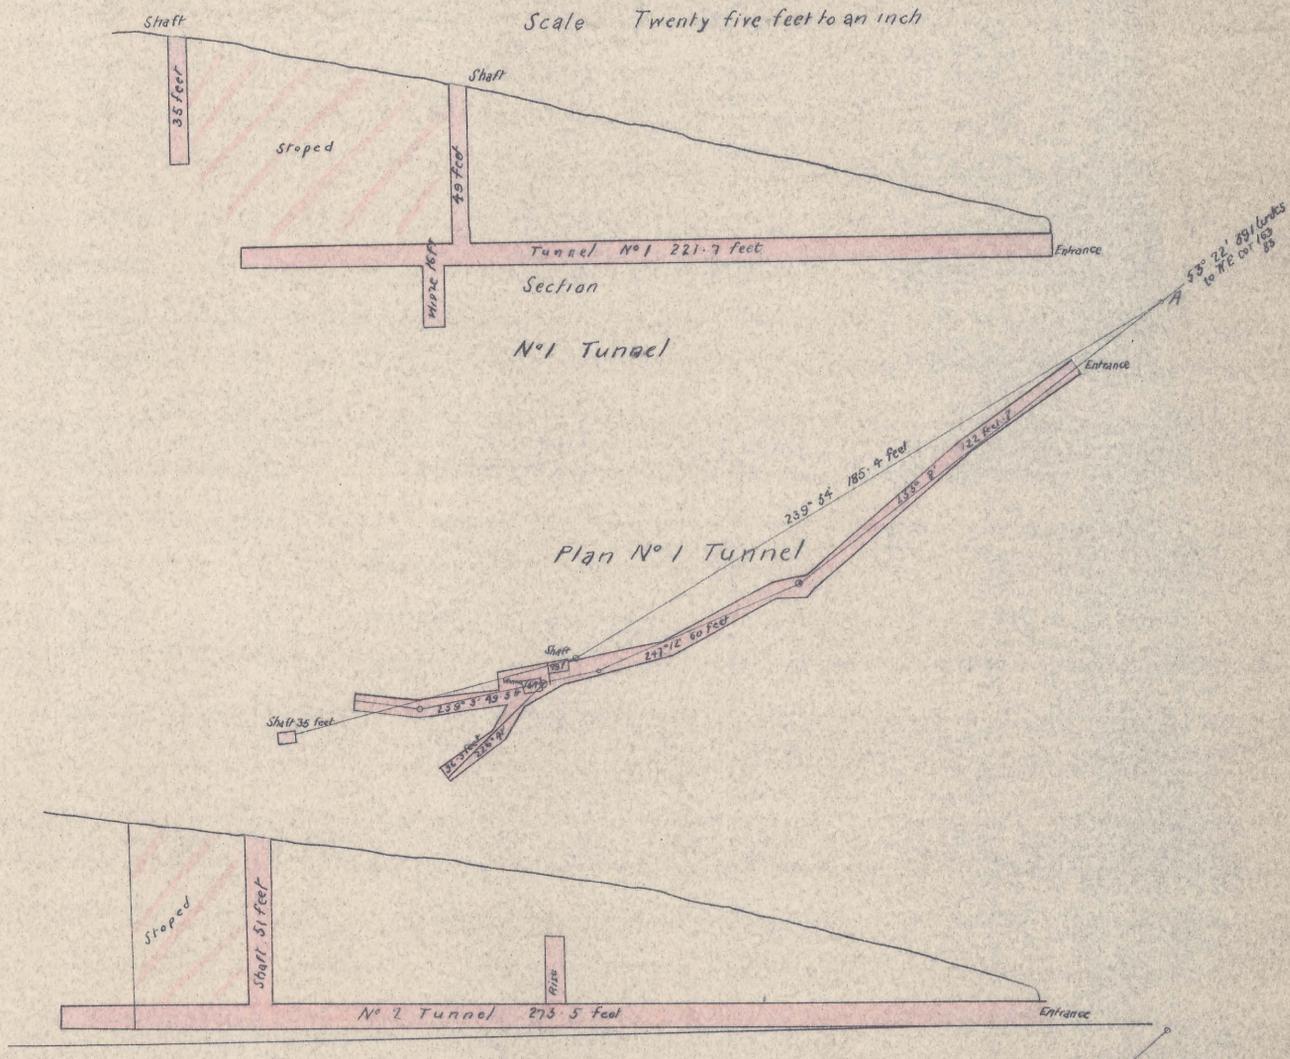

Survey made with theodolite Gough & Co. 22/1/90	
107.5 191° 57' angle of elevation 27°	Shaft 35 feet deep
176 143 55 49	Shaft 35 feet deep
131° 57' 30° 41'	Shaft 35 feet deep
Survey of No. 3 Tunnel beginning on SW cor	
169 157 62 258° 0' 228	Shaft 35 feet deep
86 78 1/2 01 270° 56' 27 31 250° 22' 20 35 1/2 243° 15' 2 267 258 60 228° 57'	Shaft 35 feet deep
Survey of No. 2 Tunnel beginning on N 207	
127 120 11 255° 36' 43 233° 30' 26 17 13 226° 41' 27 227° 12' 25 32 23 20 27 247° 5' 11 11 247° 22' 26 123 100 43 238° 5' 30 202° 22'	Shaft 35 feet deep
Survey of No. 1 Tunnel O'Brien's Prospecting Association beginning at NE cor. Survey of workings on Nos 1, 2, 3 and 4.	

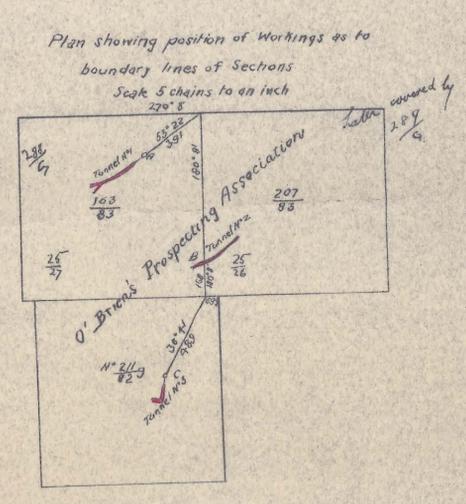

30th January 1890  
Gough & Co.

