
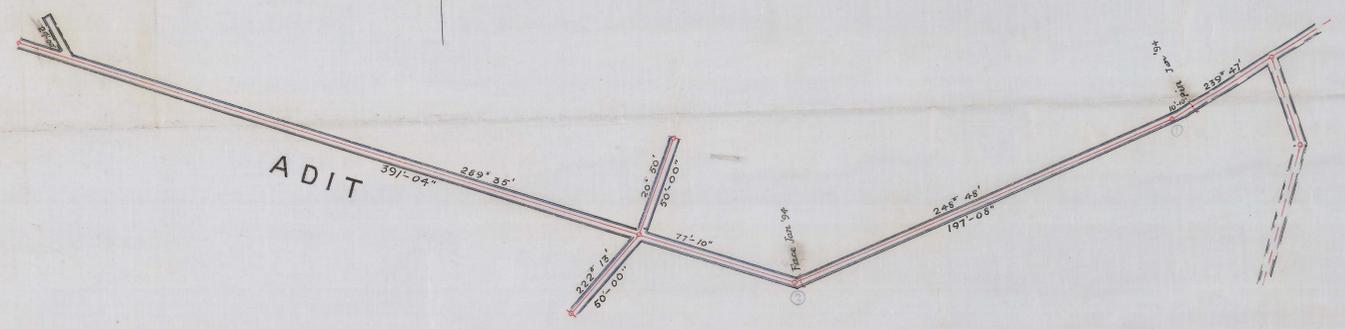




TASMANIA CROWN S. M. MINING WORKS

Scale 30 feet to an inch

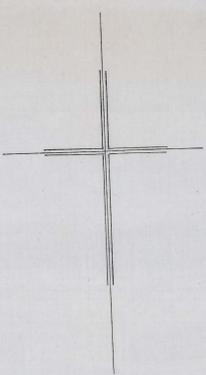

WESTERN S. M.

WESTERN S. M.

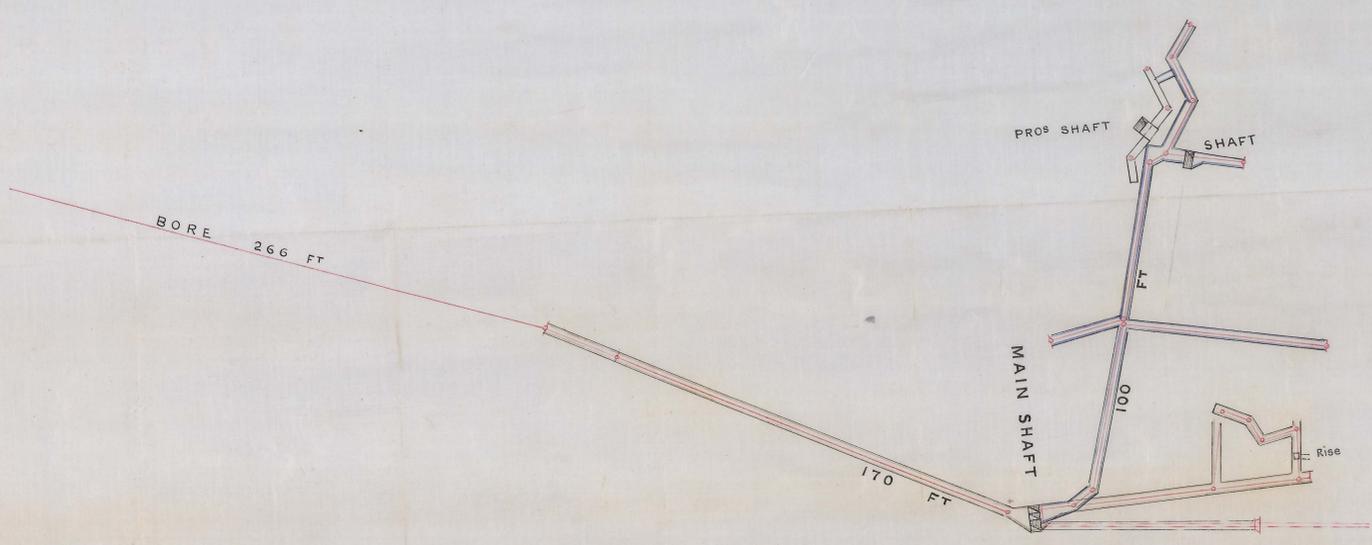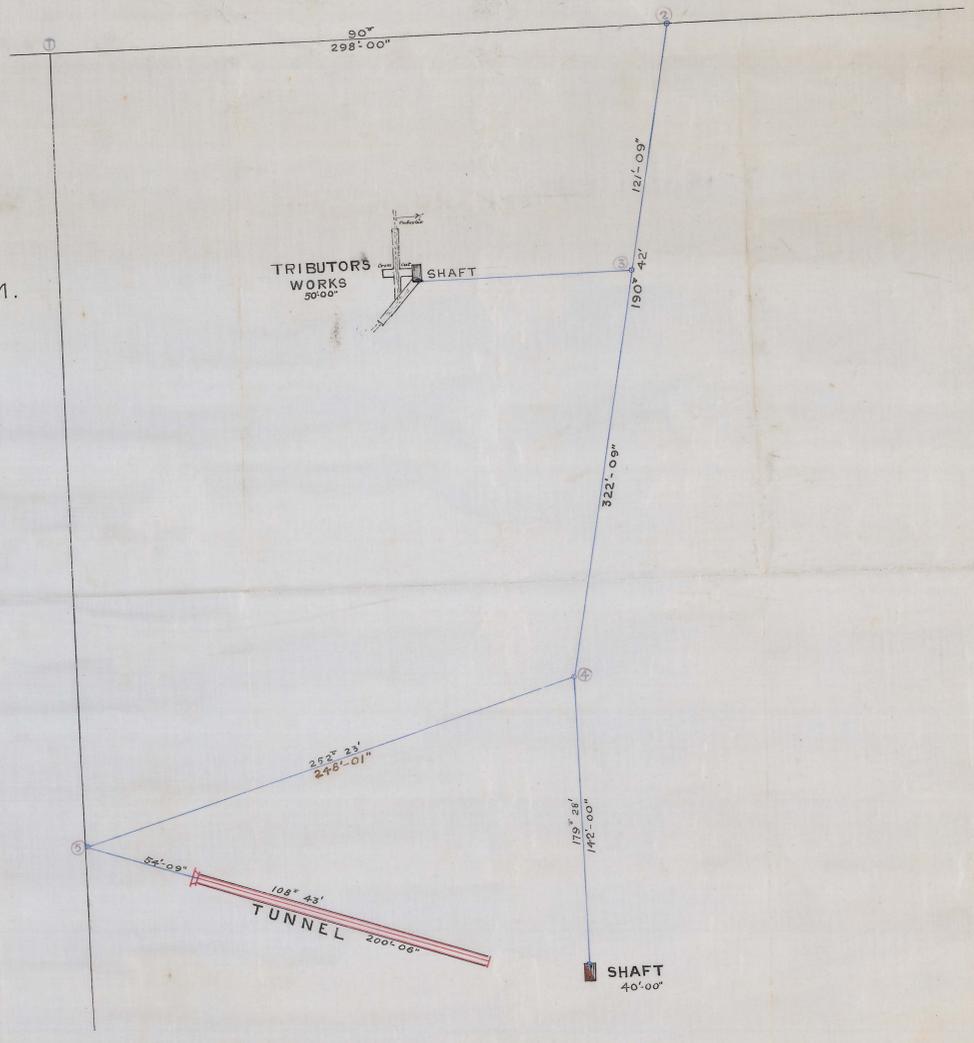

Chas. L. ...
Asst Surveyor
Zeehan Jan 95
1895