





# TASMANIAN CROWN S. M.

## MINING WORKS



Scale 30 feet to an inch

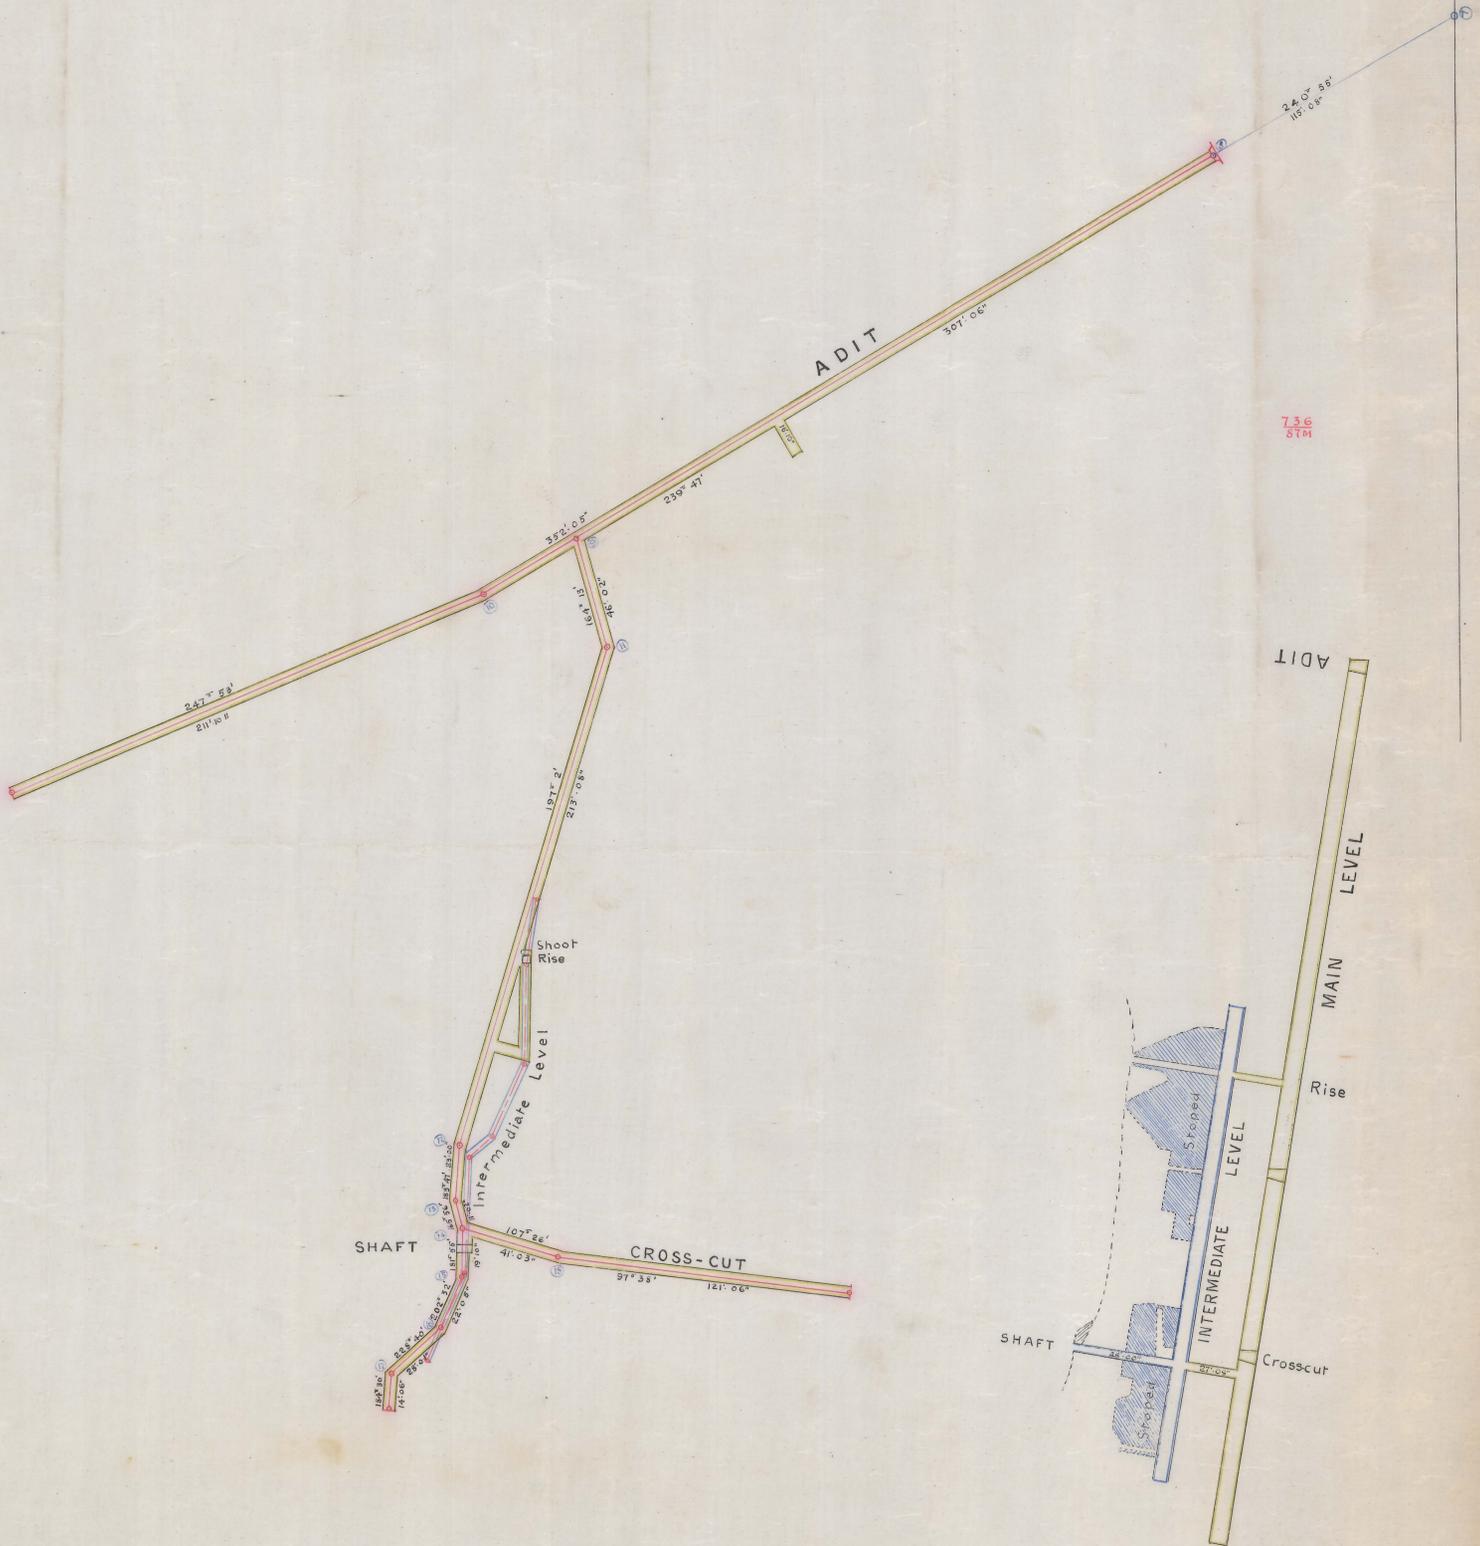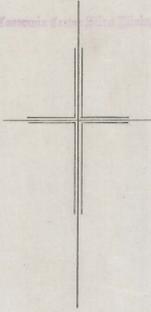

*C.W. Gloss*  
Authorised Surveyor  
Zechara Jan 94