


THE TASMANIA CROWN LIM


Section on Course of Lode

Scale 30 Feet to an Inch

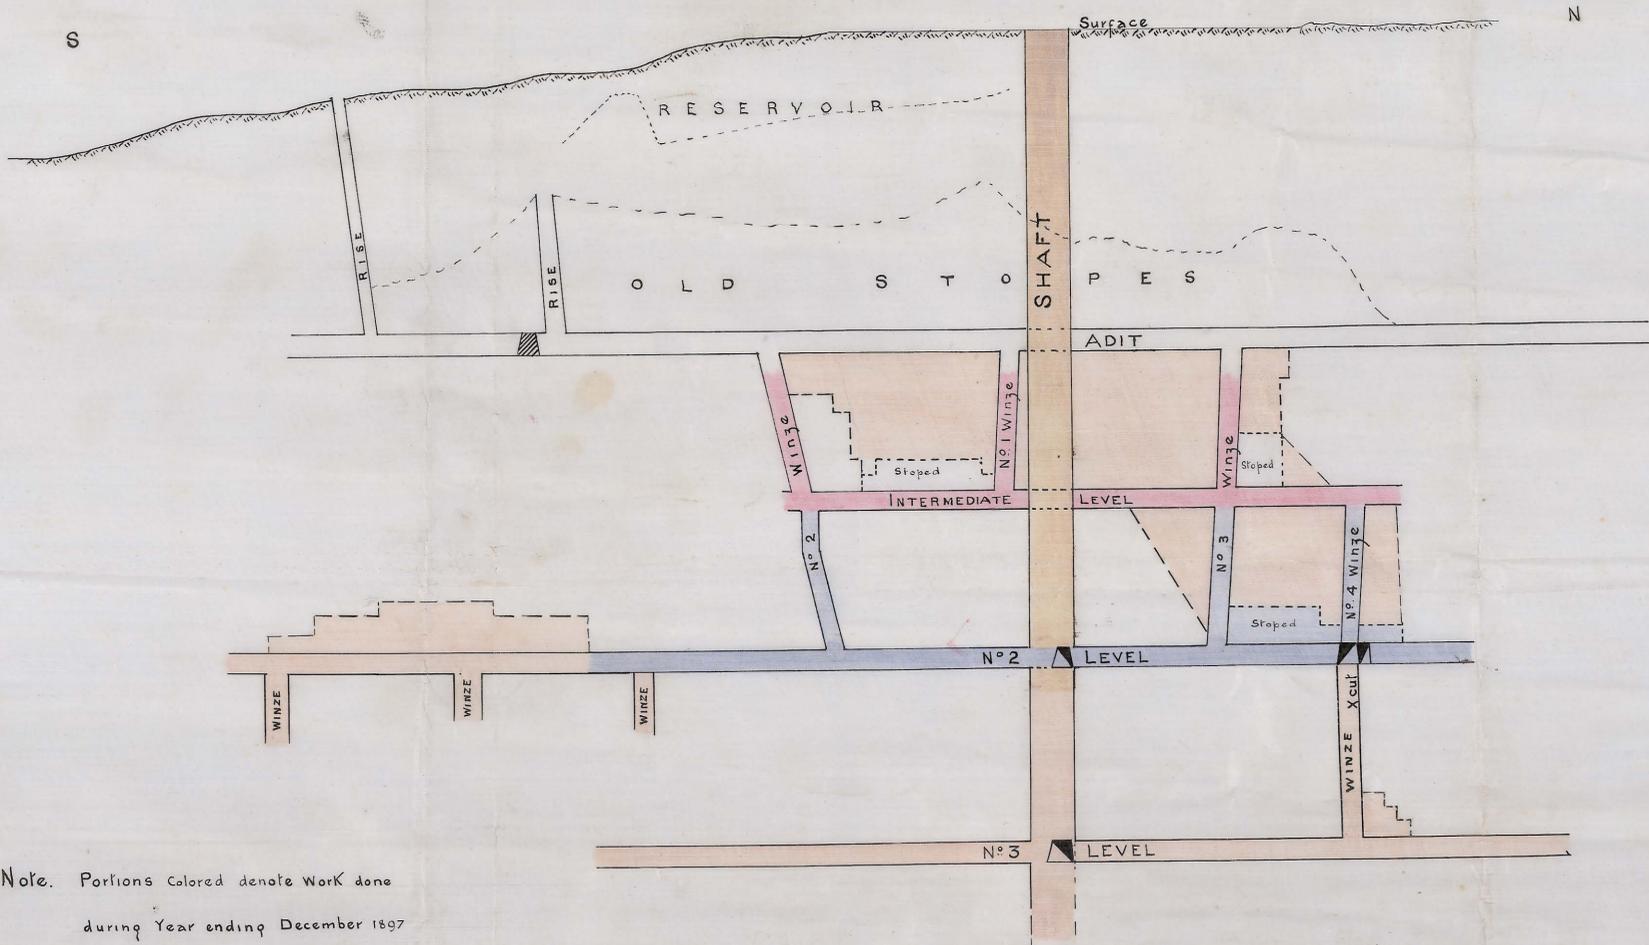

Note. Portions Colored denote Work done during Year ending December 1897

Work during Year ending Dec 1898

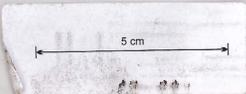

*Geo. R. Kelly
Manager
7/1/98.
20/3/99.*