


NORTH DUNDAS

GENERAL PLAN



SHOWING GEOLOGICAL AND TOPOGRAPHICAL FEATURES, POSITION OF LODES, WORK DONE

Scale - 2 Chains to an inch

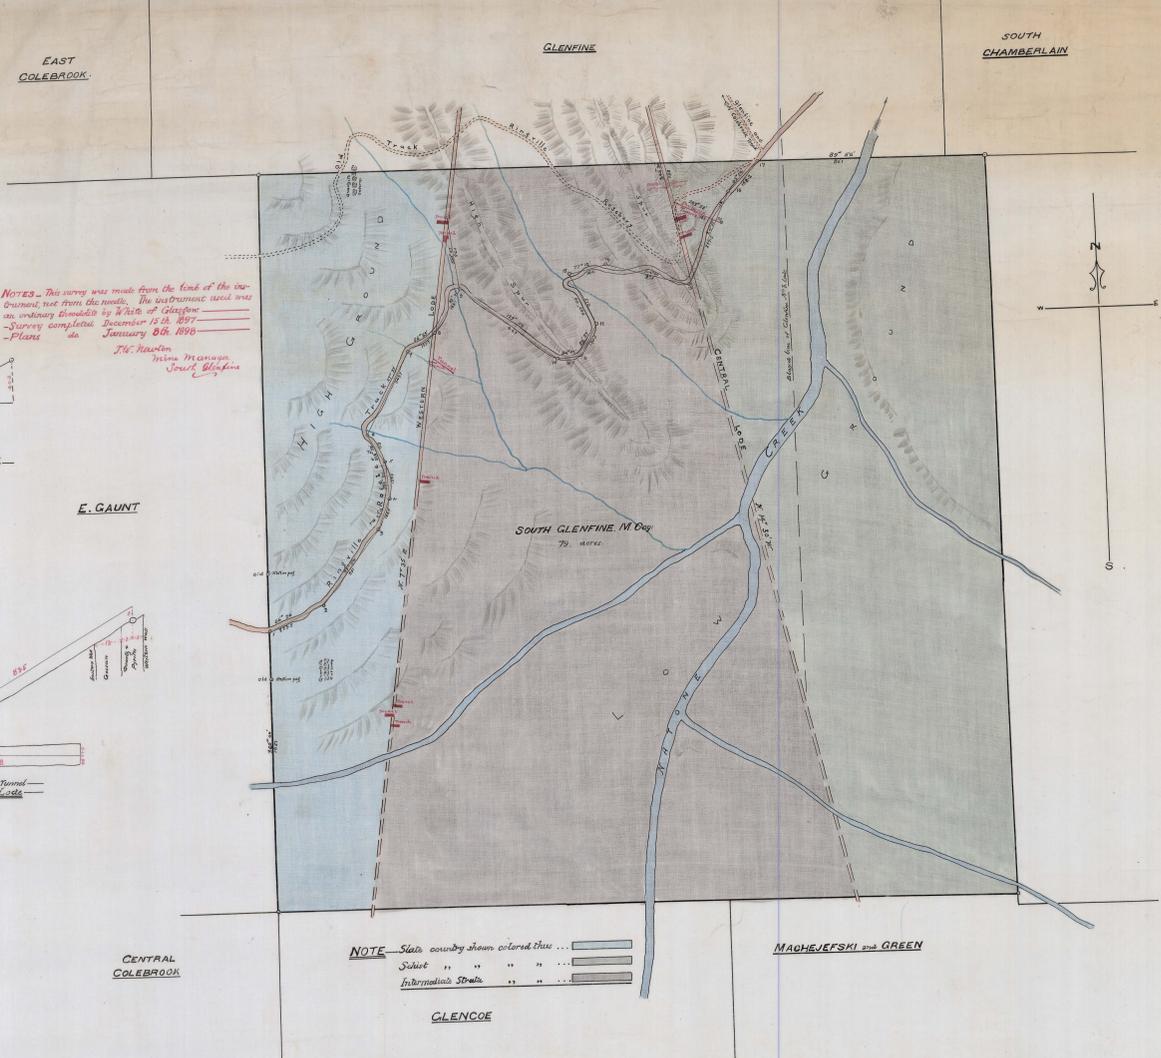


NOTES - This survey was made from the tomb of the old
 monument, west from the tomb. The eastward trend was
 an ordinary lode, by W. side of Glenfine
 - Survey completed December 15th 1897
 - Plans do January 26th 1898
 J.W. Stewart
 Mining Manager
 South Glenfine

FIELD NOTES

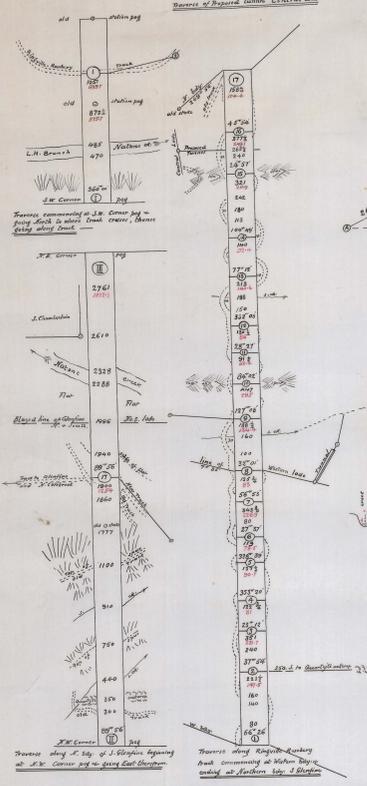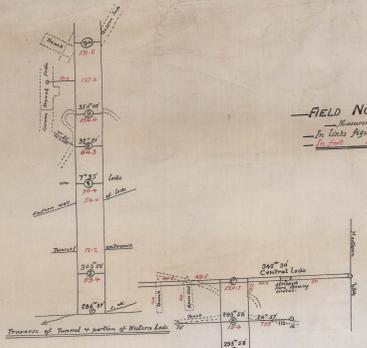

DETAILS ENLARGED

Scale - 25 feet to an inch

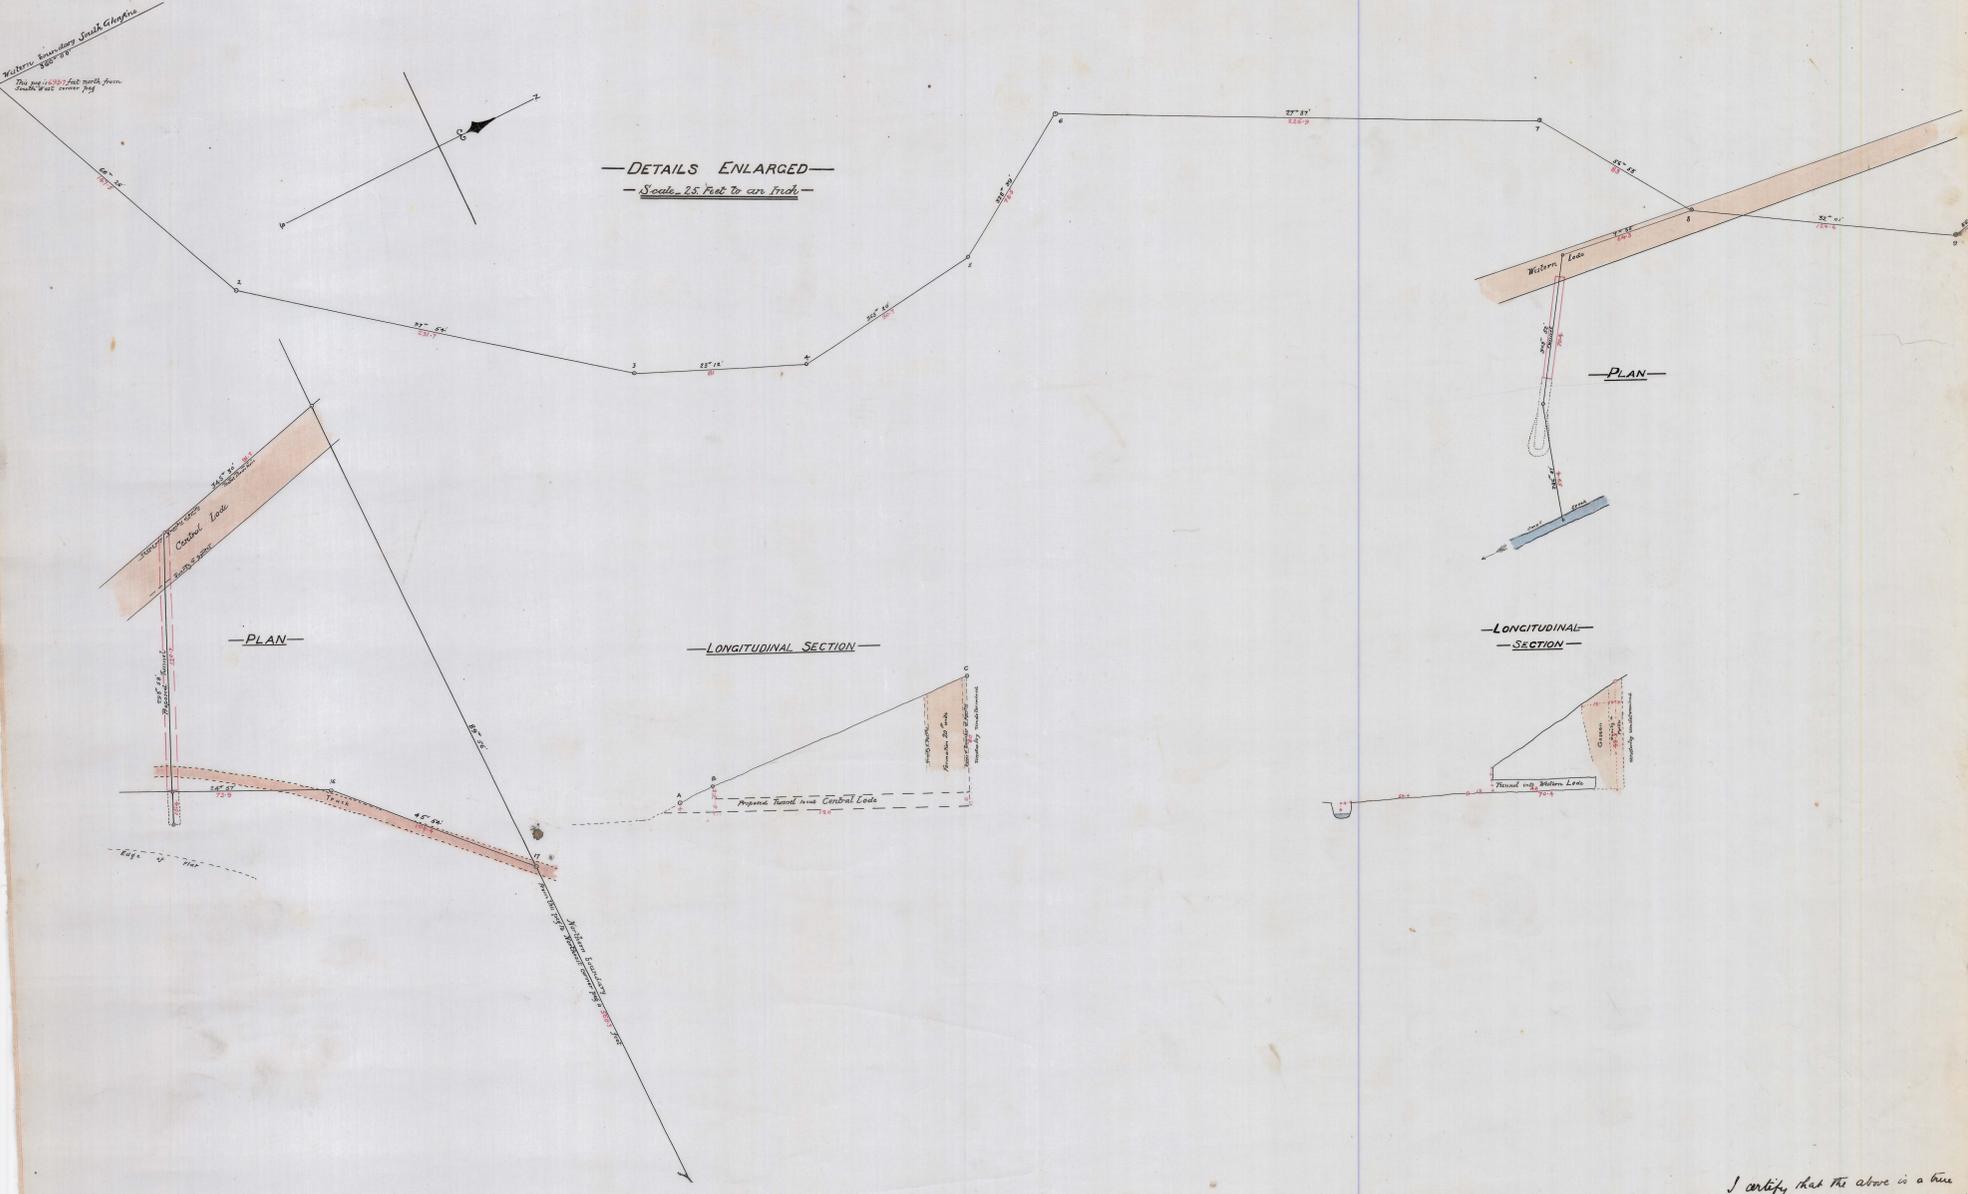

I certify that the above is a true
 copy of the original plans & field
 notes.
 J.W. Stewart
 Mining Manager
 South Glenfine
 8/1/98