







TASMANIAN SILVER MINE

PLAN

SHEWING THE WORKINGS

ON

NO 2 LODE

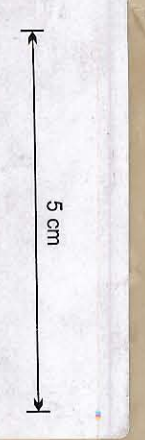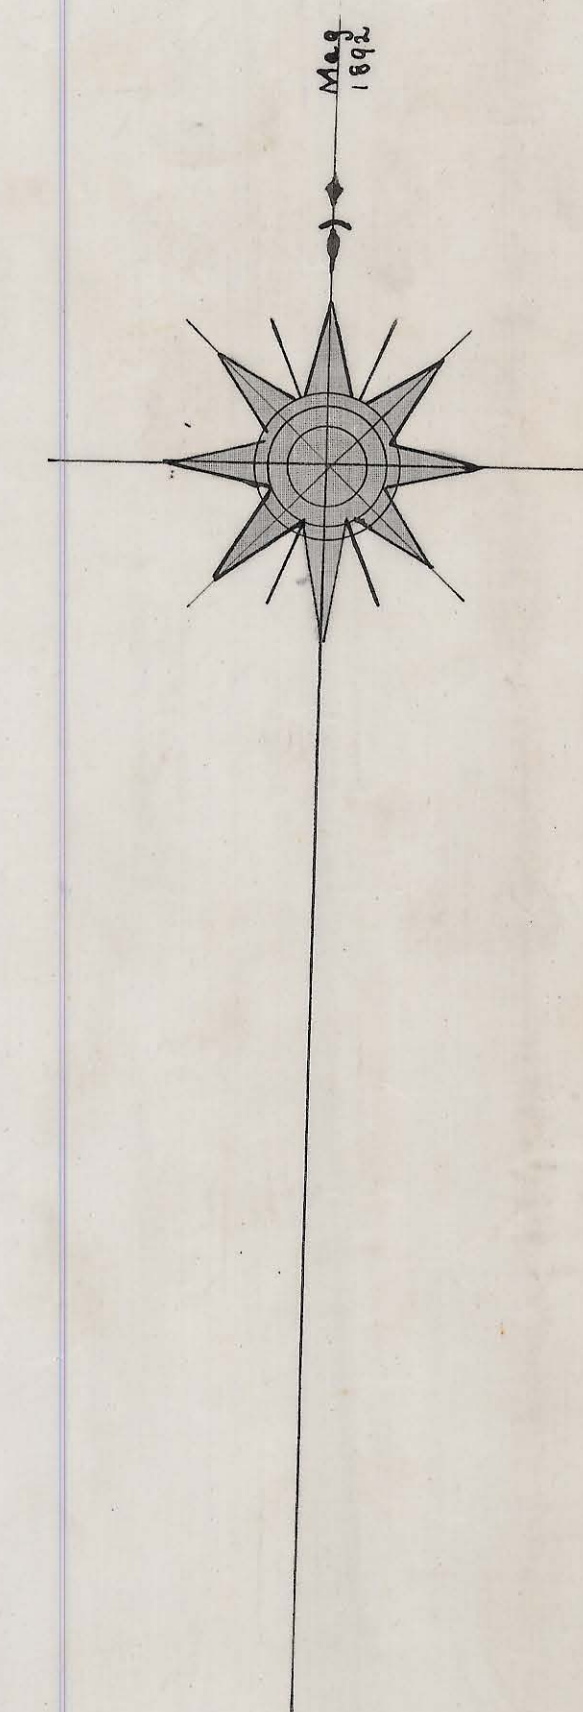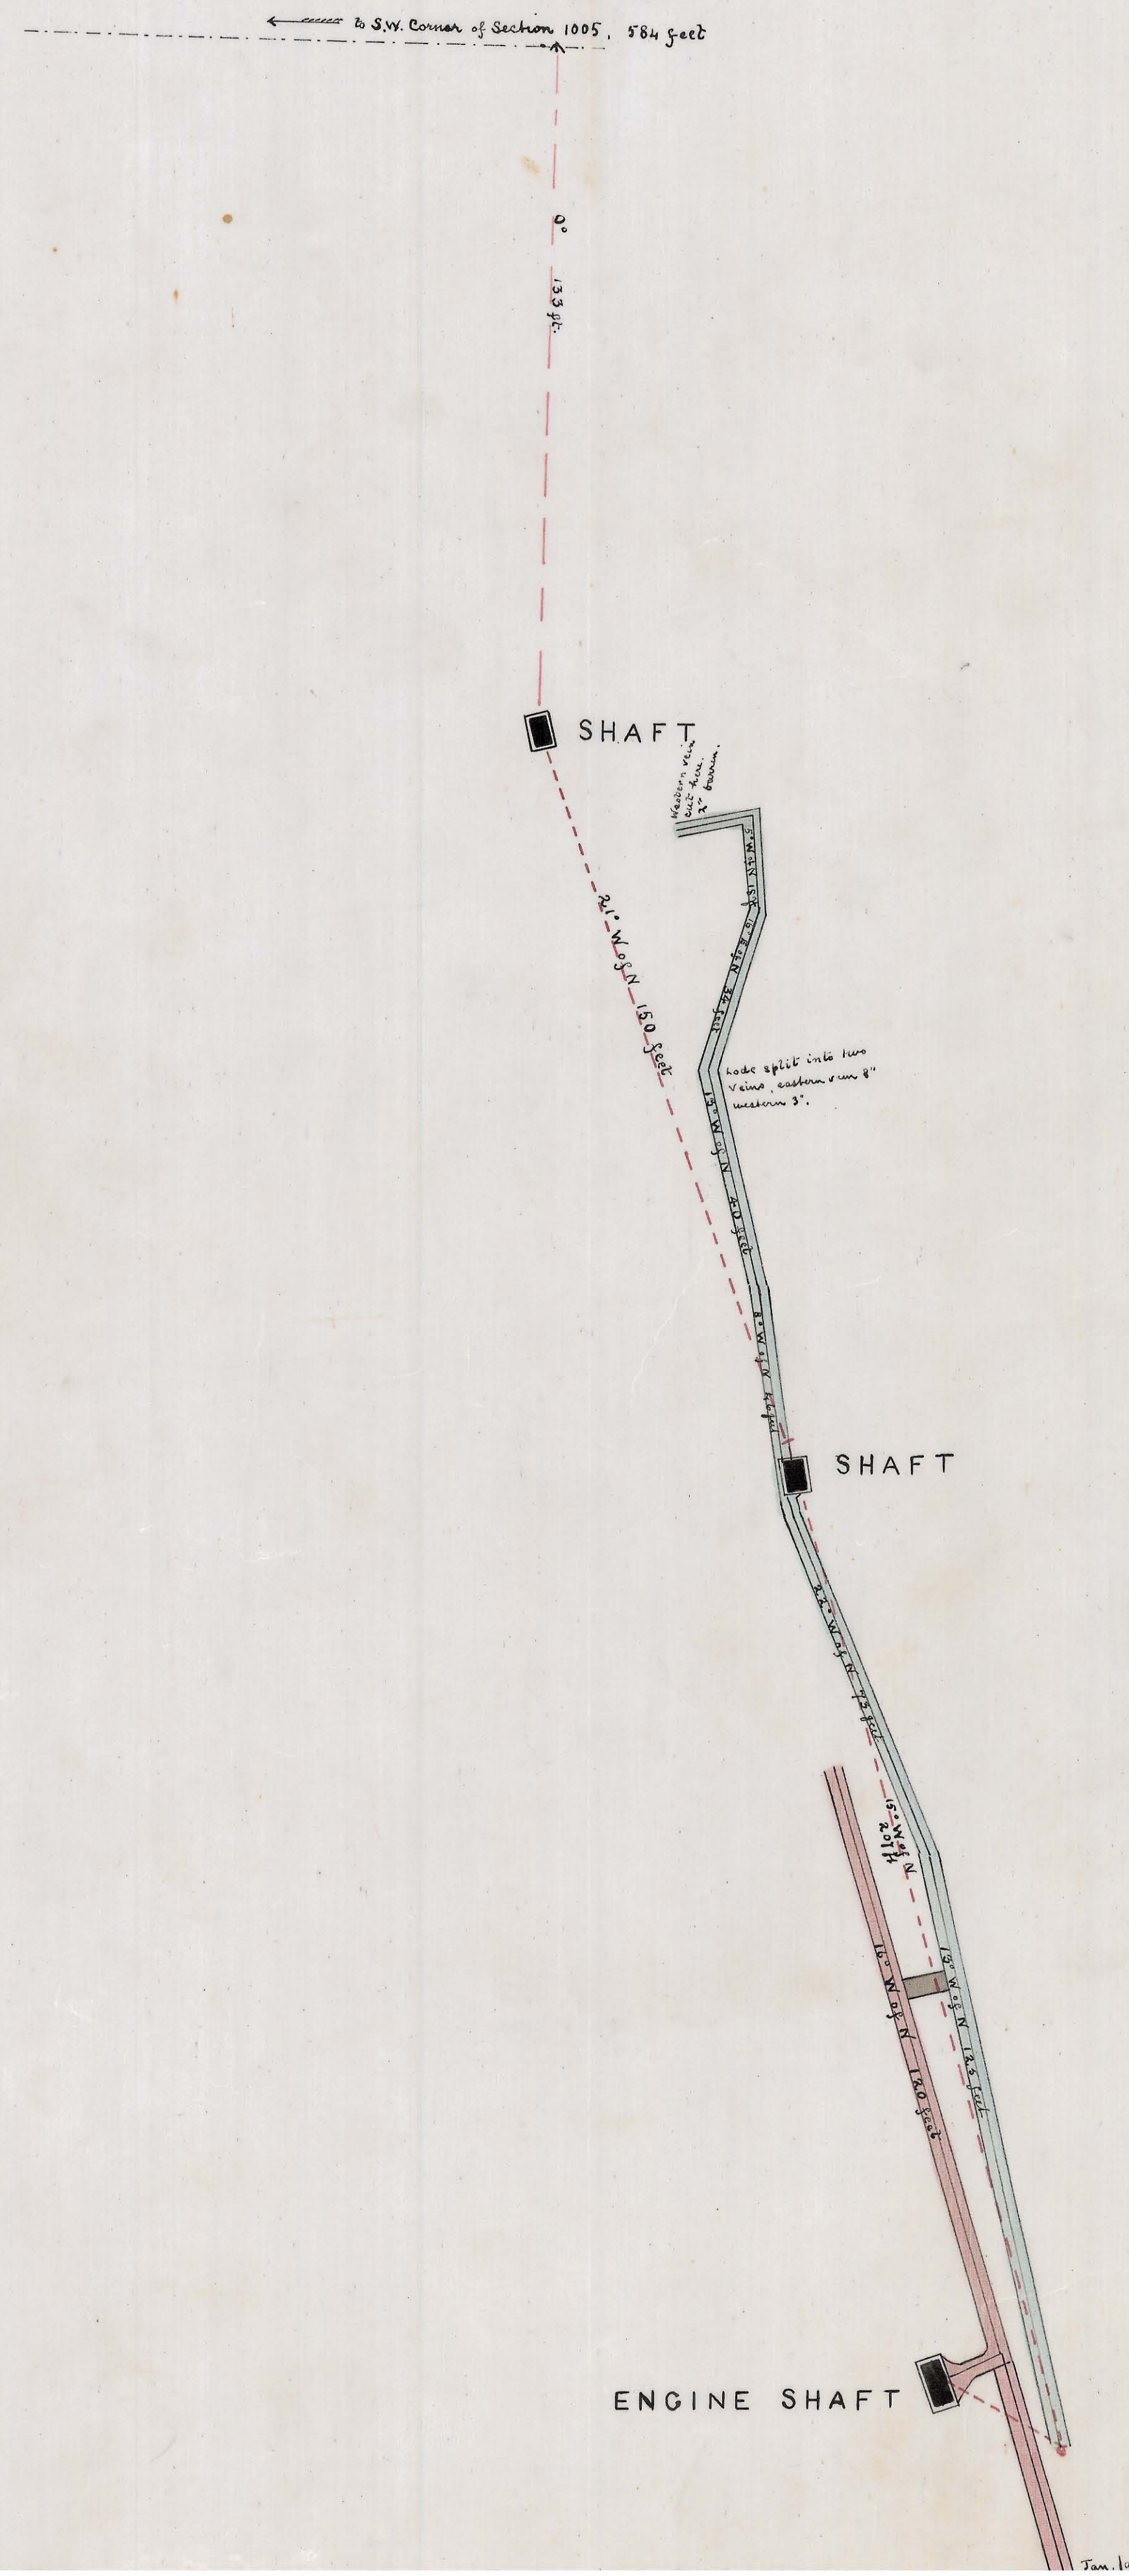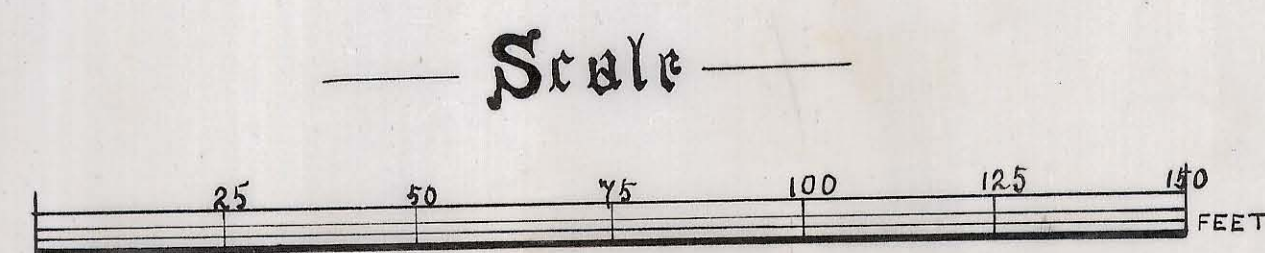

329
c1