

16/2/94
INSPECTOR OF MINES OFFICE
LAUNCESTON


5m

TASMANIAN SILVER MINE

SECTION

of the

MAIN LODE

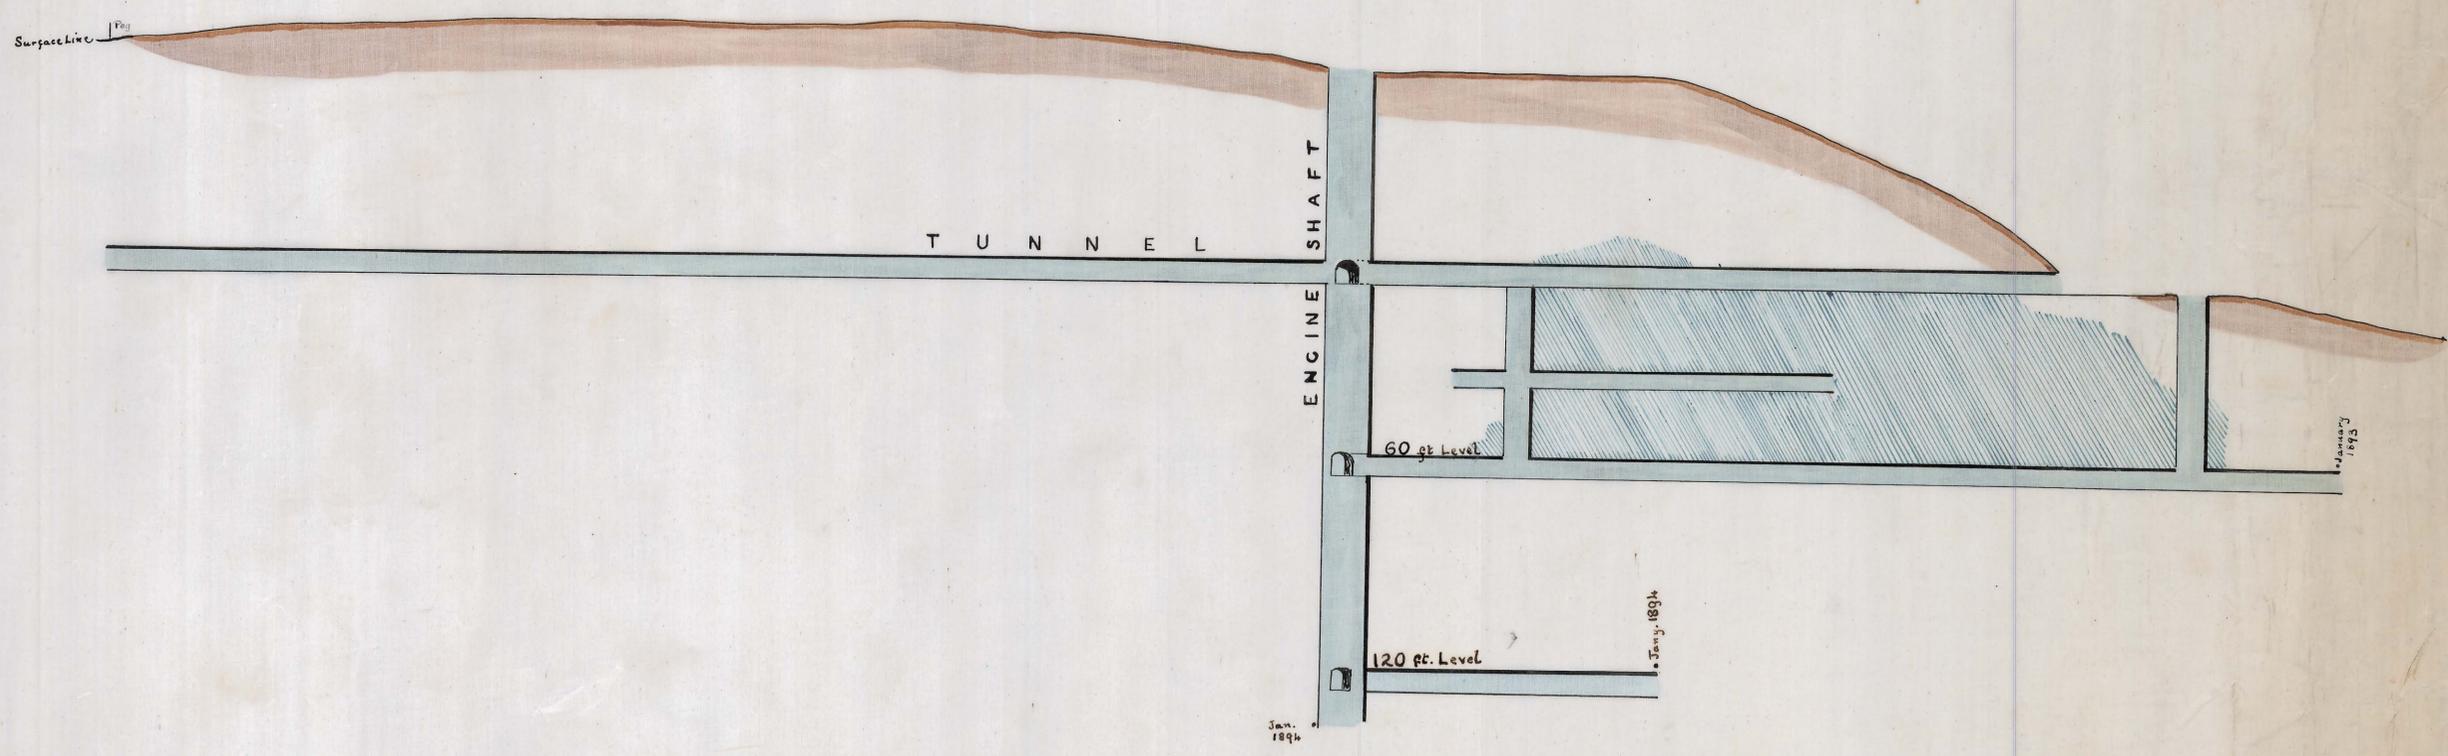

329
02

Scale of Feet