




# TASMANIAN SILVER MINE PLAN


SHEWING THE WORKINGS  
ON  
MAIN LODE

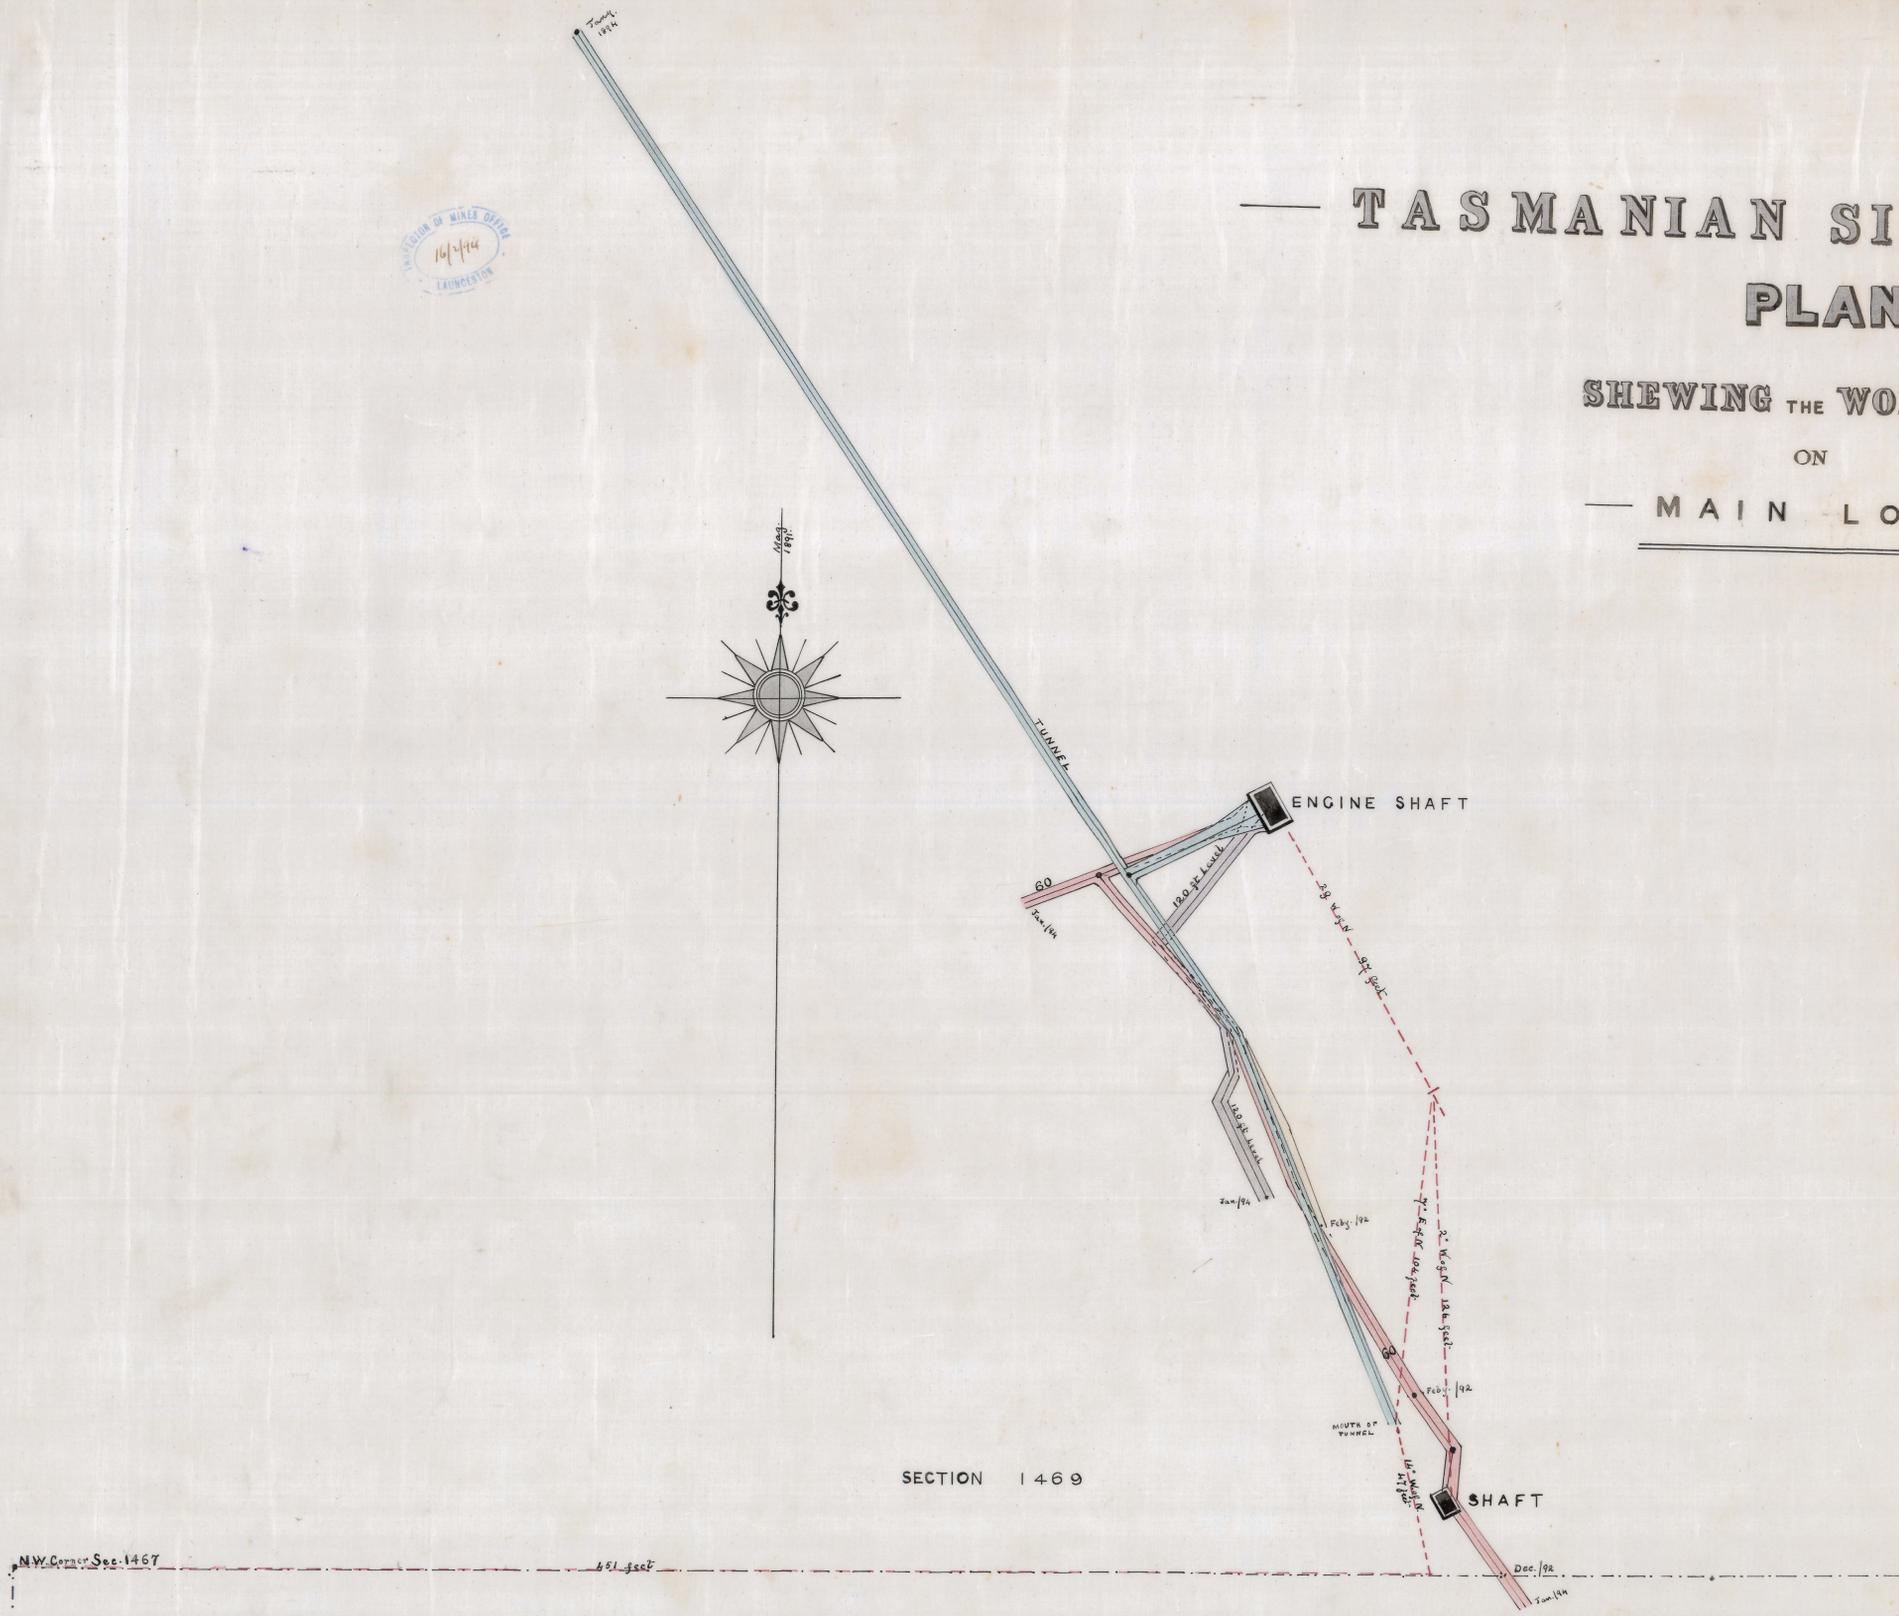

SECTION 1469

SECTION 1467

Scale

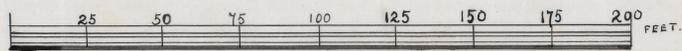

Richard Prouis  
1893.  
Captured 5 January 1894