


5 cm

No 2 Level No 2 Sode North

No 2 Level

2 MAY 1993

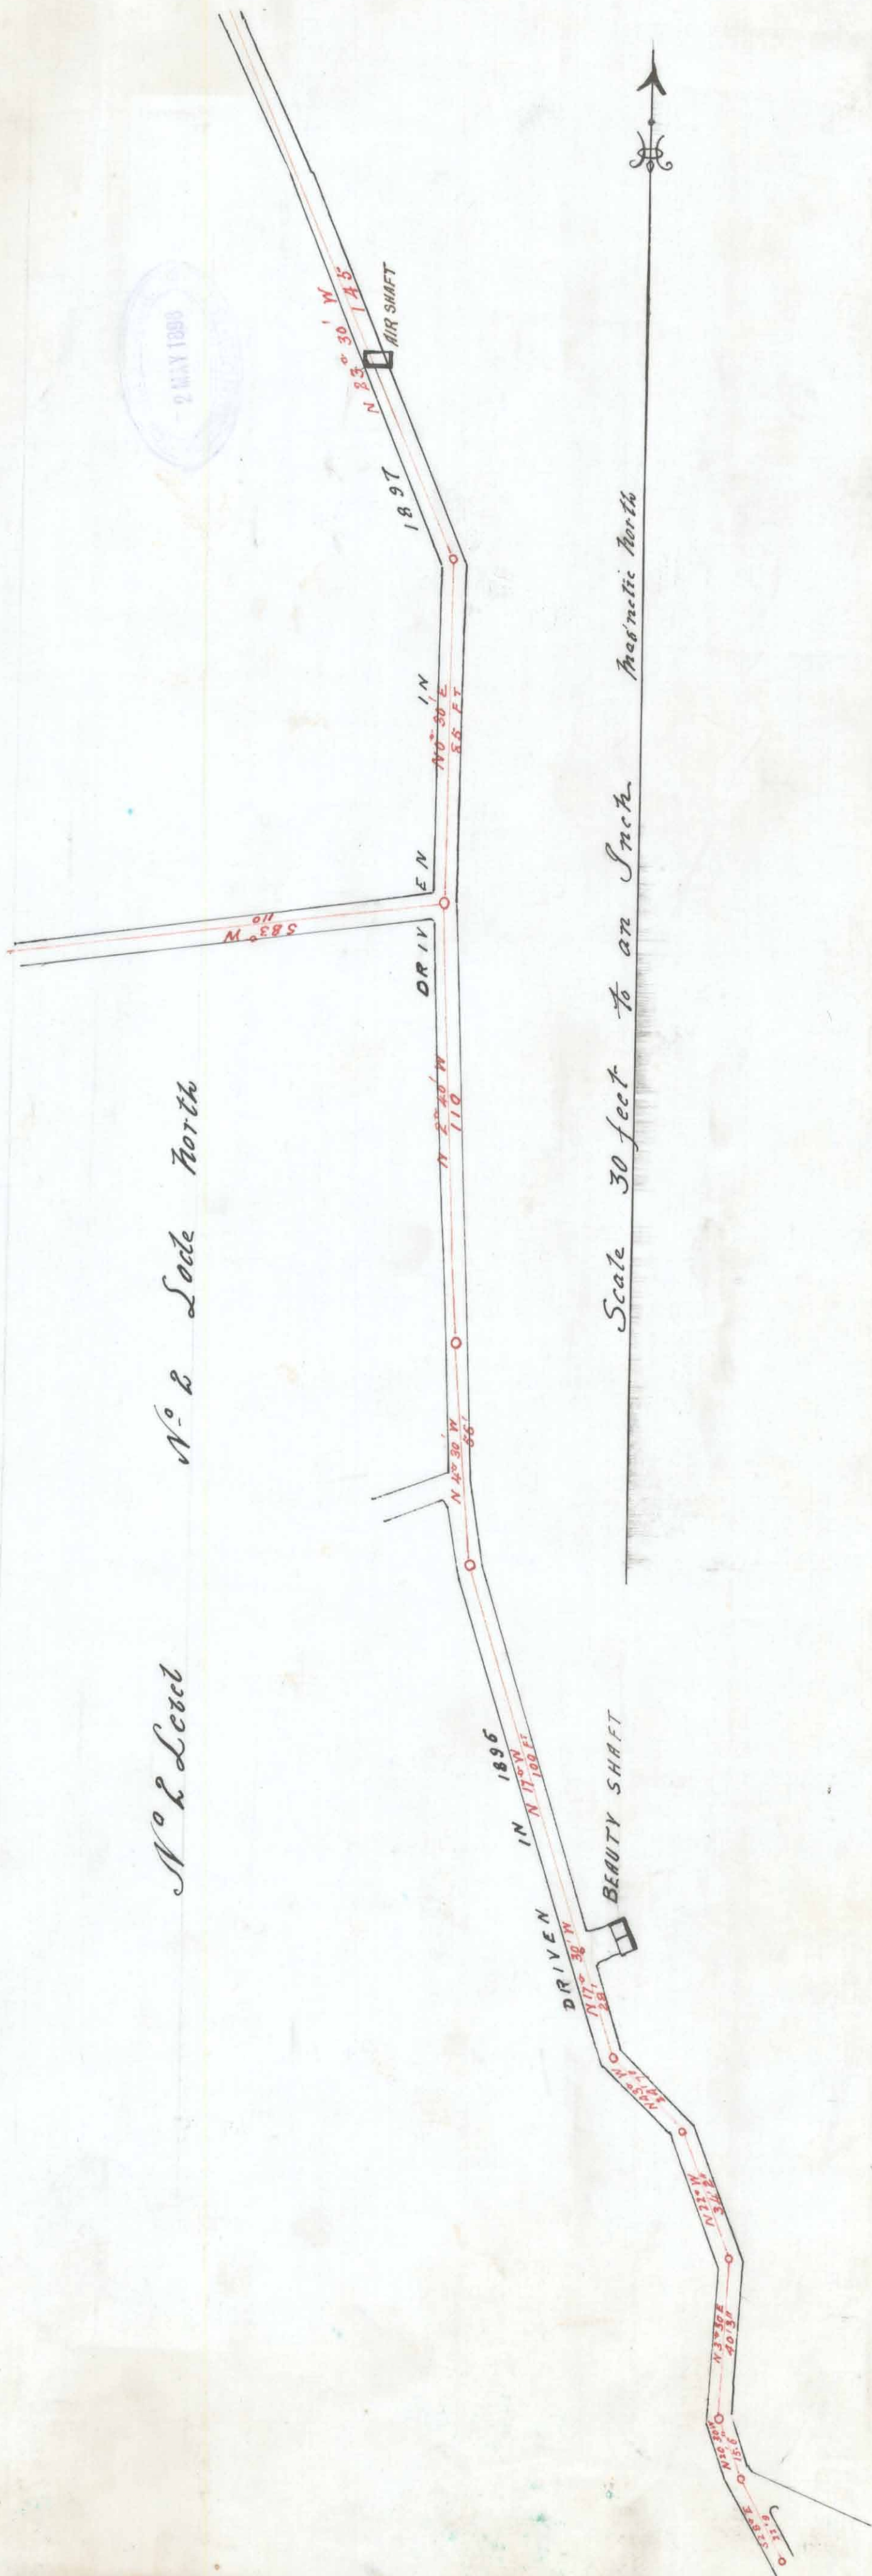

Scale 30 feet to an Inch Magnetic North