




WESTERN SILVER MINE  
LONGITUDINAL SECTION



Scale  
Sturdy feet to an inch

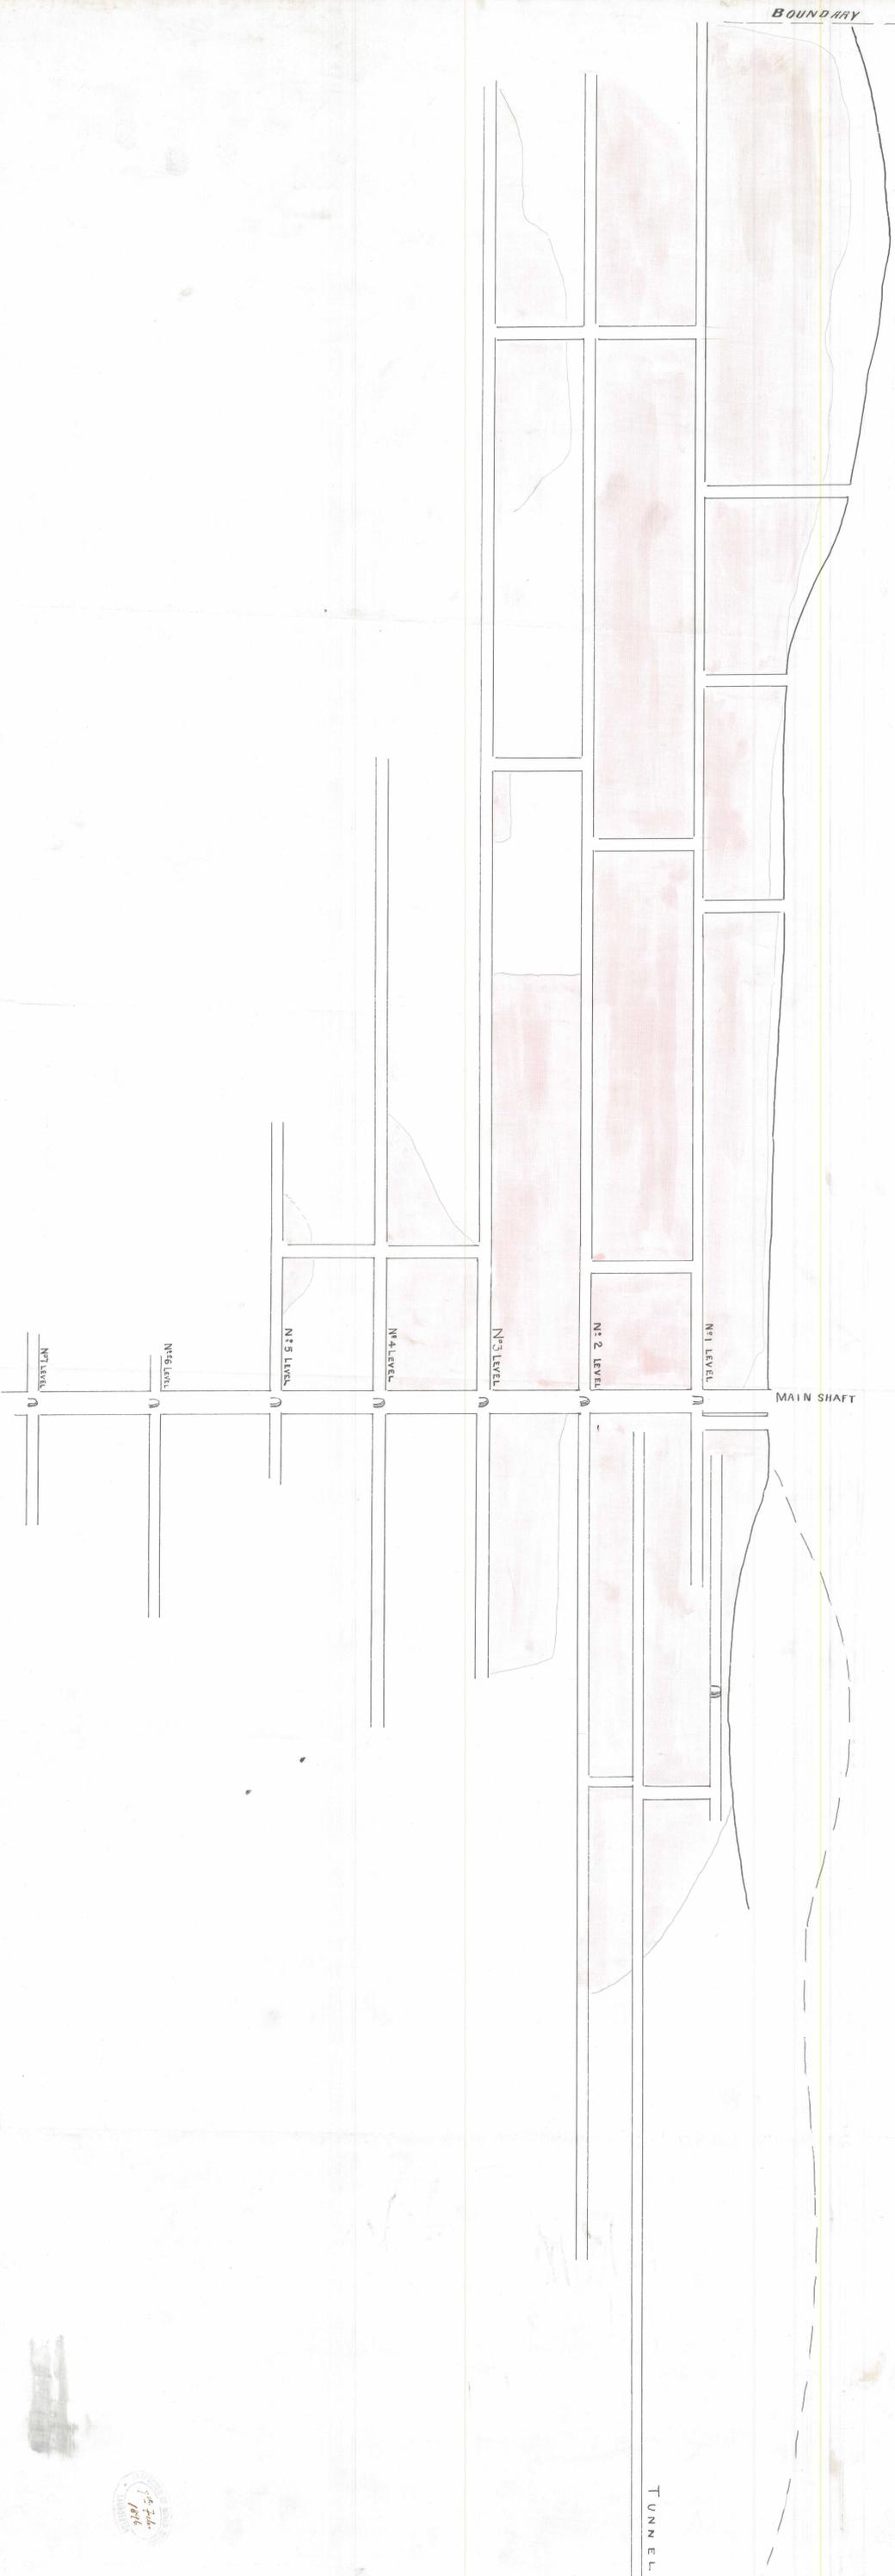