


5 cm

WESTERN S.M.C.

Magnetic North

22

Scale 30 Feet to an Inch

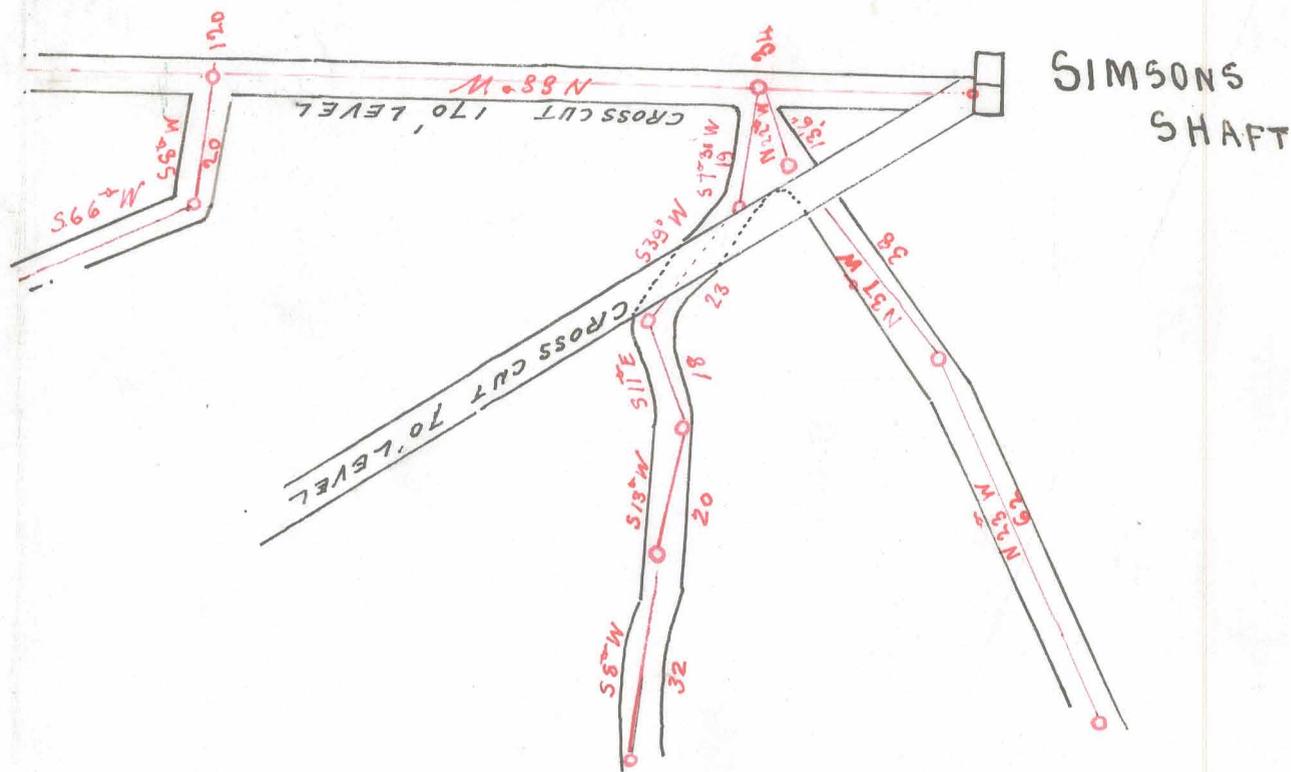

NE CORNER SECTION 755 / 57M

50